



# 755 Shotgun Road

Sunrise, FL 33326

Colliers

**3,375 SF | As-Built Layout**

## Dimensions:

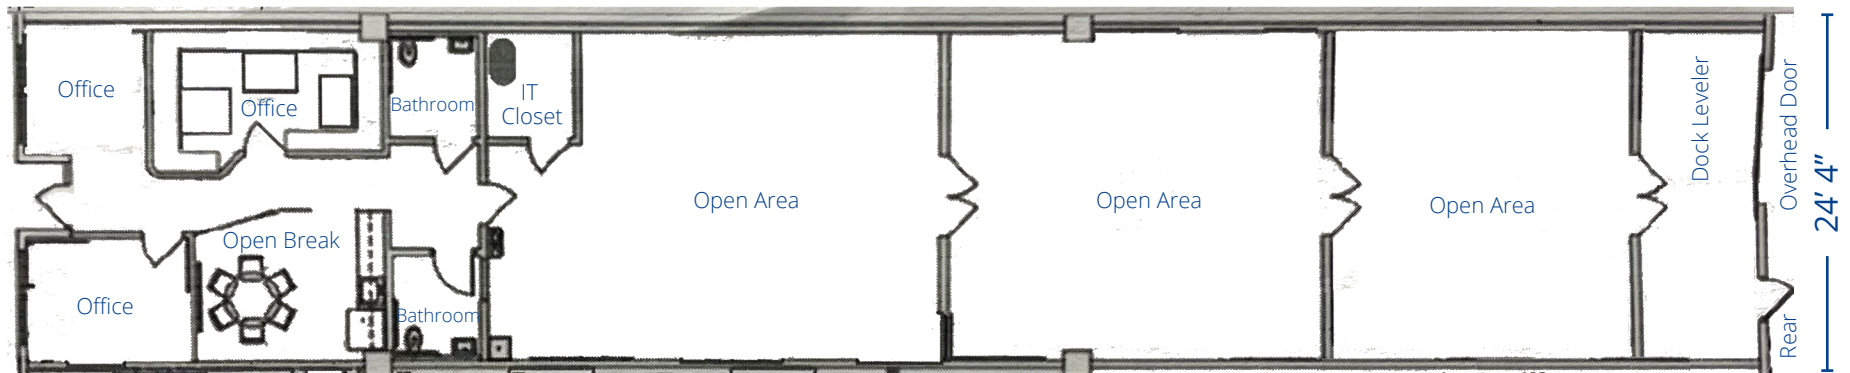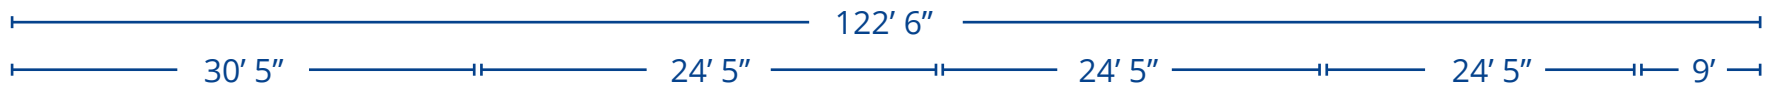

## Ceiling Height:



Contact us:

**Alfie Hamilton**

+1 954 652 4615

alfie.hamilton@colliers.com

All information is furnished from sources deemed reliable. No warranty or representation is made as to the accuracy thereof and it is submitted subject to errors, omissions, change of price, rental or other conditions, prior sale, lease, financing or withdrawal without notice.