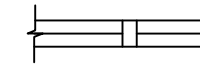
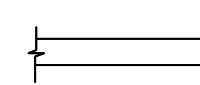


WALL LEGEND:


-  EXISTING STOREFRONT GLASS.
-  EXISTING INTERIOR PARTITION

WALL & SYMBOL LEGEND

SCALE: NTS 1

NOT USED

SCALE: NTS 2

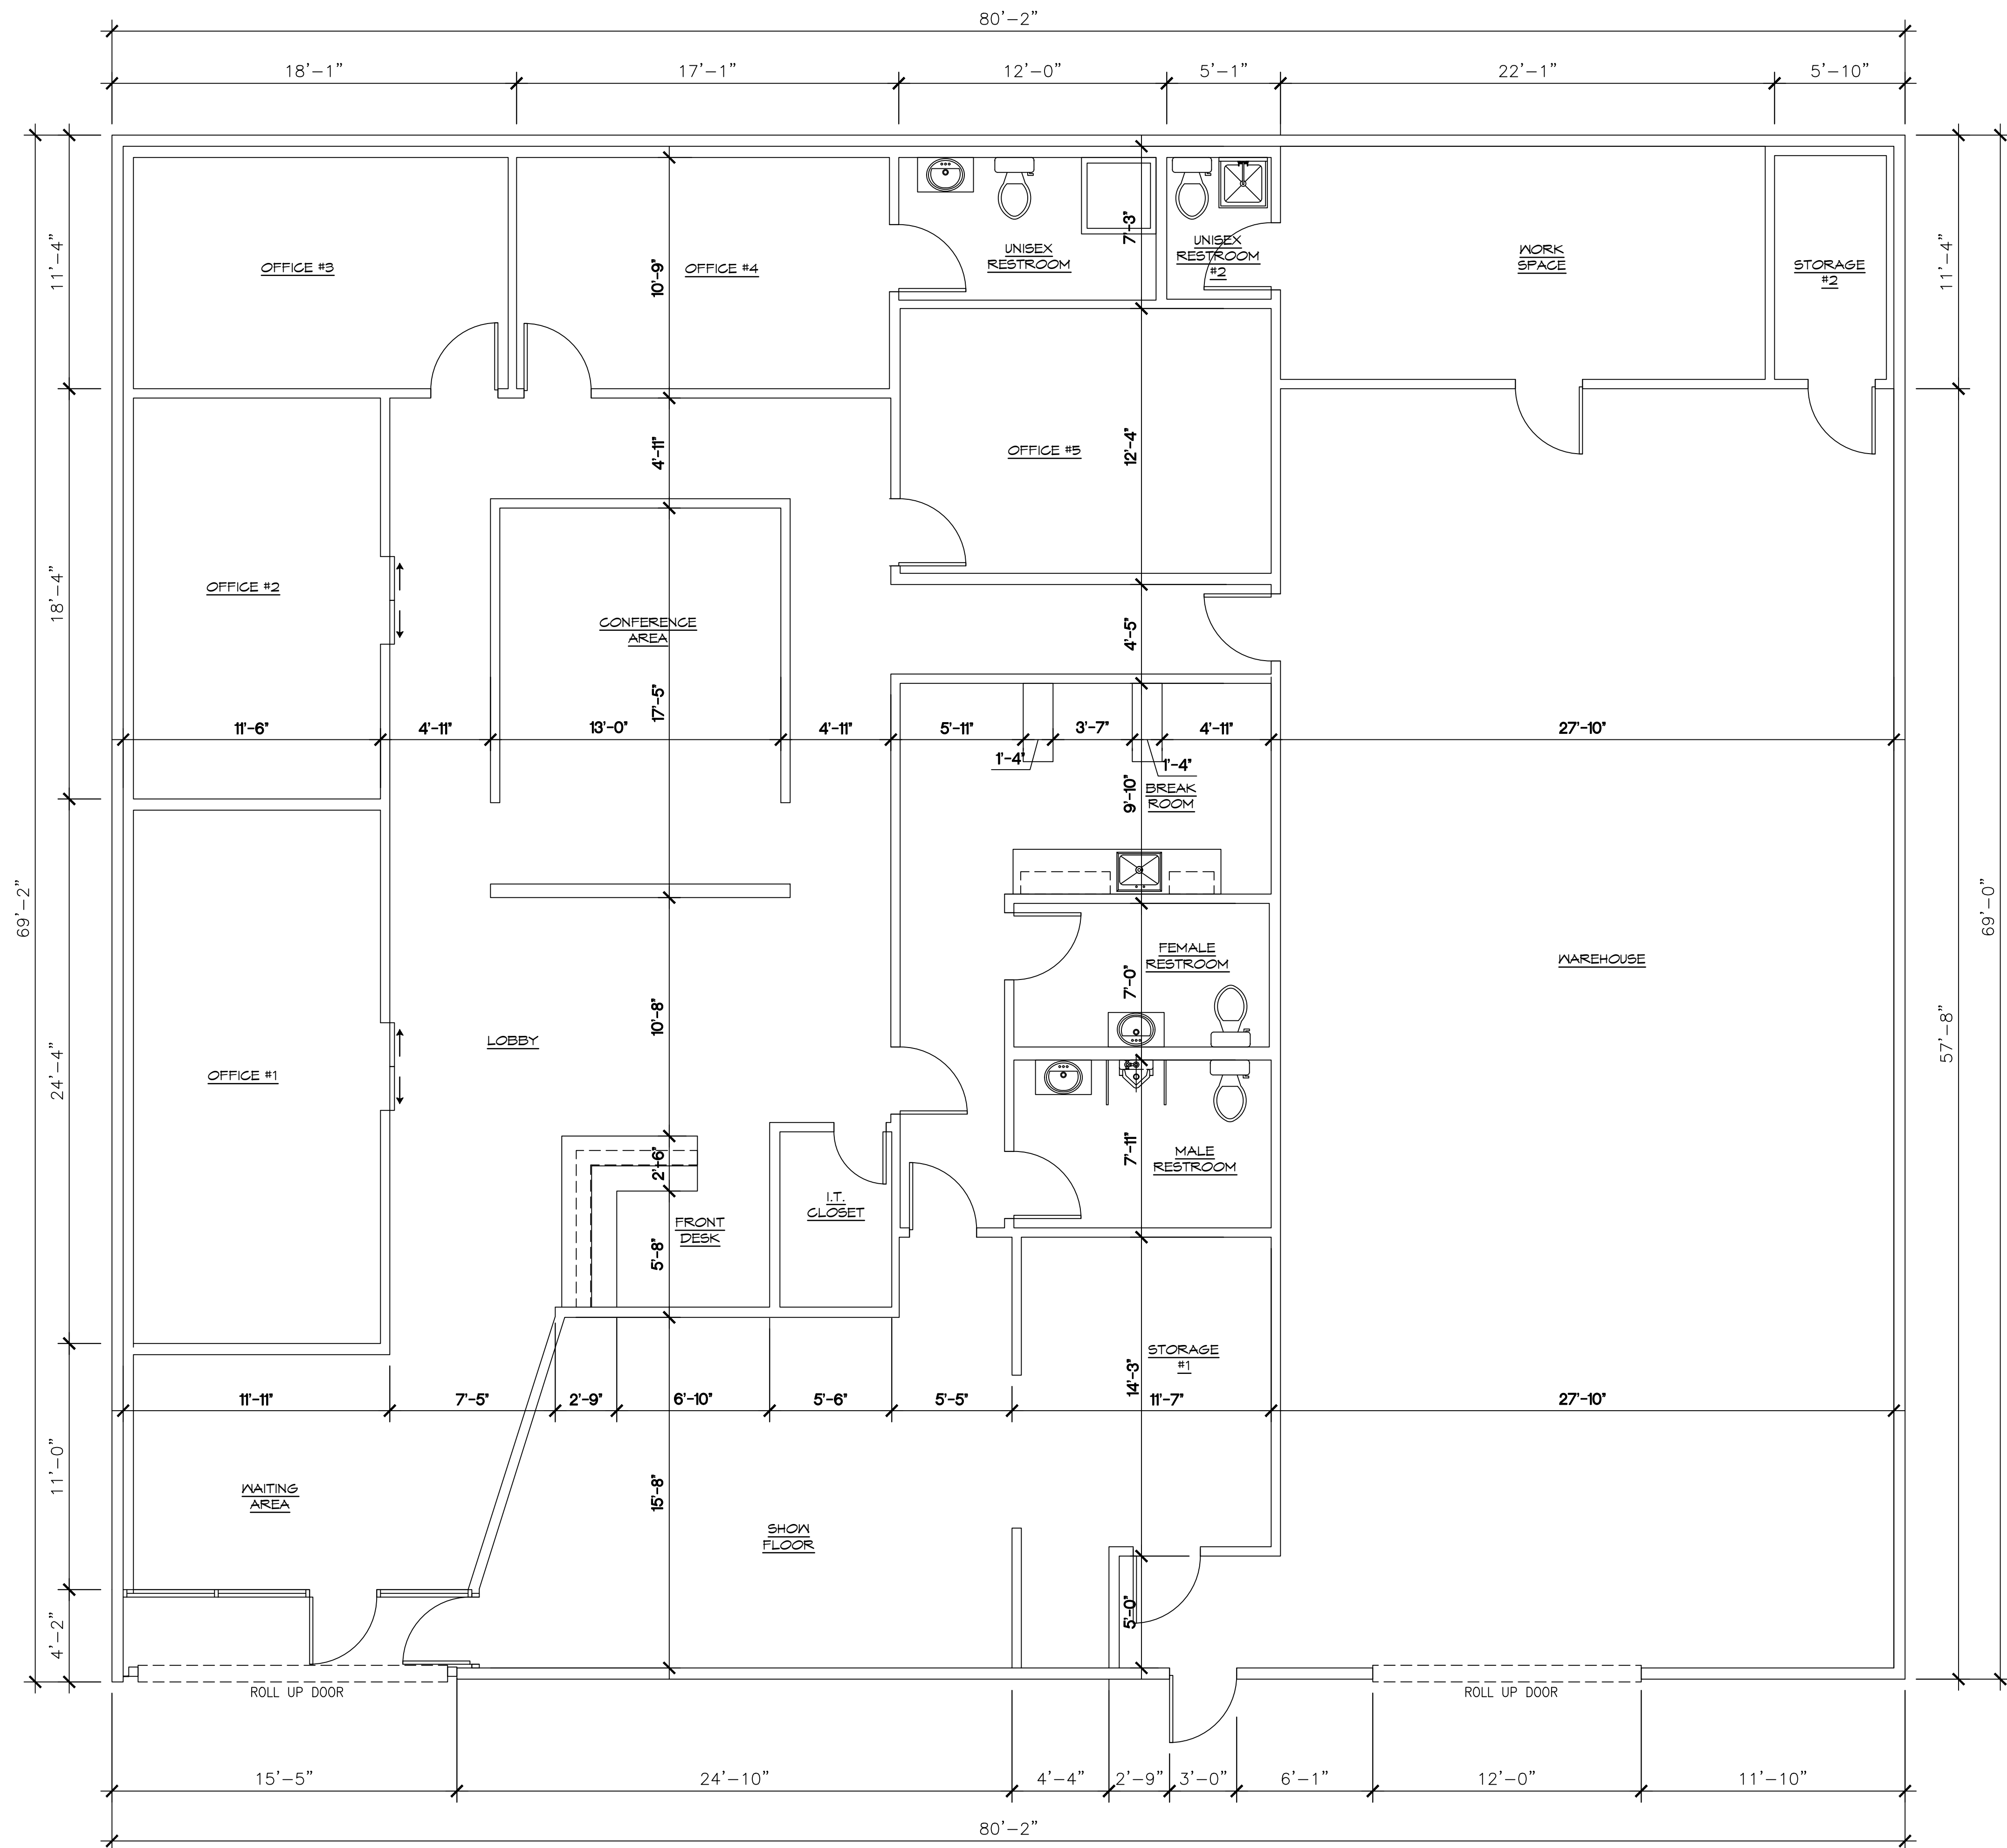

AS-BUILT FLOOR PLAN

SCALE: 1/4" = 1'-0" 3

DRAWING ISSUED FOR:

REVISIONS	DATE:	DESCRIPTION:
▲		
▲		
▲		
▲		

DATE: 08/29/2024
DRAWN BY: C.R. & K.B. & C.B.
CHECKED BY: A.V.
PROJECT: A.V.
FILE NO:

SHEET TITLE:

AS-BUILT FLOOR PLAN

SHEET NO:

A-1.0