




REVISION  
--

PROJECT  
--

AS-BUILT FLOOR PLAN  
FIFTH FLOOR  
FIRST CAMPBELL SQUARE  
210 FIRST STREET SW, ROANOKE, VIRGINIA

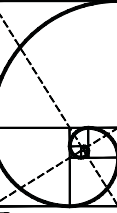


**Degen Architects**  
Post Office Box 20183  
Roanoke VA 24018-0019  
Telephone 540/772-0800  
degenarchitects@aol.com

DRAWING  
AS-BUILT PLAN

DATE  
05 SEPTEMBER 2011

SHEET NUMBER:  
A105

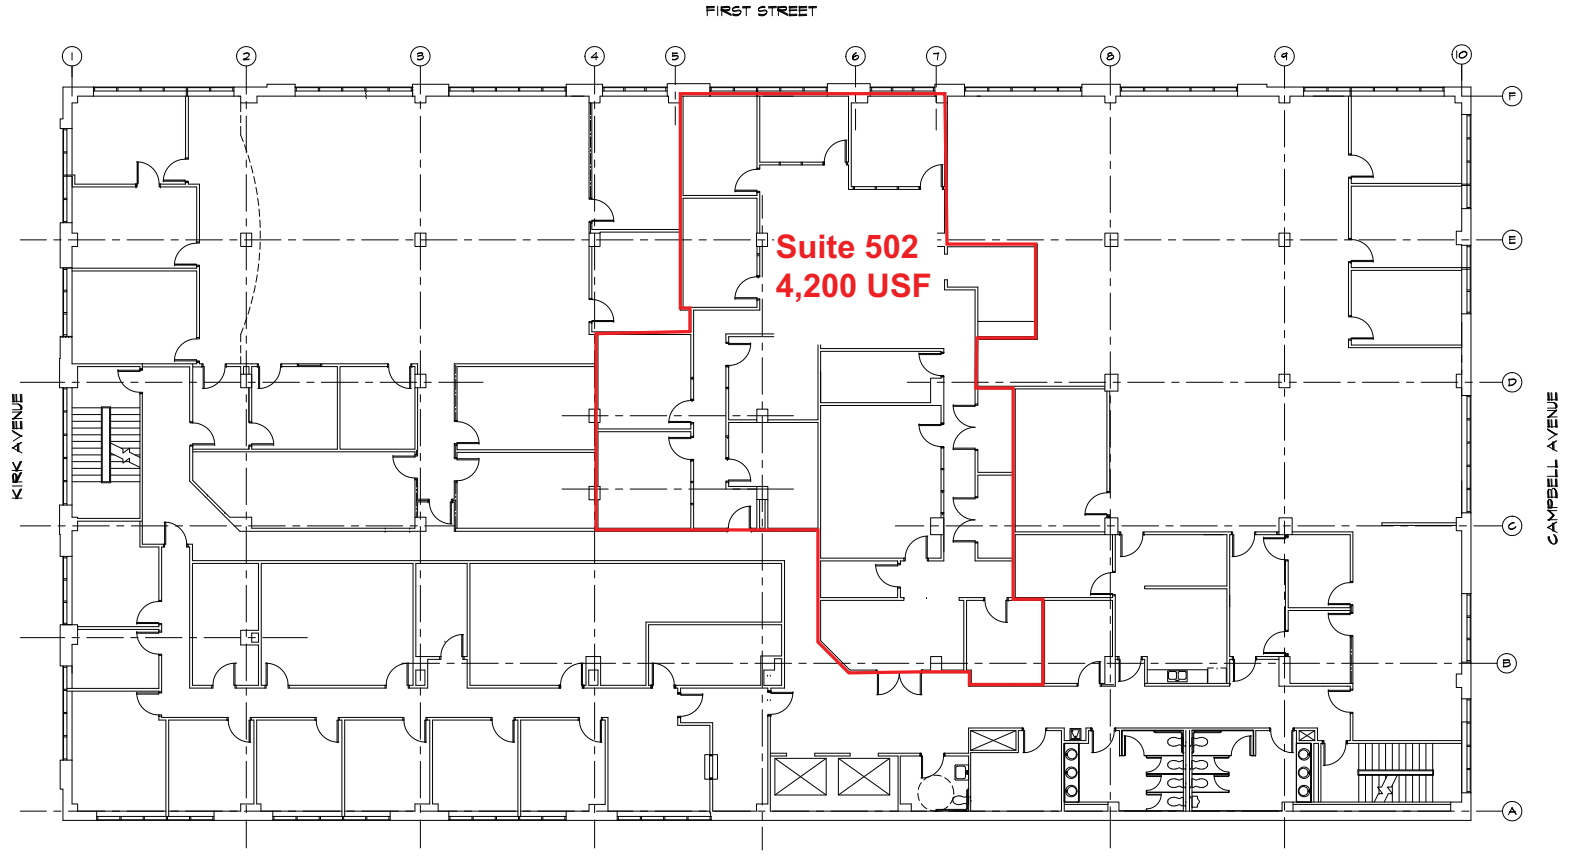

**FIFTH FLOOR PLAN**  
SCALE: 1/8" = 1'-0"