

BASEMENT PLAN

SUSSEX STREET


73 SUSSEX STREET
4 FAMILY BUILDING
JERSEY CITY, NJ 07305

BASEMENT PLAN
AS BUILT

PROJ. #2024-09 AS BUILT PLANS

A1

Rev
DATE: 4-18-24

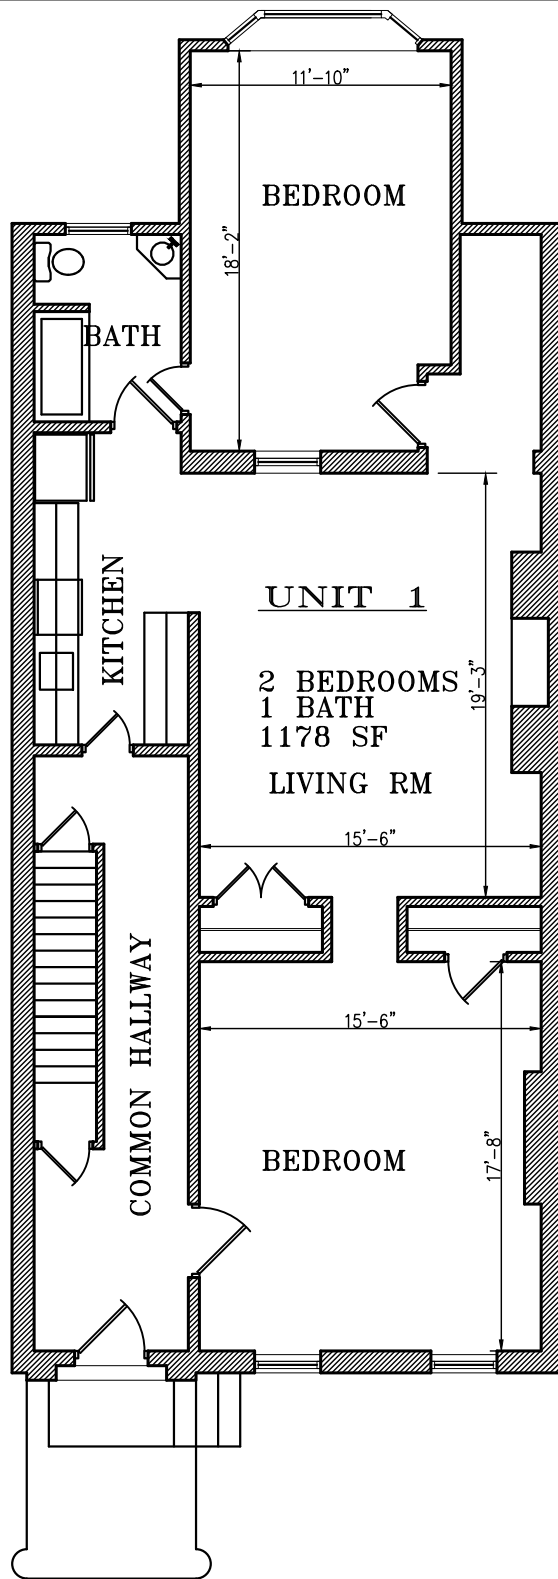


GROUND FLOOR PLAN
 GROSS 1418 SF
 SUSSEX STREET

73 SUSSEX STREET
 4 FAMILY BUILDING
 JERSEY CITY, NJ 07305

GROUND FLOOR
 AS BUILT
 PROJ. #2024-09 AS BUILT PLANS

A2
 Rev
 DATE: 4-18-24

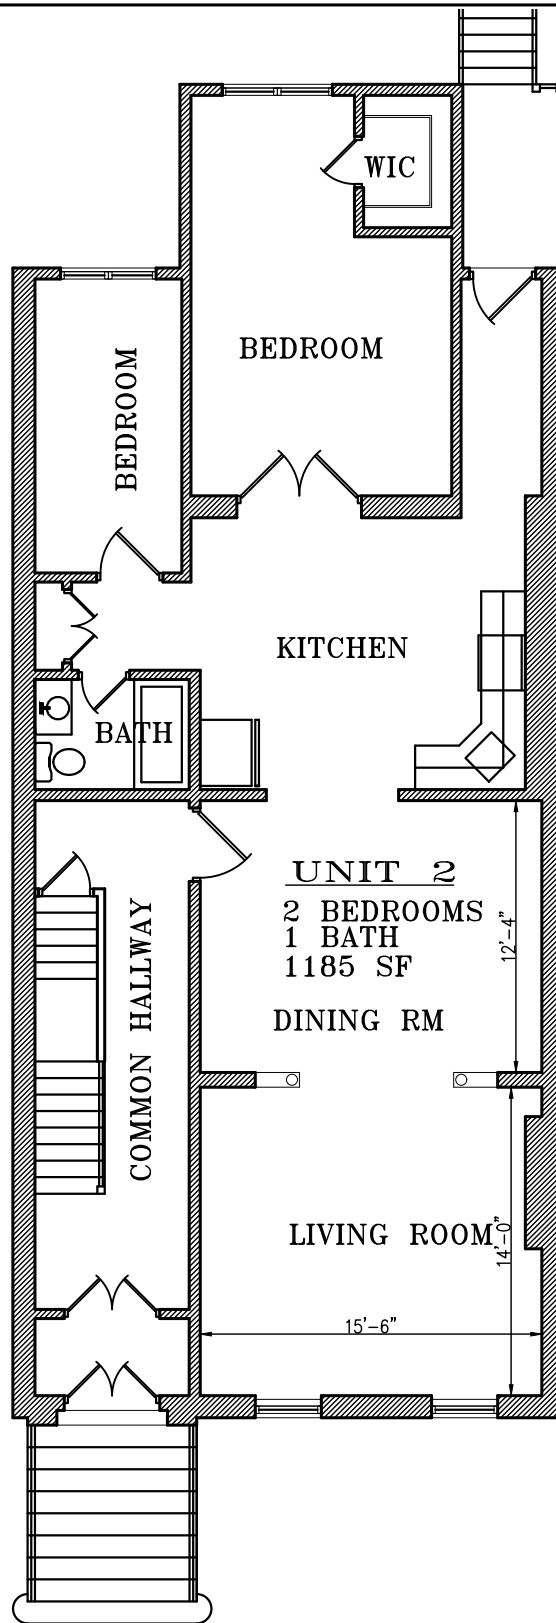


FIRST FLOOR PLAN
 GROSS 1411 SF
 SUSSEX STREET

73 SUSSEX STREET
 4 FAMILY BUILDING
 JERSEY CITY, NJ 07305

FIRST FLOOR
 AS BUILT
 PROJ. #2024-09 AS BUILT PLANS

A3
 Rev
 DATE: 4-18-24

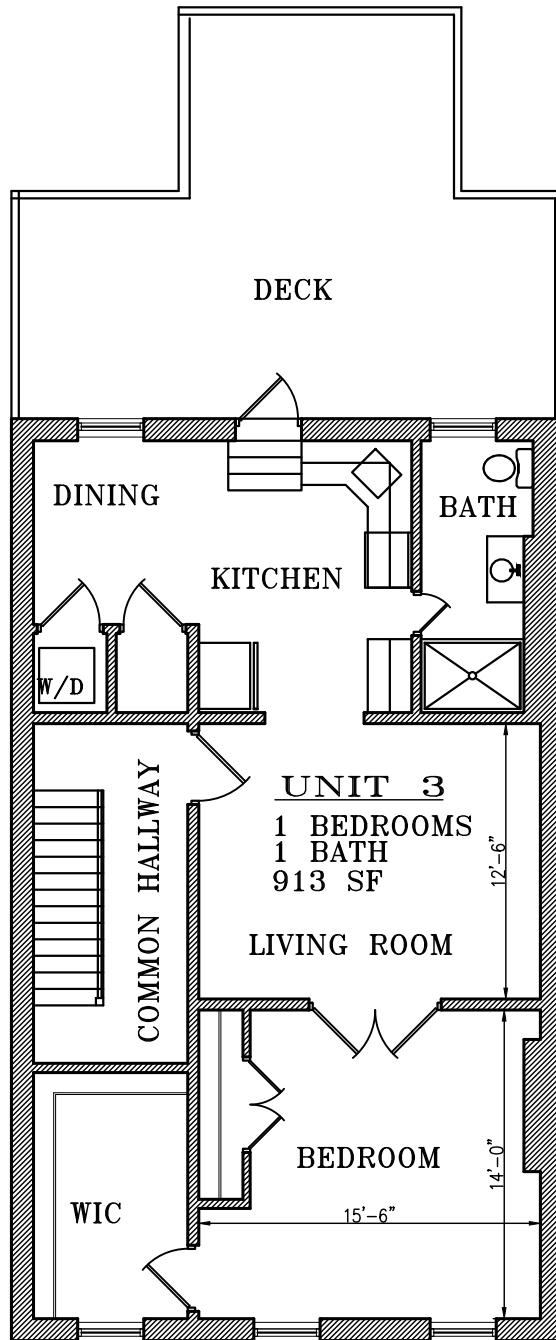

SECOND FLOOR PLAN
 GROSS 1045 SF
 SUSSEX STREET


73 SUSSEX STREET
 4 FAMILY BUILDING
 JERSEY CITY, NJ 07305

SECOND FLOOR
 AS BUILT

PROJ. #2024-09 AS BUILT PLANS

A4

Rev
 DATE: 4-18-24

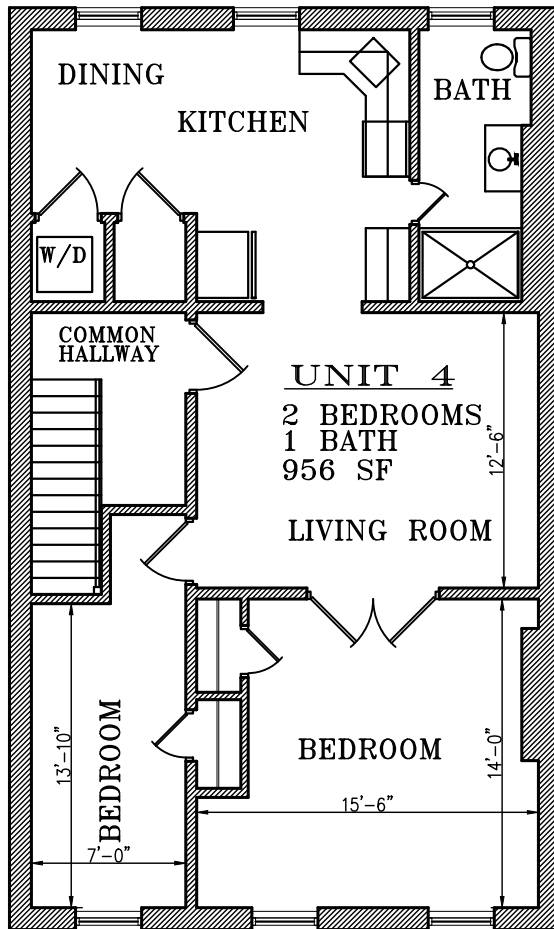

THIRD FLOOR PLAN
 GROSS 1045 SF
 SUSSEX STREET

73 SUSSEX STREET
 4 FAMILY BUILDING
 JERSEY CITY, NJ 07305

THIRD FLOOR
 AS BUILT

PROJ. #2024-09 AS BUILT PLANS

A5

Rev
 DATE: 4-18-24