

Sheet Index	
AS Built	
.1	Cover Sheet and Site Plan
.2	Main Floor Plan
.3	Lower Floor Plan
.4	Generic Perspective / MAIN
.5	Generic Perspective / LOWER

PROJECT LOCATION MAP

GENERAL NOTES:
 1. DO NOT USE AS A BLUEPRINTS WITHOUT MR.LLC PERMISSION.
 2. PLEASE NOTE INTERIOR DIMENSIONS WERE NOT USED IN CALCULATING SQUARE FOOTAGE.
 3. SIZE OF HEATED AND NOT HEATED AREA AND OTHER INFORMATION WERE OBTAINED PER THE NC REAL ESTATE COMMISSION GUIDELINES (8" FOR EXTERNAL WALLS EXCEPT CONDOMINIUMS).
 4. FOR REMODELING QUESTIONS OR MORE DETAILED CAD DRAWINGS (INC. SITE PLAN, SECTIONS, ELEVATIONS) ALSO 3D MODEL PLEASE CONTACT ALFRED ZALYS MOB. 828 231 7305 E-MAIL: A.ZALYS@HOTMAIL.COM

Client:

e-mail address
phone number

LEGEND MAP:
 HEATED RESIDEN.FINISHED
 HEATED COMMERC.FINISHED
 NOT HEATED/NOT FINISHED
 OPEN DECK
 COVERED PORCH

Revision History

RevID	Chd	Change Name	Date

Company Title

Company
Measure Rite LLC
 103 Poplar Spring Trail, Hendersonville
 #Contact Country NC 28739

Site Address
44 Church St, Waynesville, NC 28786

Drawing Name
Sheet Index, Site Plan


Drawing Status

Contact Name Alfred ZALYS mob. 828 231 7305	Job No. MR 1256 Date 8/23/2026
Drawing Scale = 1/4" = 1'	Layout ID ANSI B
Layout ID .1	Revisor

SITE PLAN

1. Restaurant Building #44 Church St.
2. Apartment #165 Montgomery st.
3. Parking
4. Neighbouring Build.

Site Plan
 1" = 30'

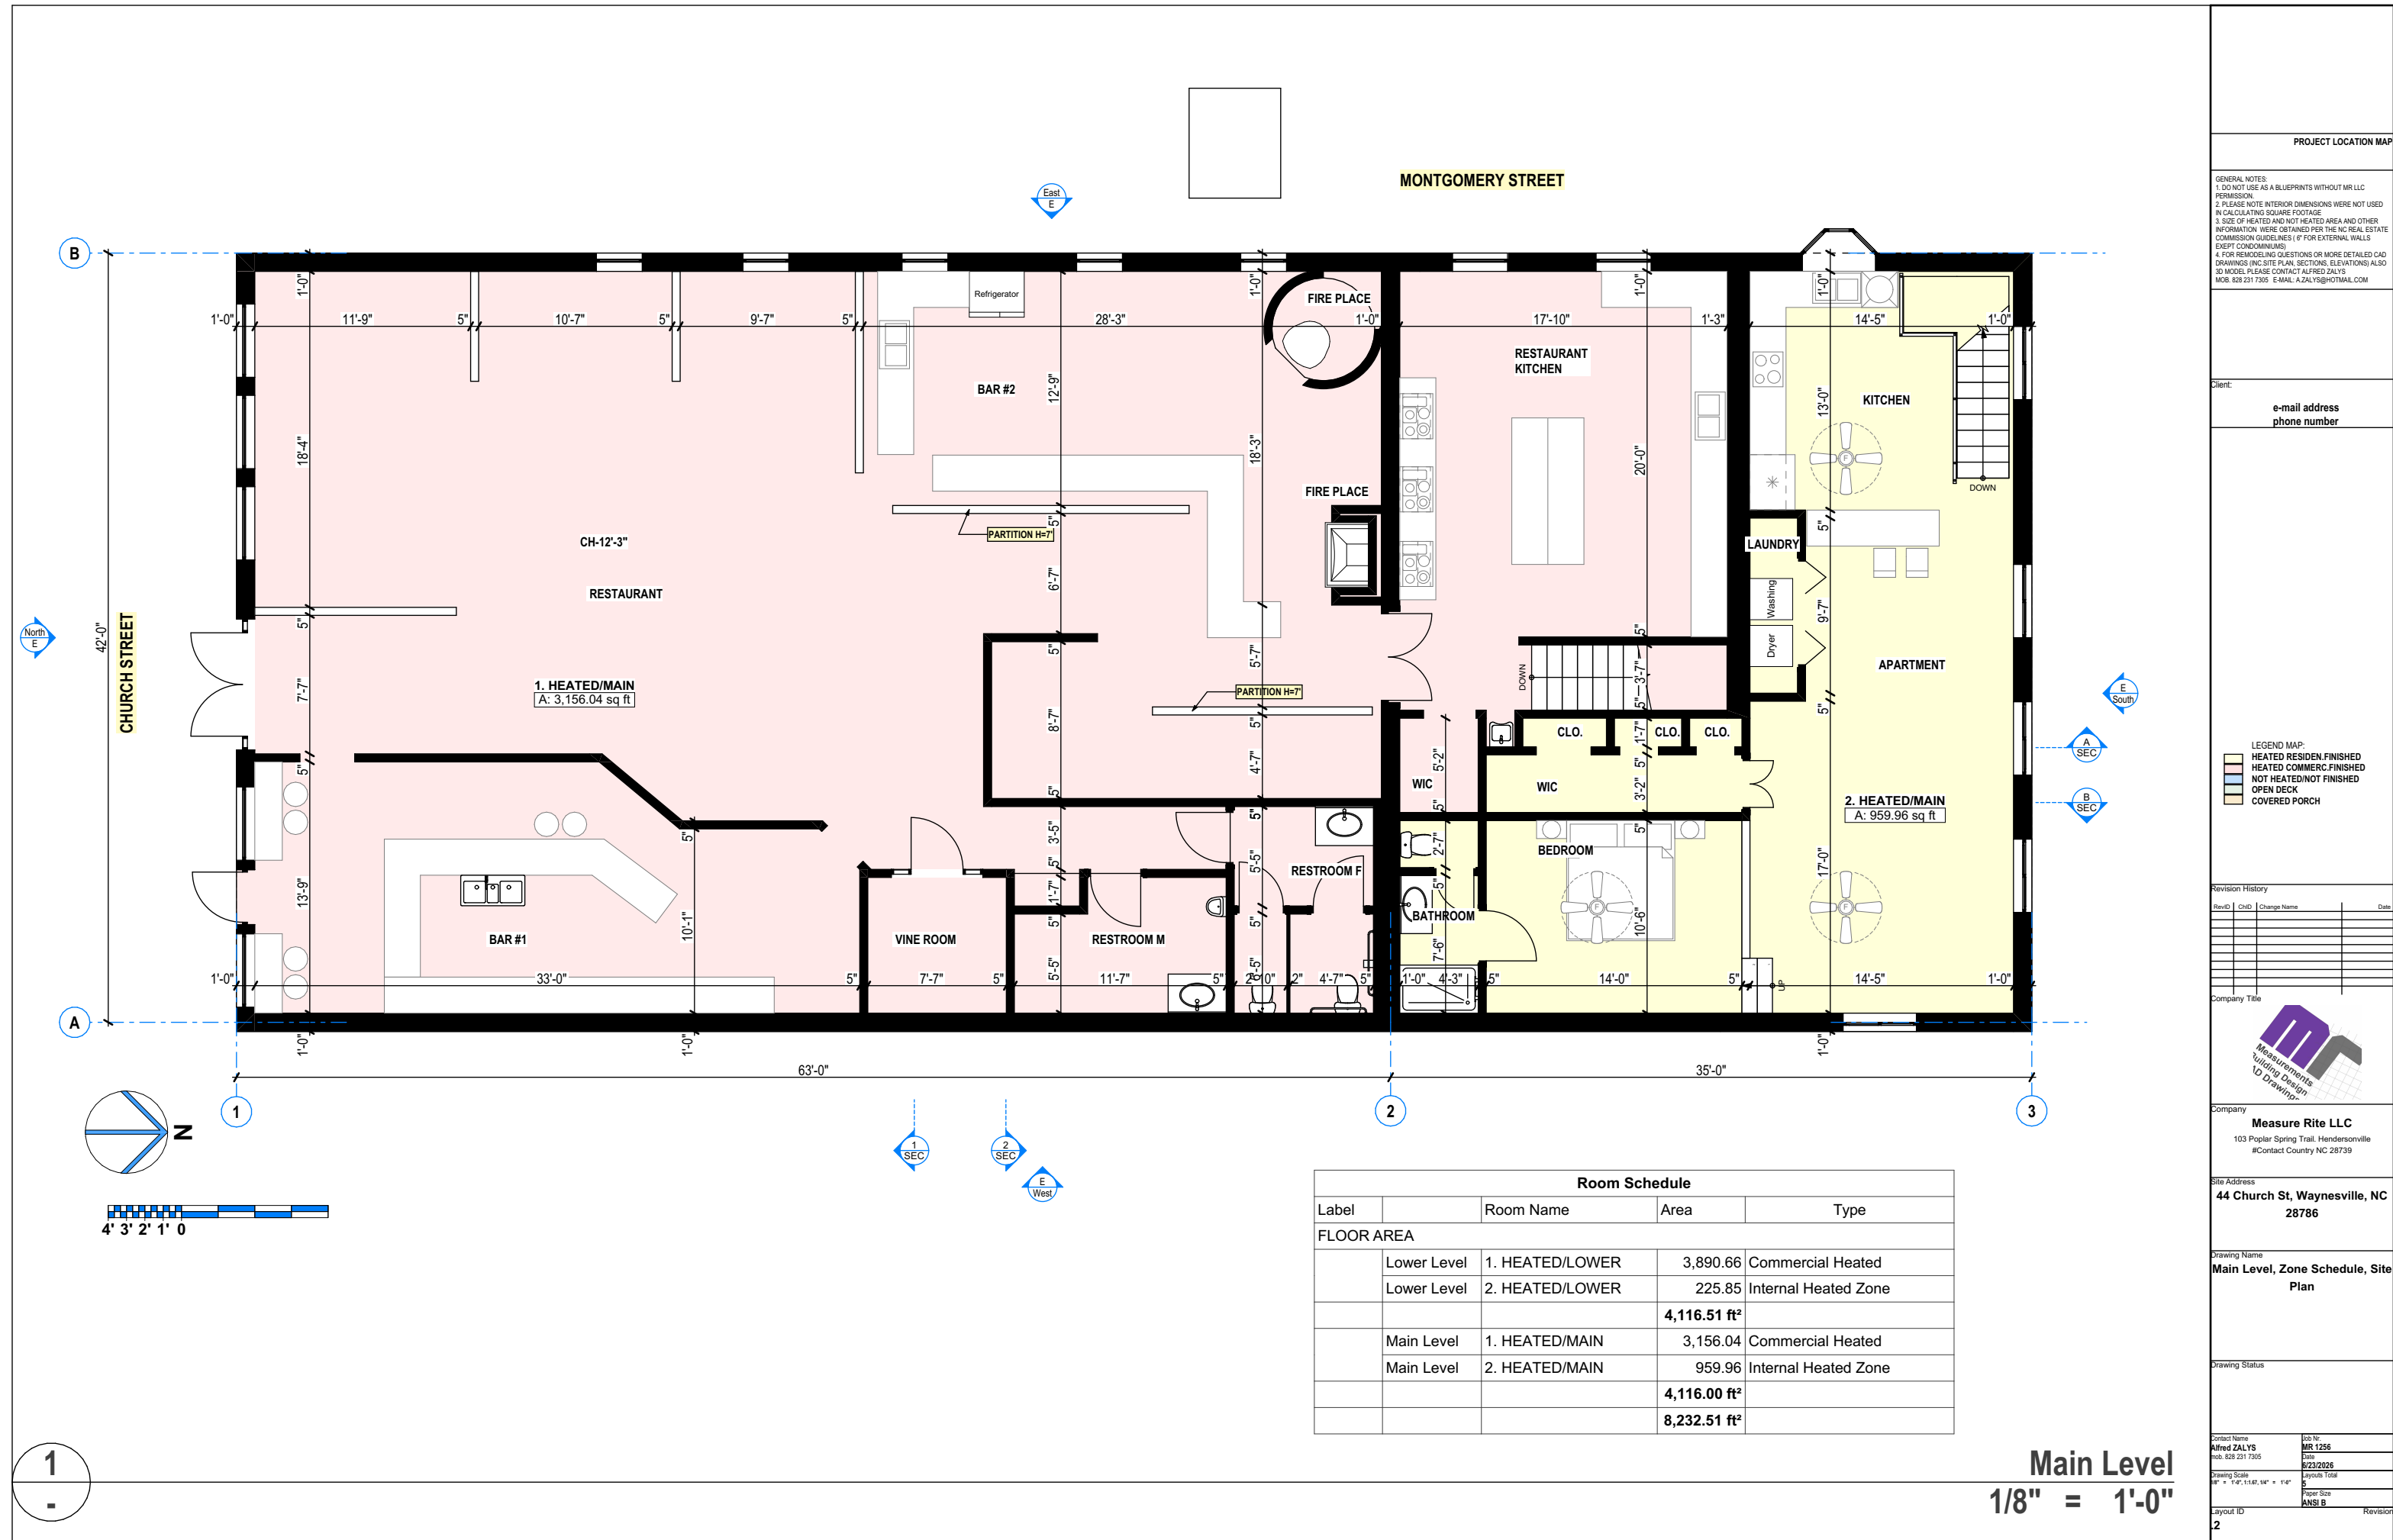

PROJECT LOCATION MAP


GENERAL NOTES:
 1. DO NOT USE AS A BLUEPRINTS WITHOUT MR.LLC PERMISSION.
 2. PLEASE NOTE INTERIOR DIMENSIONS WERE NOT USED IN CALCULATING SQUARE FOOTAGE.
 3. SIZE OF HEATED AND NOT HEATED AREA AND OTHER INFORMATION WERE OBTAINED PER THE NC REAL ESTATE COMMISSION GUIDELINES (8" FOR EXTERNAL WALLS EXCEPT CONDOMINIUMS).
 4. FOR REMODELING QUESTIONS OR MORE DETAILED CAD DRAWINGS (INC. SITE PLAN, SECTIONS, ELEVATIONS) ALSO 3D MODEL PLEASE CONTACT ALFRED ZALYS MOB. 828 231 7305 E-MAIL: A.ZALYS@HOTMAIL.COM

Client: _____
 e-mail address _____
 phone number _____

LEGEND MAP:
 HEATED RESIDEN.FINISHED
 HEATED COMMERC.FINISHED
 NOT HEATED/NOT FINISHED
 OPEN DECK
 COVERED PORCH

Revision History

RevID	Chd	Change Name	Date

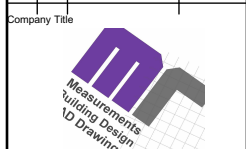

Company
Measure Rite LLC
 103 Poplar Spring Trail, Hendersonville
 #Contact Country NC 28739

Site Address
44 Church St, Waynesville, NC 28786

Drawing Name
Main Level, Zone Schedule, Site Plan

Drawing Status

Contact Name Alfred ZALYS mob. 828 231 7305	Job No. MR 1256 Date 8/23/2026
Drawing Scale 1/8" = 1'-0", 1/4" = 1'-0"	Layout ANSI B
Layout ID 2	Revisor

Main Level
1/8" = 1'-0"

1

PROJECT LOCATION MAP


GENERAL NOTES:
 1. DO NOT USE AS A BLUEPRINTS WITHOUT MR.LLC PERMISSION.
 2. PLEASE NOTE INTERIOR DIMENSIONS WERE NOT USED IN CALCULATING SQUARE FOOTAGE.
 3. SIZE OF HEATED AND NOT HEATED AREA AND OTHER INFORMATION WERE OBTAINED PER THE NC REAL ESTATE COMMISSION GUIDELINES (6" FOR EXTERNAL WALLS EXCEPT CONDOMINIUMS).
 4. FOR REMODELING QUESTIONS OR MORE DETAILED CAD DRAWINGS (INC. SITE PLAN, SECTIONS, ELEVATIONS) ALSO 3D MODEL PLEASE CONTACT ALFRED ZALYS MOB. 828 231 7305 E-MAIL: A.ZALYS@HOTMAIL.COM

Client:
 e-mail address
 phone number

LEGEND MAP:
 HEATED RESIDEN.FINISHED
 HEATED COMMERC.FINISHED
 NOT HEATED/NOT FINISHED
 OPEN DECK
 COVERED PORCH

Revision History

RevID	ChID	Change Name	Date

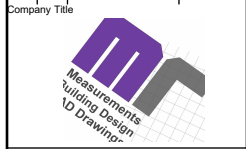


Company
Measure Rite LLC
 103 Poplar Spring Trail, Hendersonville
 #Contact Country NC 28739

Site Address
44 Church St, Waynesville, NC 28786

Drawing Name
Lower Level, Zone Schedule


Drawing Status

Contact Name Alfred ZALYS mob. 828 231 7305	Proj No. MR 1256 Date 8/23/2026
Drawing Scale 1/8" = 1'-0", 1:60	Layout B
Layout ID 3	Revision

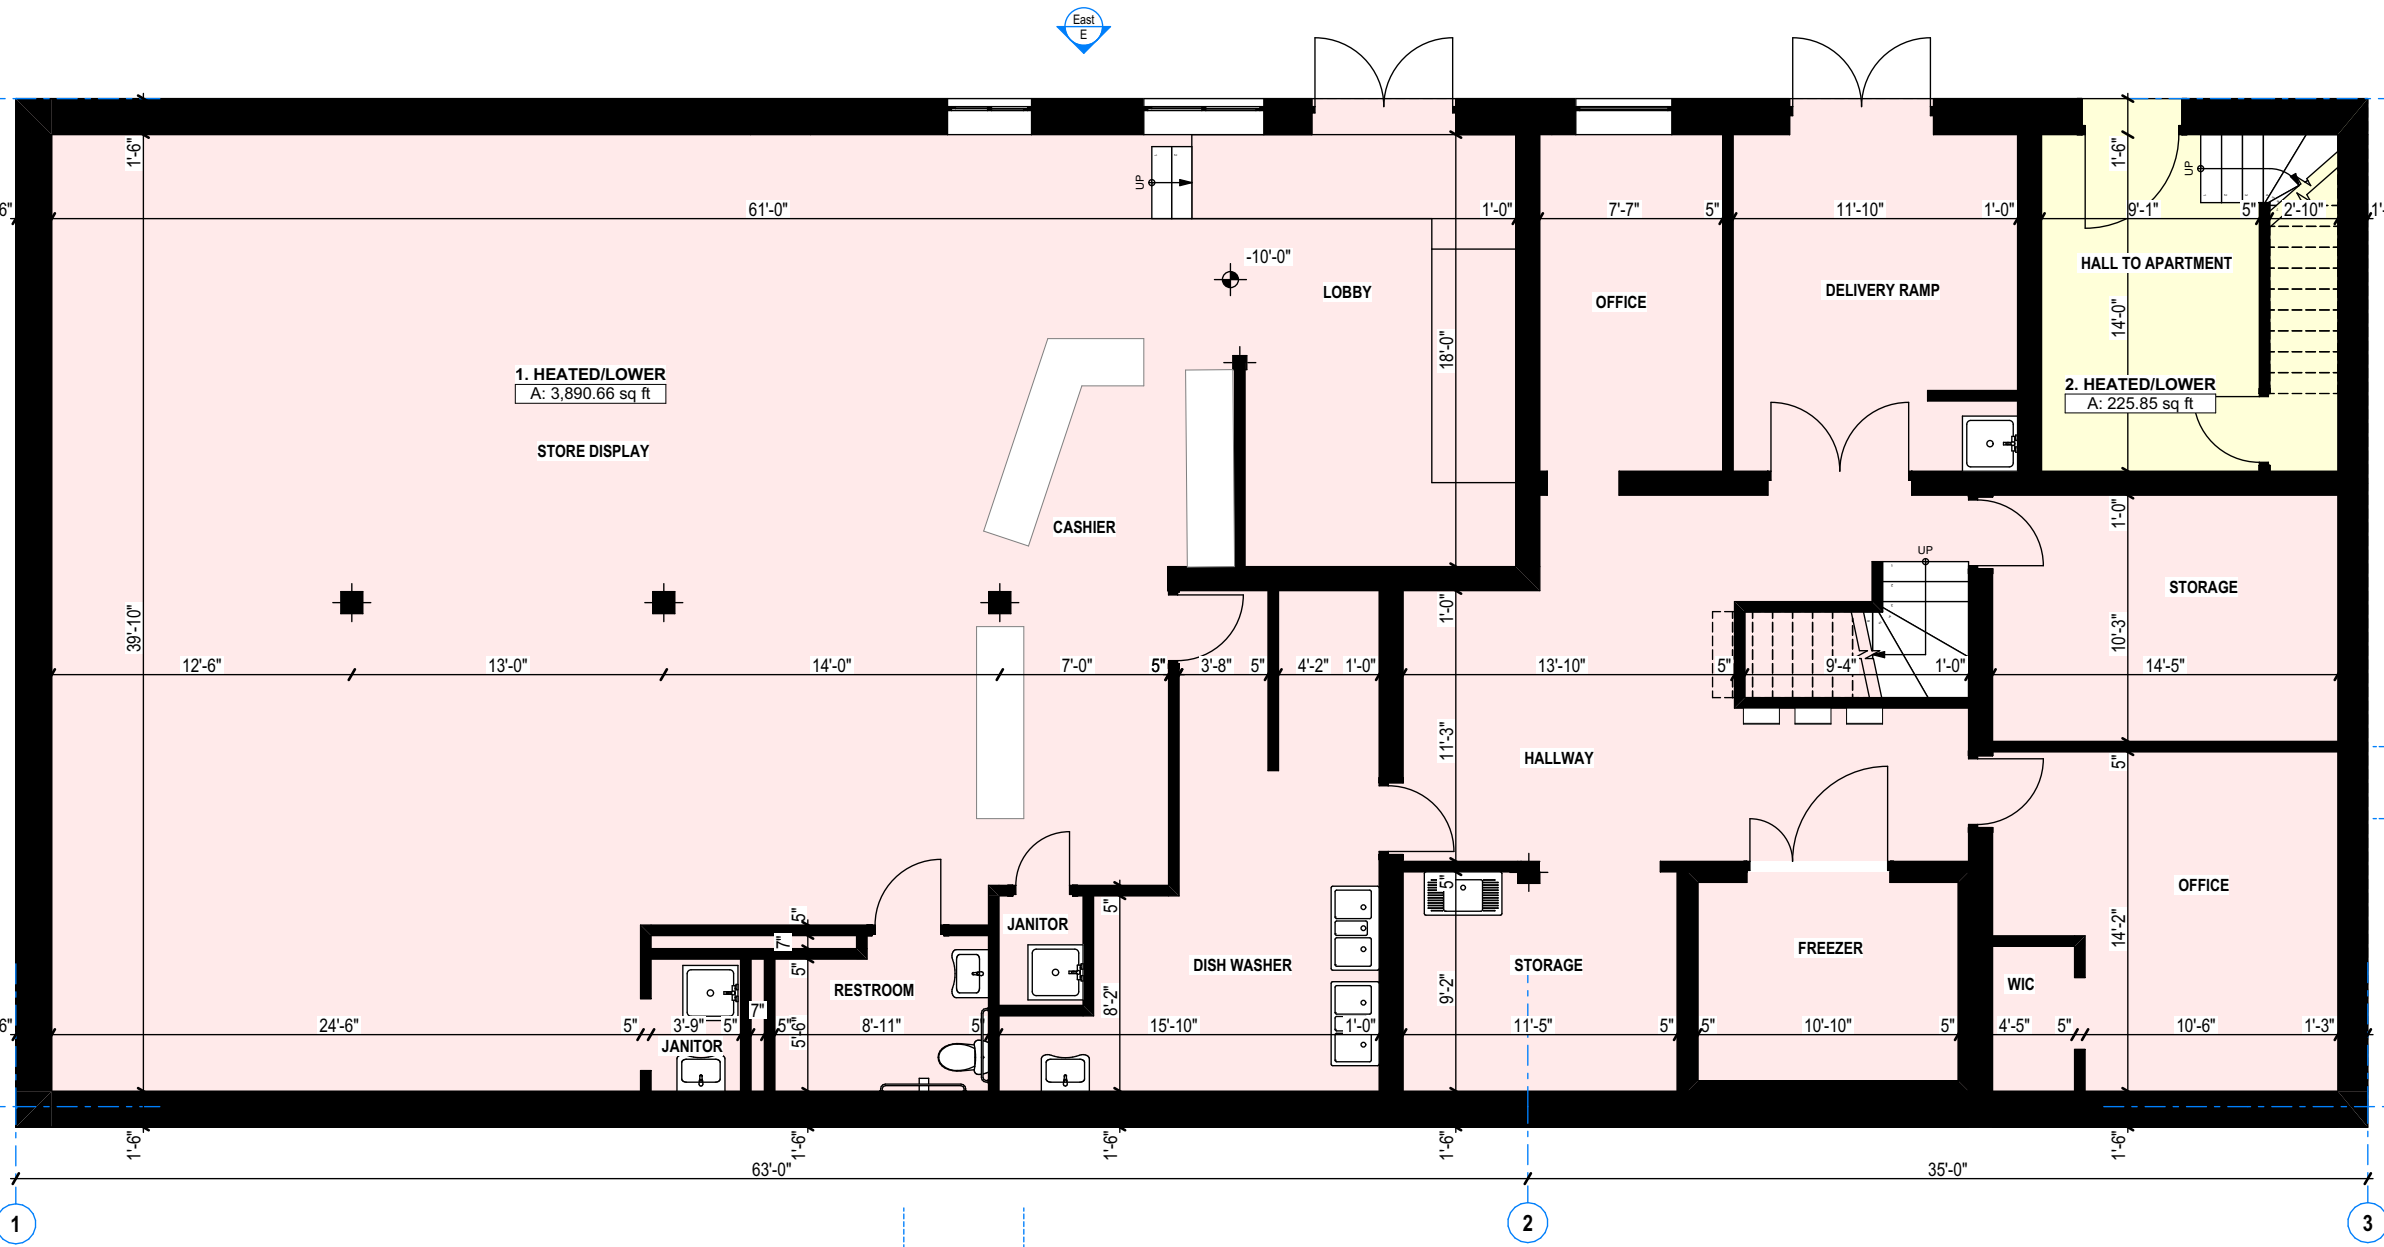


Room Schedule				
Label		Room Name	Area	Type
FLOOR AREA				
	Lower Level	1. HEATED/LOWER	3,890.66	Commercial Heated
	Lower Level	2. HEATED/LOWER	225.85	Internal Heated Zone
			4,116.51 ft²	
	Main Level	1. HEATED/MAIN	3,156.04	Commercial Heated
	Main Level	2. HEATED/MAIN	959.96	Internal Heated Zone
			4,116.00 ft²	
			8,232.51 ft²	

Lower Level
 1/8" = 1'-0"

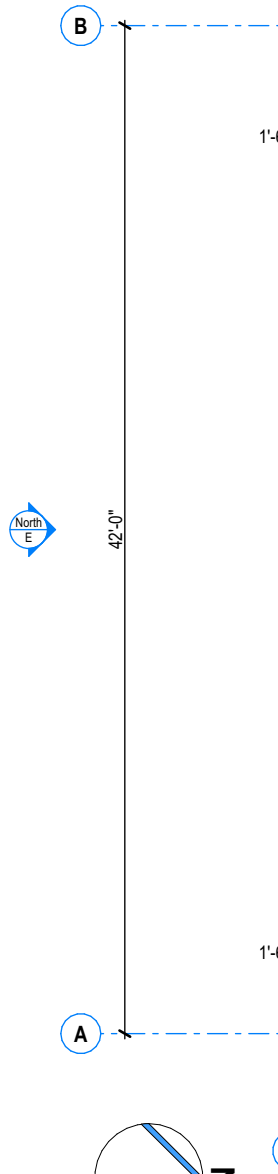

1

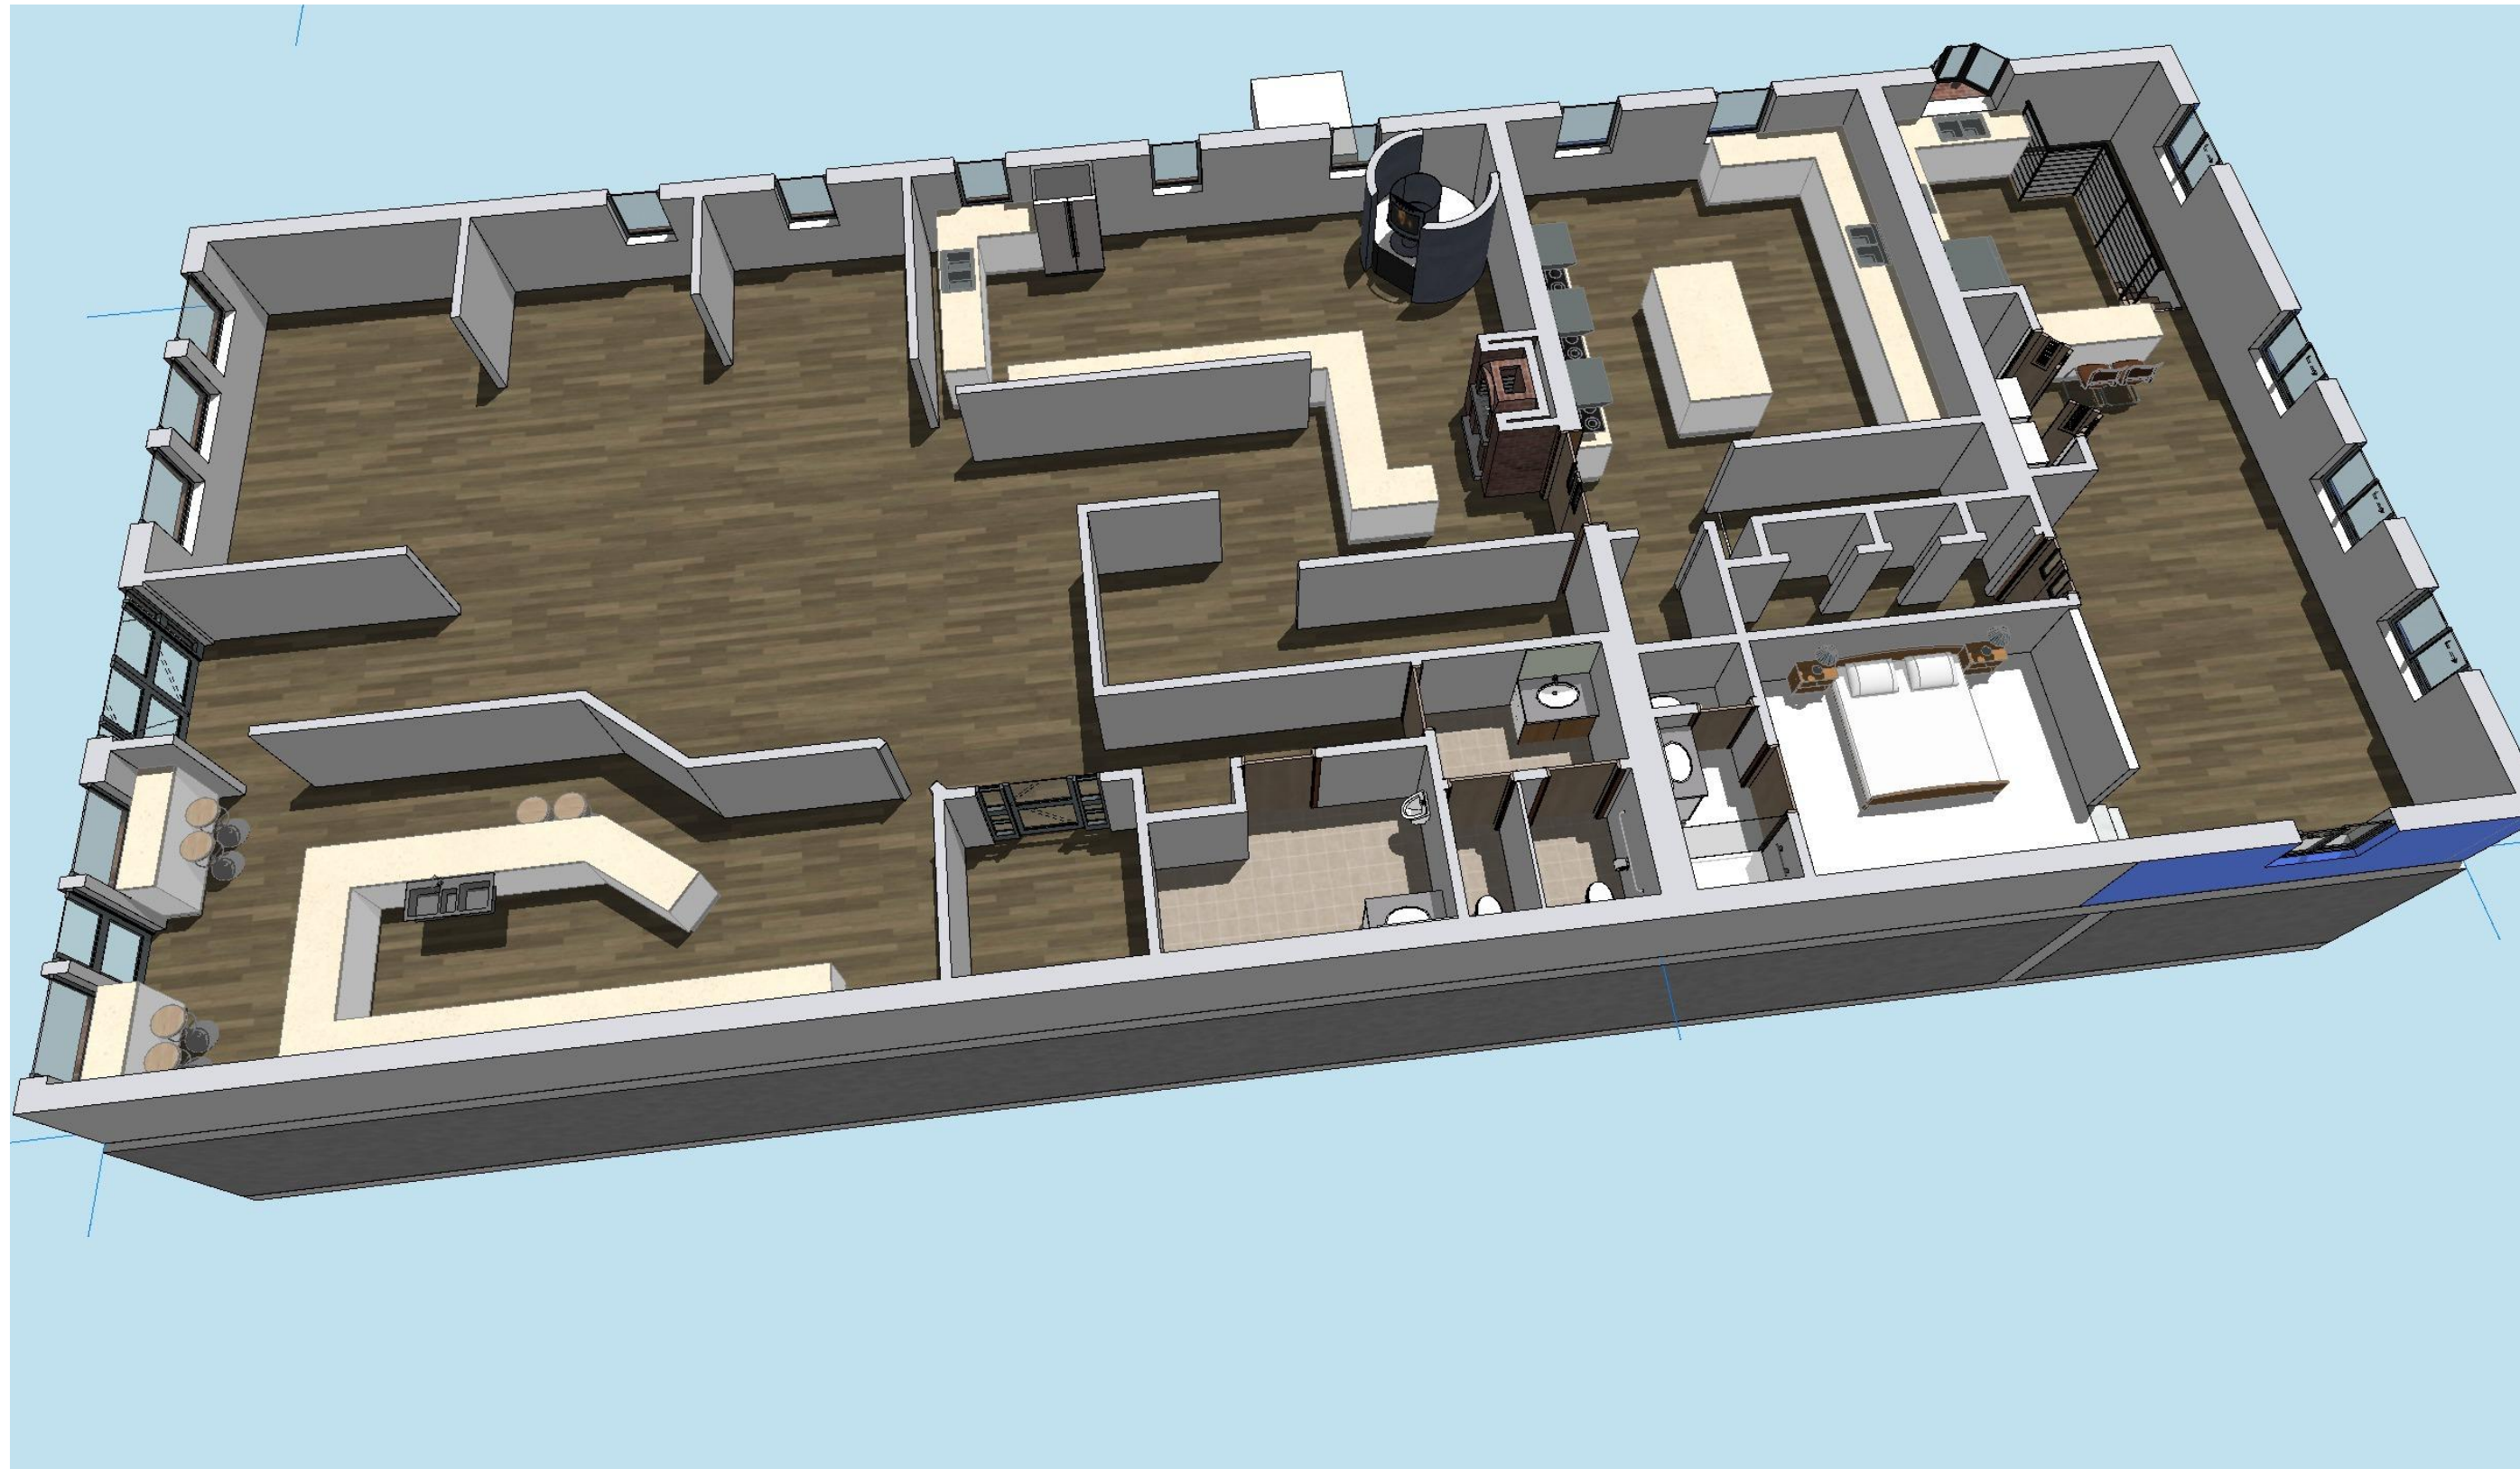

PROJECT LOCATION MAP

GENERAL NOTES:
 1. DO NOT USE AS A BLUEPRINTS WITHOUT MR.LLC PERMISSION.
 2. PLEASE NOTE INTERIOR DIMENSIONS WERE NOT USED IN CALCULATING SQUARE FOOTAGE.
 3. SIZE OF HEATED AND NOT HEATED AREA AND OTHER INFORMATION WERE OBTAINED PER THE NC REAL ESTATE COMMISSION GUIDELINES (6" FOR EXTERNAL WALLS EXCEPT CONDOMINIUMS).
 4. FOR REMODELING QUESTIONS OR MORE DETAILED CAD DRAWINGS (INC. SITE PLAN, SECTIONS, ELEVATIONS) ALSO 3D MODEL PLEASE CONTACT ALFRED ZALYS MOB. 828 231 7305 E-MAIL: A.ZALYS@HOTMAIL.COM

Client:
 e-mail address
 phone number

LEGEND MAP:
 HEATED RESIDEN.FINISHED
 HEATED COMMERC.FINISHED
 NOT HEATED/NOT FINISHED
 OPEN DECK
 COVERED PORCH

Revision History

RevID	Chd	Change Name	Date




Company
Measure Rite LLC
 103 Poplar Spring Trail, Hendersonville
 #Contact Country NC 28739

Site Address
44 Church St, Waynesville, NC 28786

Drawing Name
Generic Perspective / MAIN

Drawing Status

Contact Name Alfred ZALYS mob. 828 231 7305	Proj. No. MR 1256 Date 8/23/2026
Drawing Scale 1:131	Layout Total 5 Paper Size ANSI B
Layout ID 4	Revisor

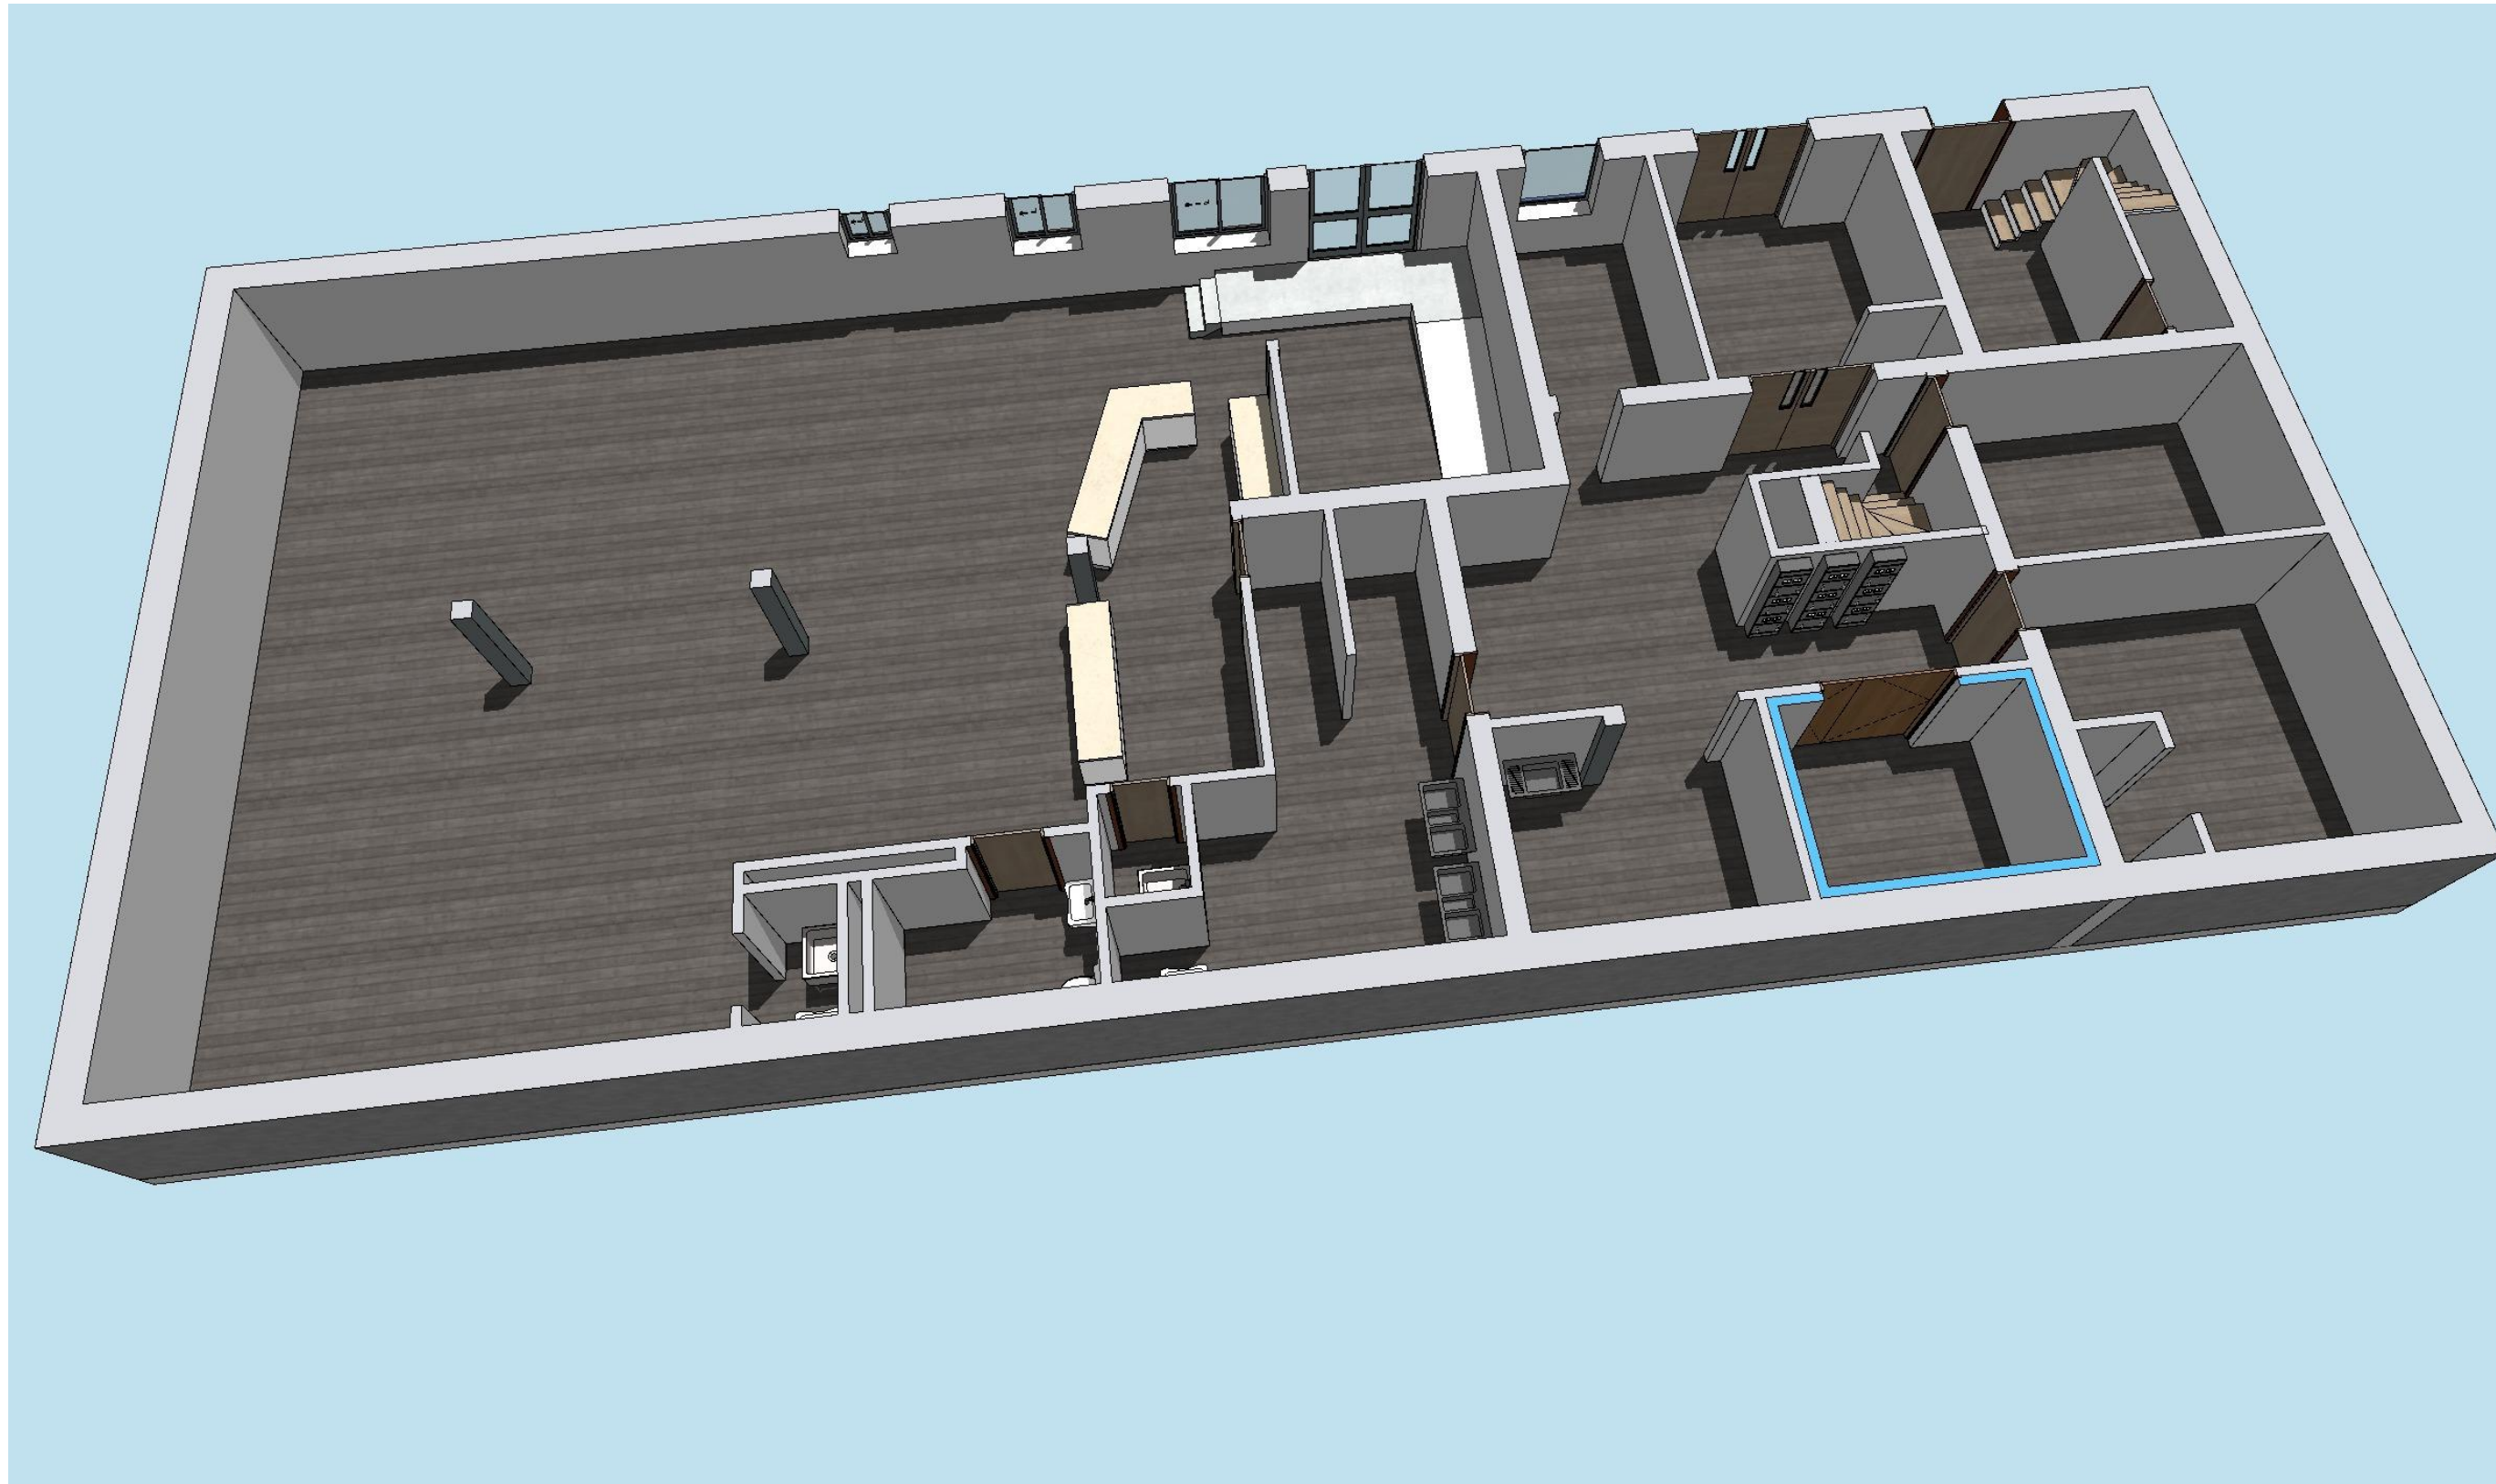

PROJECT LOCATION MAP

GENERAL NOTES:
 1. DO NOT USE AS A BLUEPRINTS WITHOUT MR.LLC PERMISSION.
 2. PLEASE NOTE INTERIOR DIMENSIONS WERE NOT USED IN CALCULATING SQUARE FOOTAGE.
 3. SIZE OF HEATED AND NOT HEATED AREA AND OTHER INFORMATION WERE OBTAINED PER THE NC REAL ESTATE COMMISSION GUIDELINES (6" FOR EXTERNAL WALLS EXCEPT CONDOMINIUMS).
 4. FOR REMODELING QUESTIONS OR MORE DETAILED CAD DRAWINGS (INC. SITE PLAN, SECTIONS, ELEVATIONS) ALSO 3D MODEL PLEASE CONTACT ALFRED ZALYS MOB. 828 231 7305 E-MAIL: A.ZALYS@HOTMAIL.COM

Client:
 e-mail address
 phone number

LEGEND MAP:
 HEATED RESIDEN.FINISHED
 HEATED COMMERC.FINISHED
 NOT HEATED/NOT FINISHED
 OPEN DECK
 COVERED PORCH

Revision History

RevID	Chd	Change Name	Date



Company
Measure Rite LLC
 103 Poplar Spring Trail, Hendersonville
 #Contact Country NC 28739

Site Address
**44 Church St, Waynesville, NC
 28786**

Drawing Name
Generic Perspective / LOWER

Drawing Status

Contact Name Alfred ZALYS mob. 828 231 7305	Job No. MR 1256 Date 8/22/2026
Drawing Scale 1:131	Layout 5 Paper Size ANSI B
Layout ID 5	Revisor