


BUILDING INFORMATION

STE 101	300 SQ. FT.
STE 103	456 SQ. FT.
STE 105	382 SQ. FT.
STE 107	540 SQ. FT.
STE 109	575 SQ. FT.
STE 111	1171 SQ. FT.

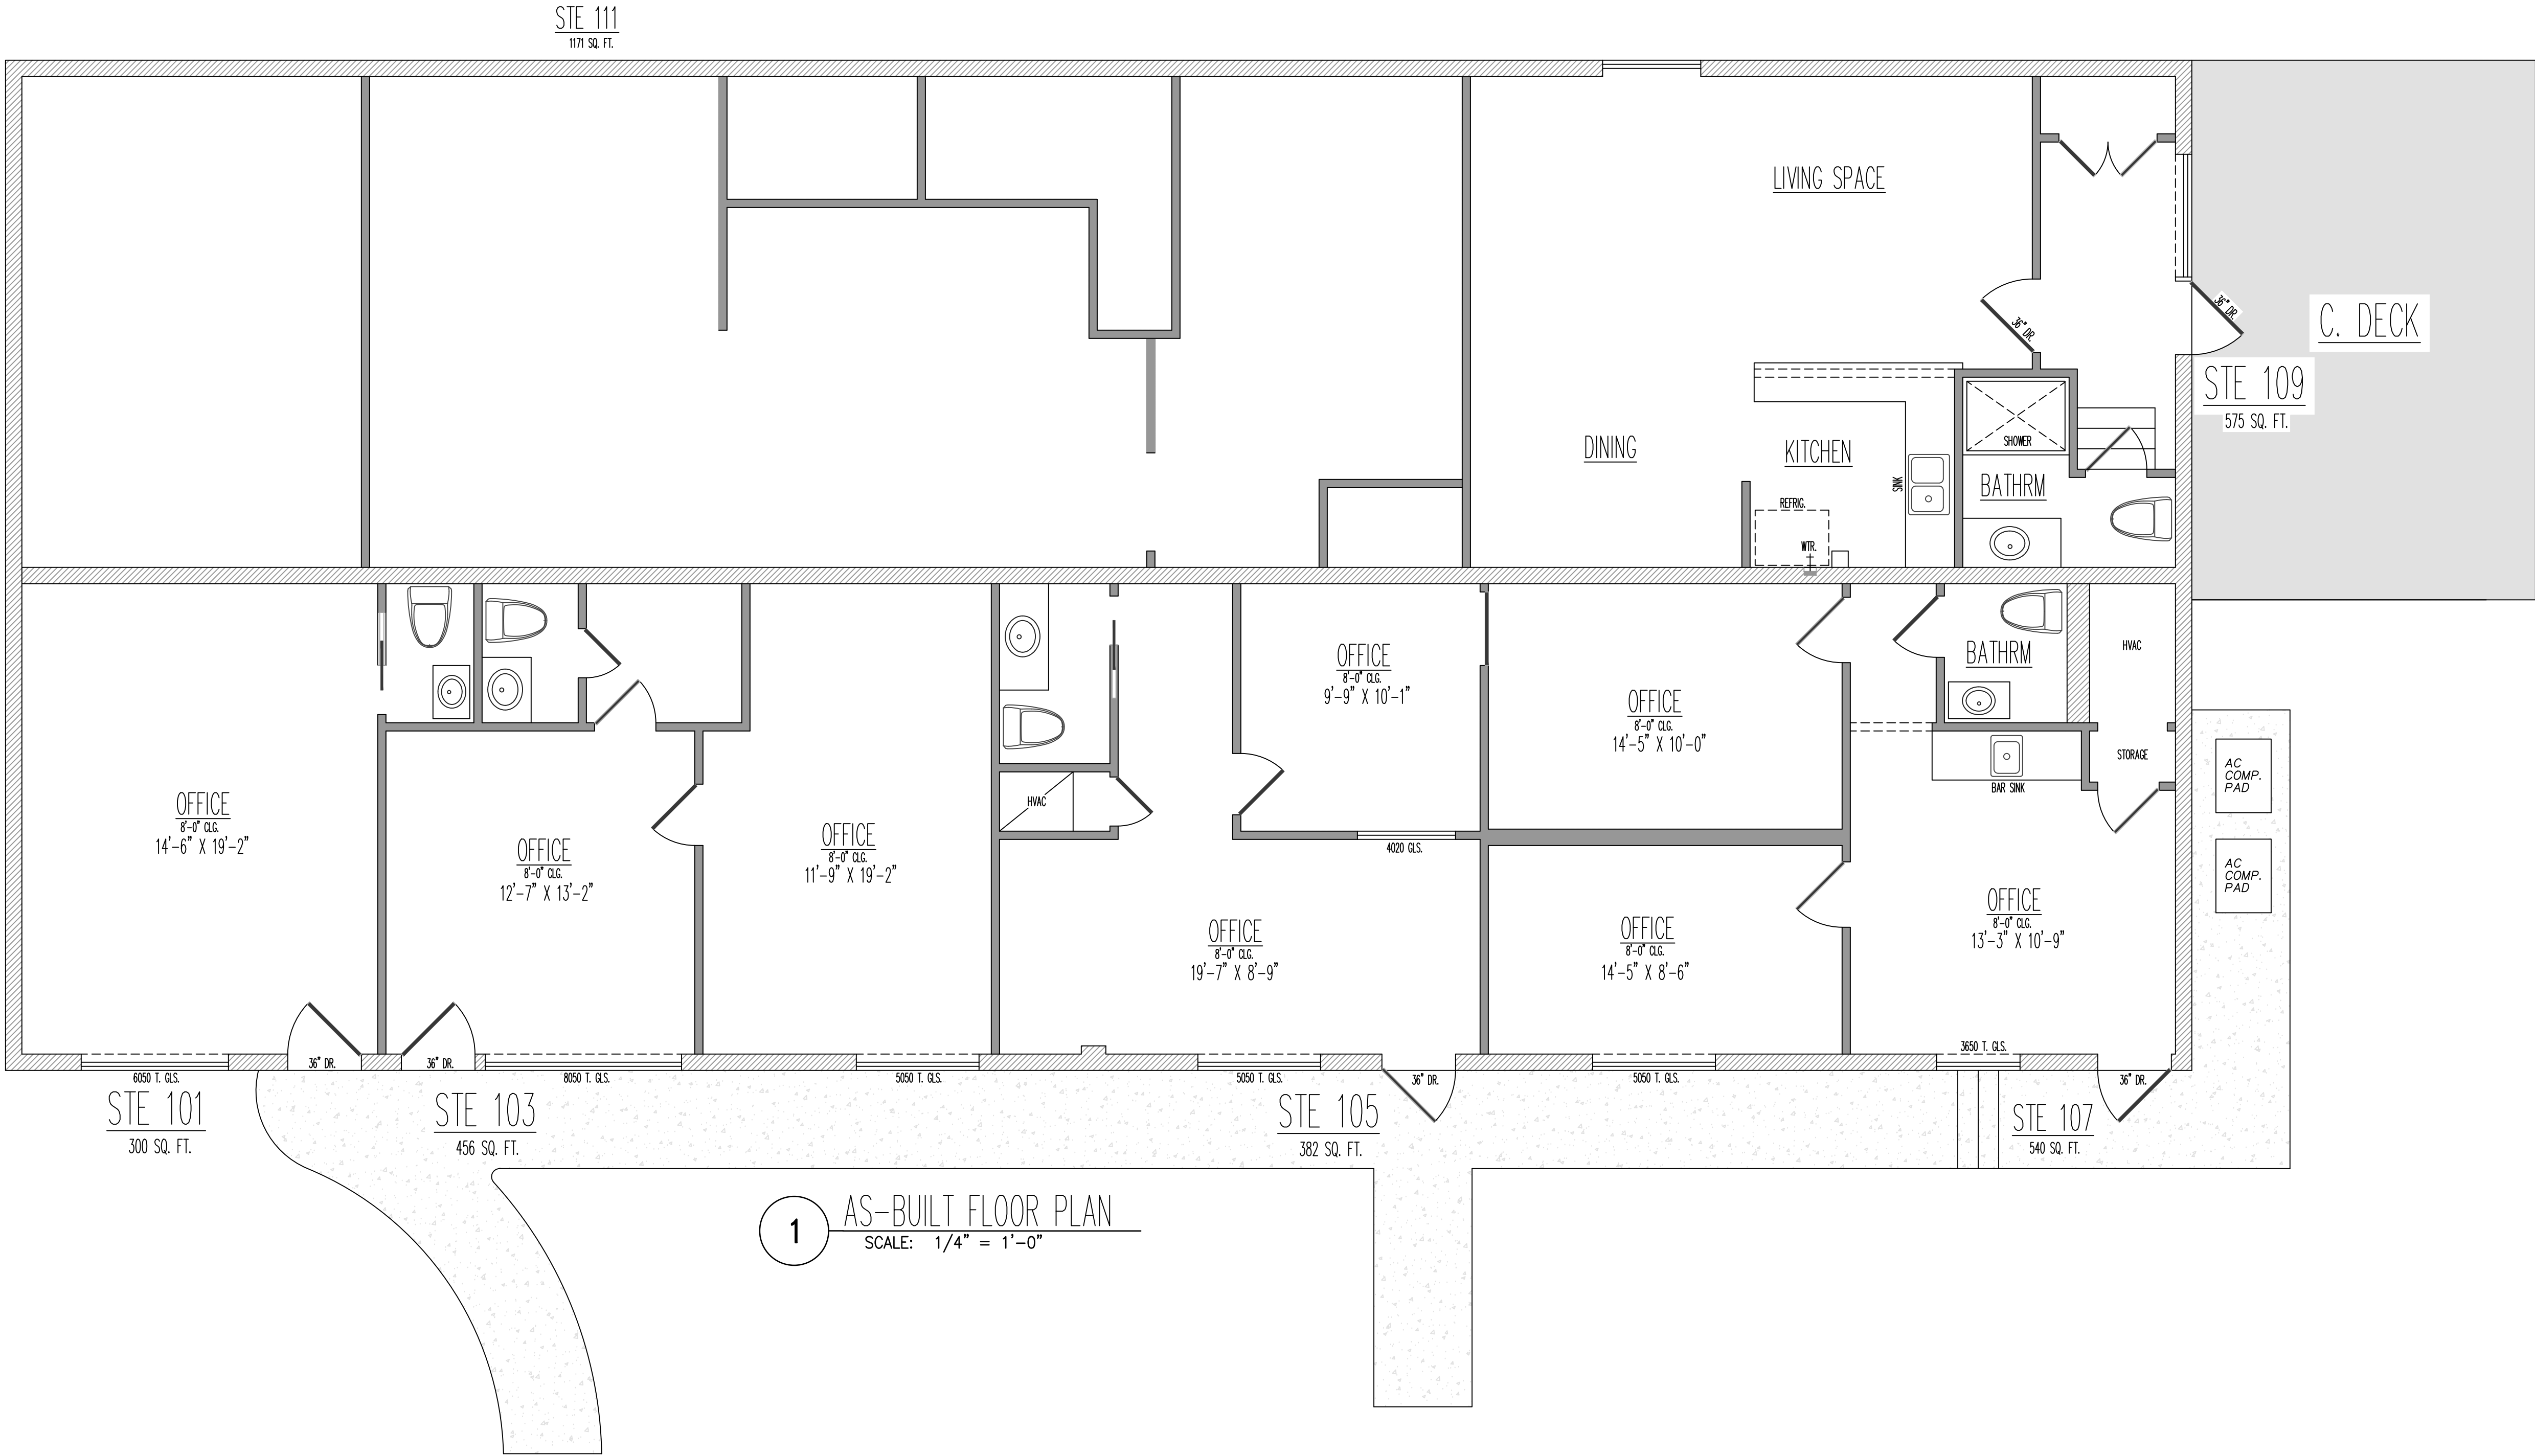


PLAN NO.:
CSTM-2020

EXCLUSIVE PROPERTY OF BROWN'S DESIGNS. THESE PLANS ARE
PROTECTED UNDER THE FEDERAL COPYRIGHT ACT. TITLE X OF THE
UNITED STATES CODE OF FEDERAL REGULATIONS. BROWN'S DESIGNS
RETAINS TITLE AND OWNERSHIP OF THE ORIGINAL DOCUMENTS.
THESE PLANS ARE NOT TO BE USED/REPRODUCED WITHOUT WRITTEN
PERMISSION BEFORE ANY PURCHASE AND/OR WORKED IS PERFORMED.

A As-Built Drawing For
635 HILL STREET
NEW BRAUNFELS TX.
78130

Another Plan From
Brown's Designs

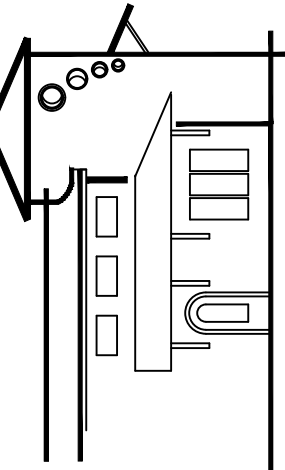

REVISIONS:

DRAWN BY:

DATE:

SHEET NO.:
1 OF 1