



DEPARTMENT OF ENVIRONMENTAL HEALTH
SEWAGE DISPOSAL SYSTEM
"AS-BUILT"

Approval issued to:

Name

Nigel Sota

Installer's Name

Mike Pieper

Mailing Address: 409 14th St

Application Number

152/00

AP Number

24-280-09

Living units 1 bedrooms 2

Property Address

9600 Sunshine Dr

Public System Individual

2nd house

Water Supply:

Septic Tank:

Drainfield:

Distance from well 400+ feet

Total Liquid Capacity

1200 gal.

Total Linear Feet 100

ft.

Width of Trench or Bed 2

ft.

Distance Between Drain Lines 10

ft. (edge to edge)

Depth Rock Over Drain Line 2

in.

Depth Rock Beneath Drain Line 24

in.

Distance of well from closest portion of sewage system 460+ ft.


Sewage Pit:

Depth _____

Diameter _____

Number _____

SKETCH OF ACTUAL SYSTEM AS CONSTRUCTED

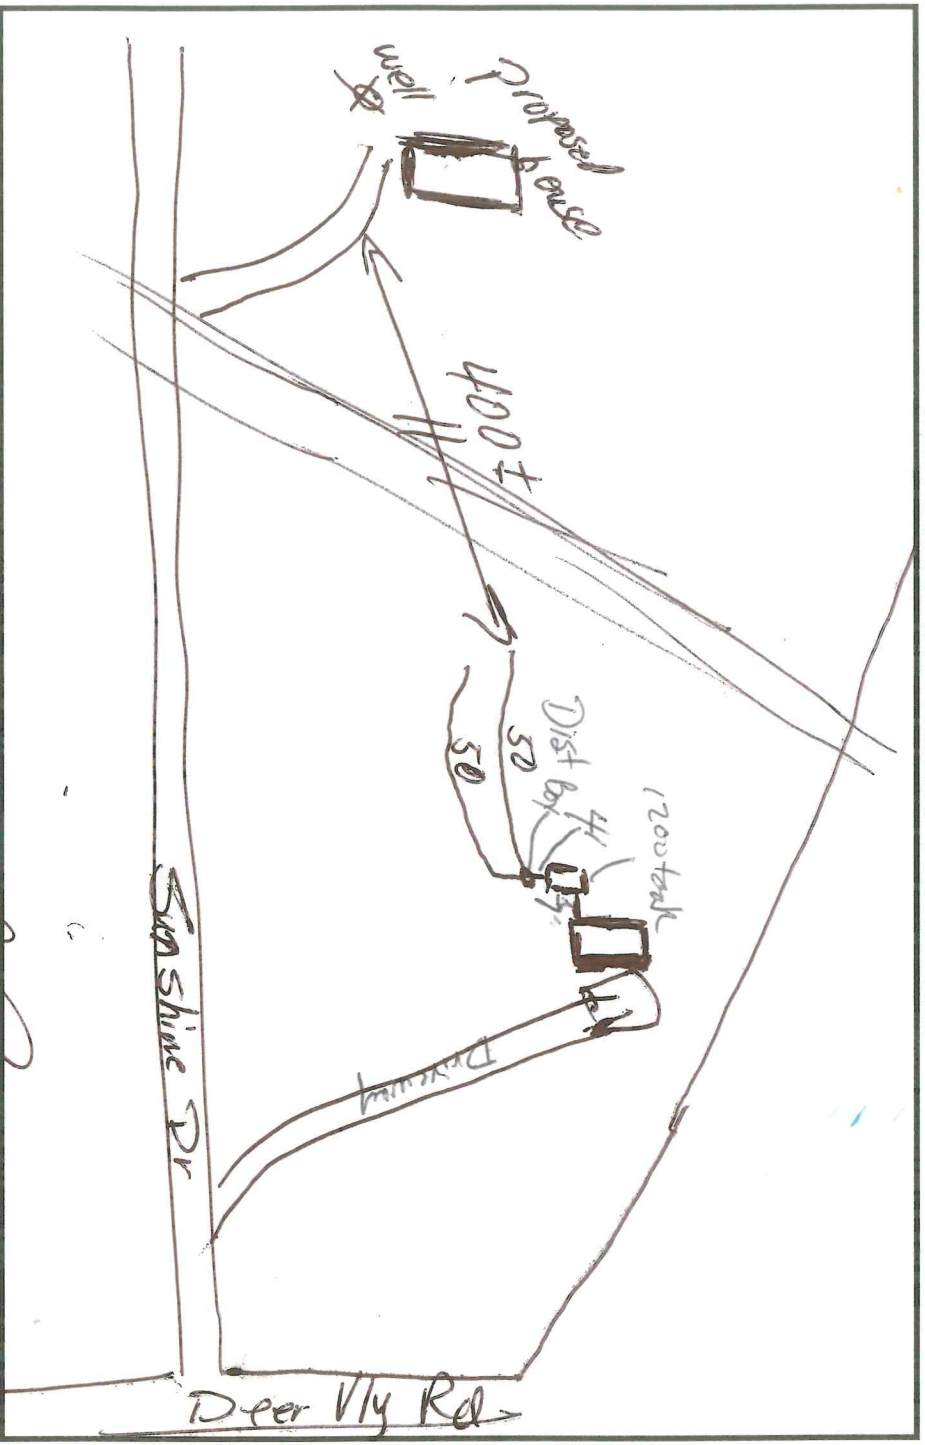

System meets all codes and is therefore **APPROVED**

X

for use

DISAPPROVED

SIGNATURE OF INSTALLER

DATE

Michael Pieper 7-26-02

Date

7/26/02

E.H. Specialist

[Signature]

REV. 4/97