




TRINITY HAVEN DEVELOPMENT

*COPYRIGHT - TRINITY HAVEN DEVELOPMENT 2023

AS-BUILT DRAWING SET

[illegible]

EXISTING FLOOR PLANS

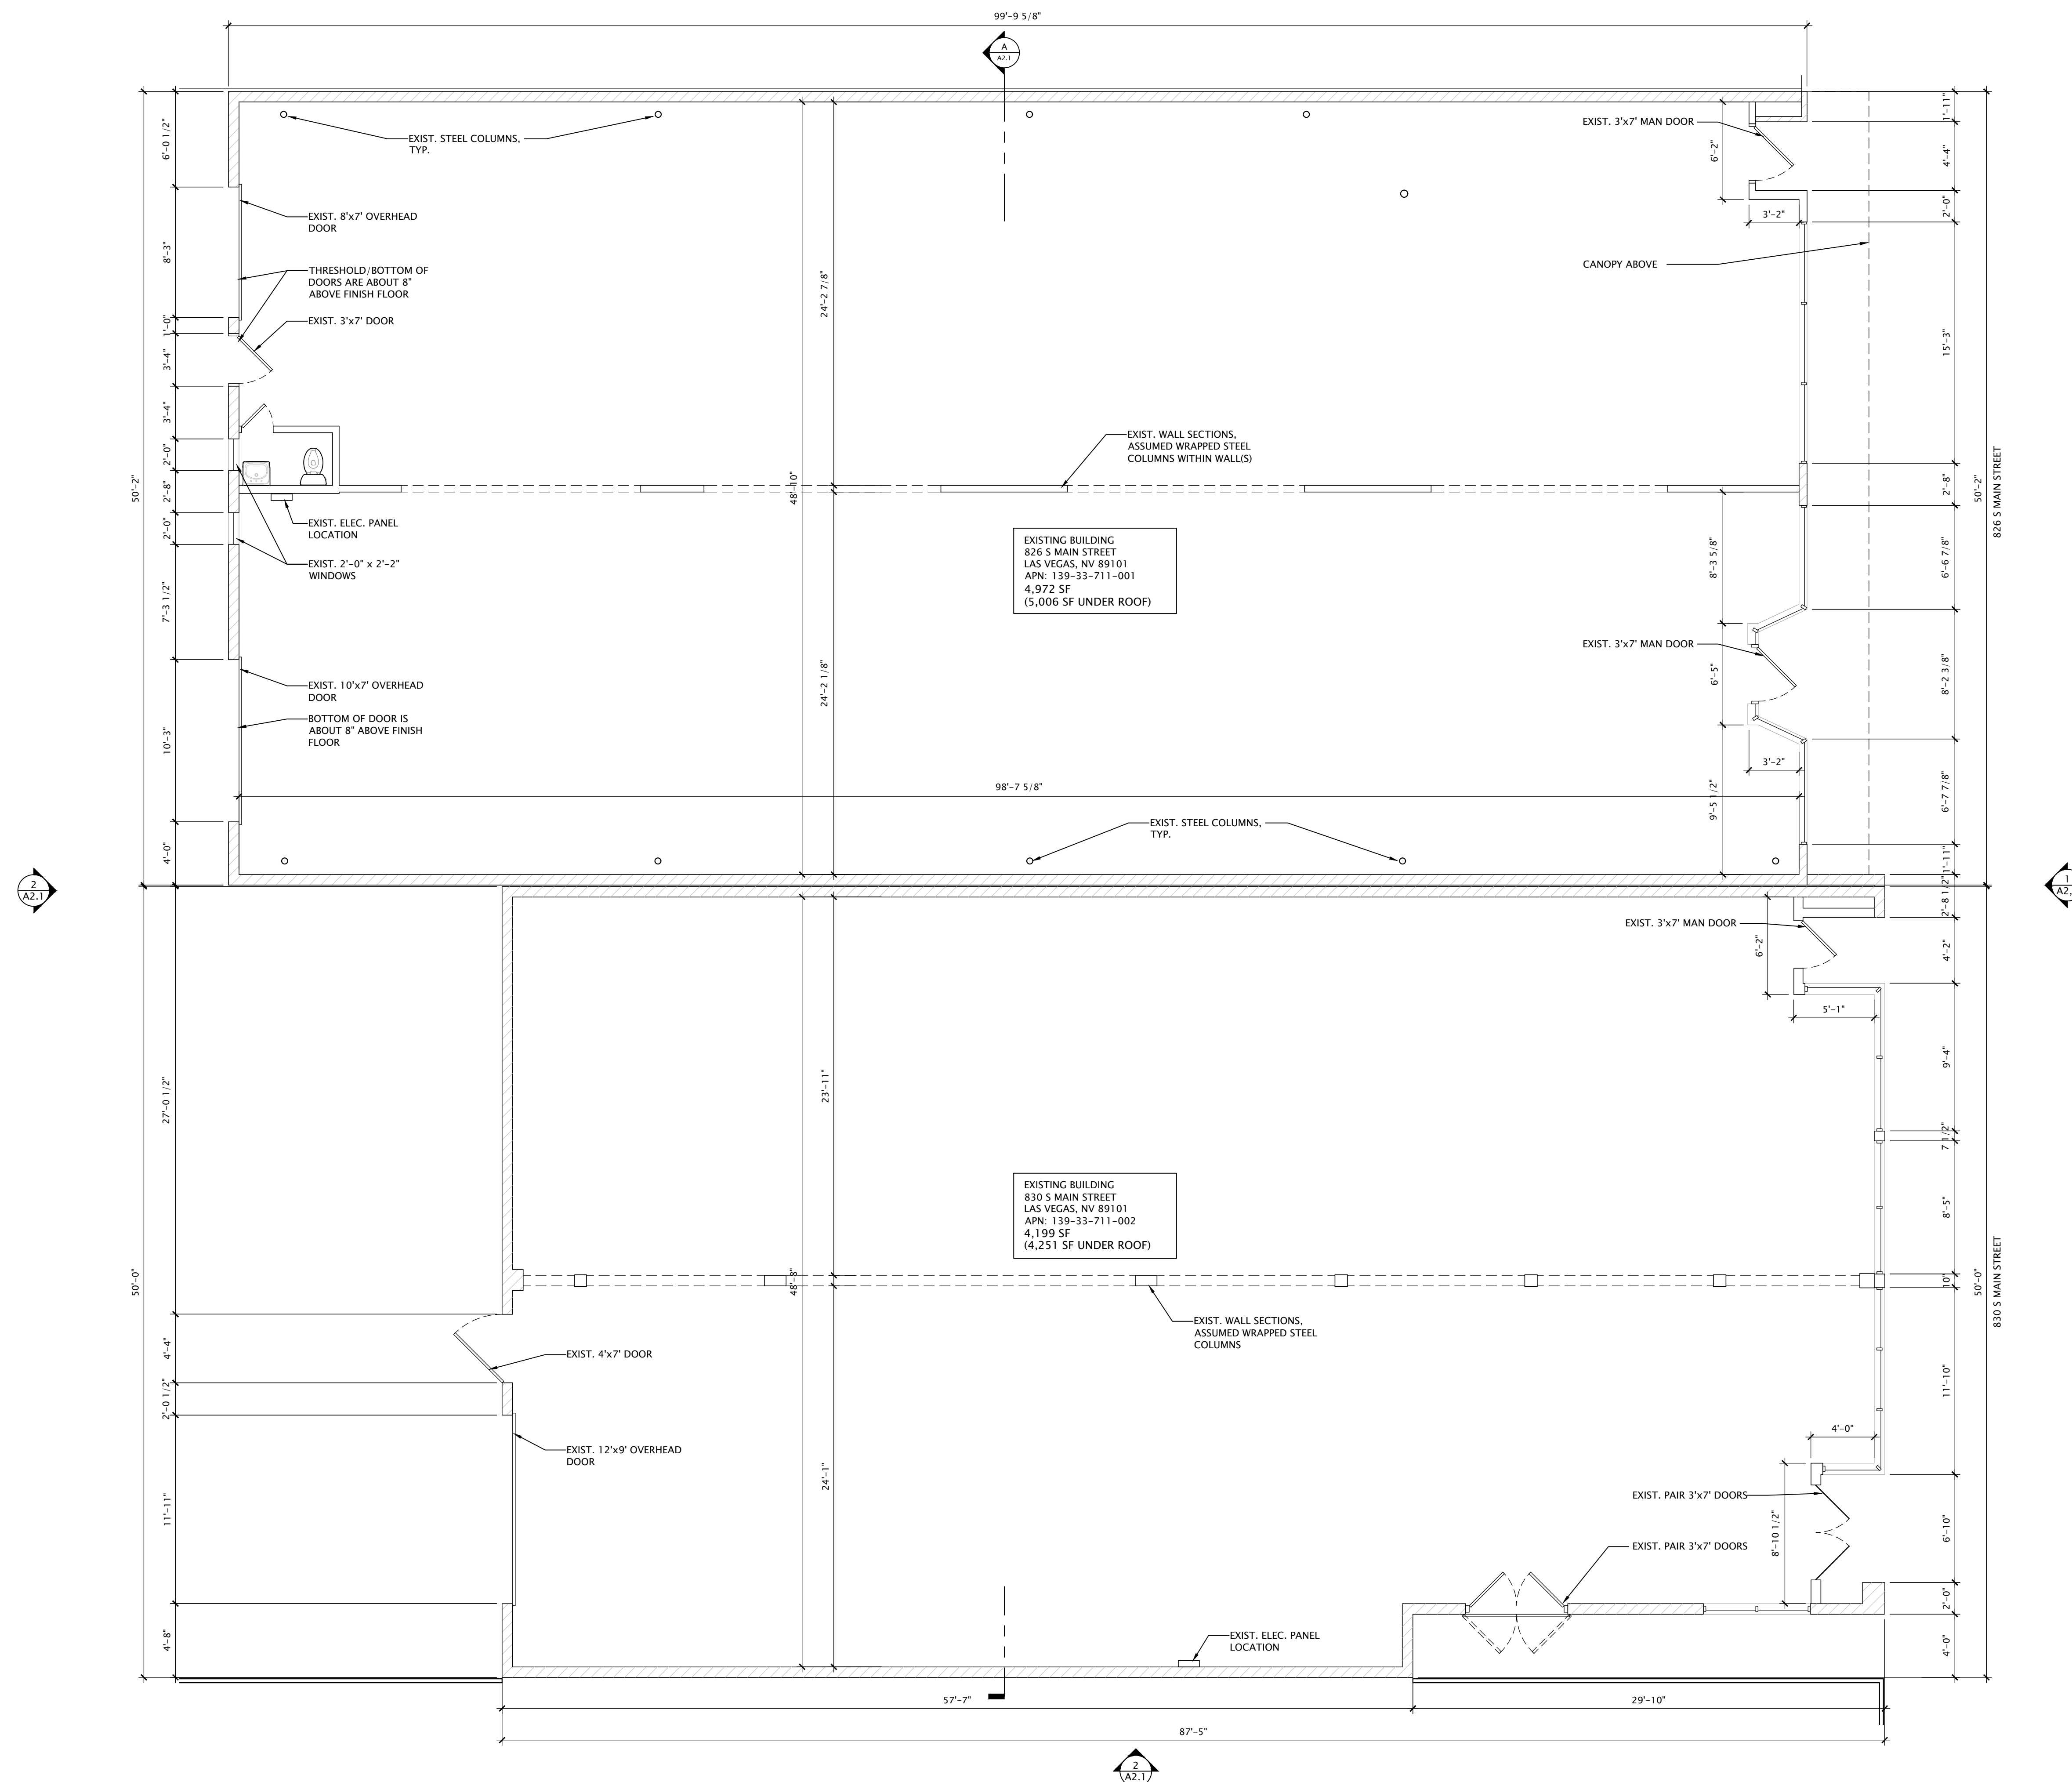

1 EXISTING FLOOR PLAN

A1.1 SCALE: 3/16" = 1'-0"

