




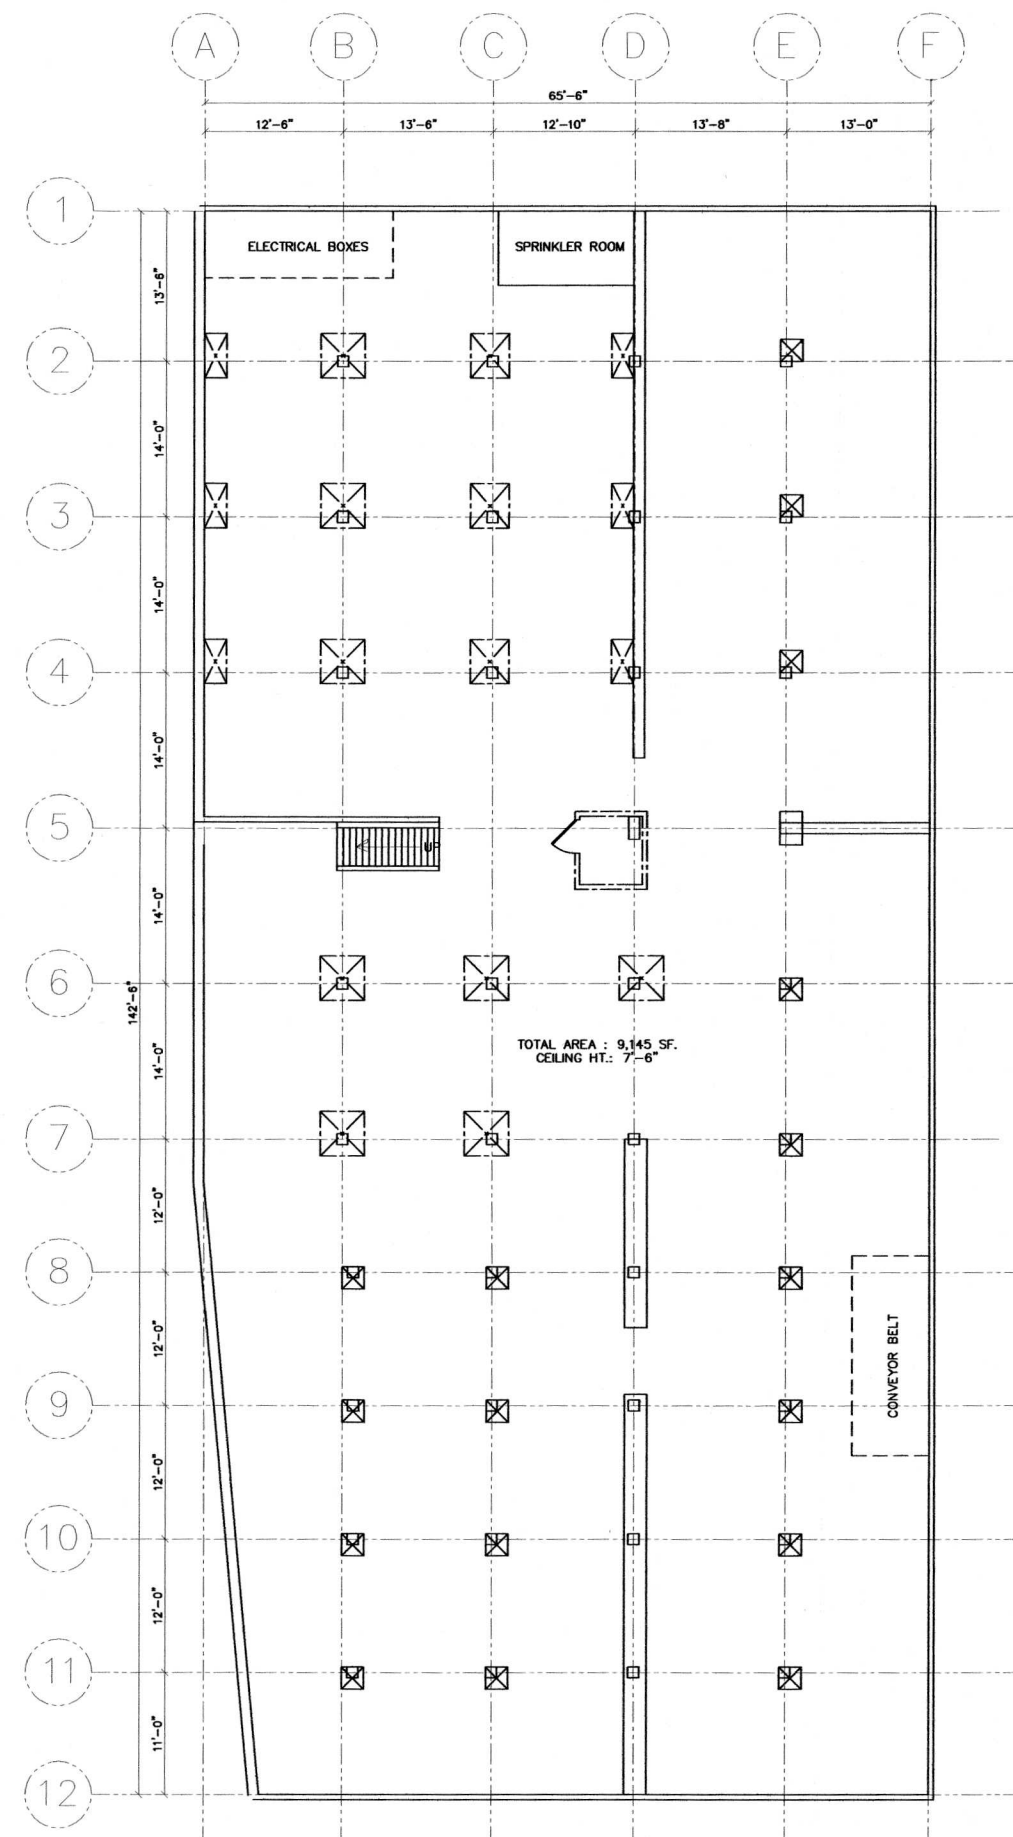

F&K STORE BASEMENT LAYOUT
SCALE 1 : 1/16"

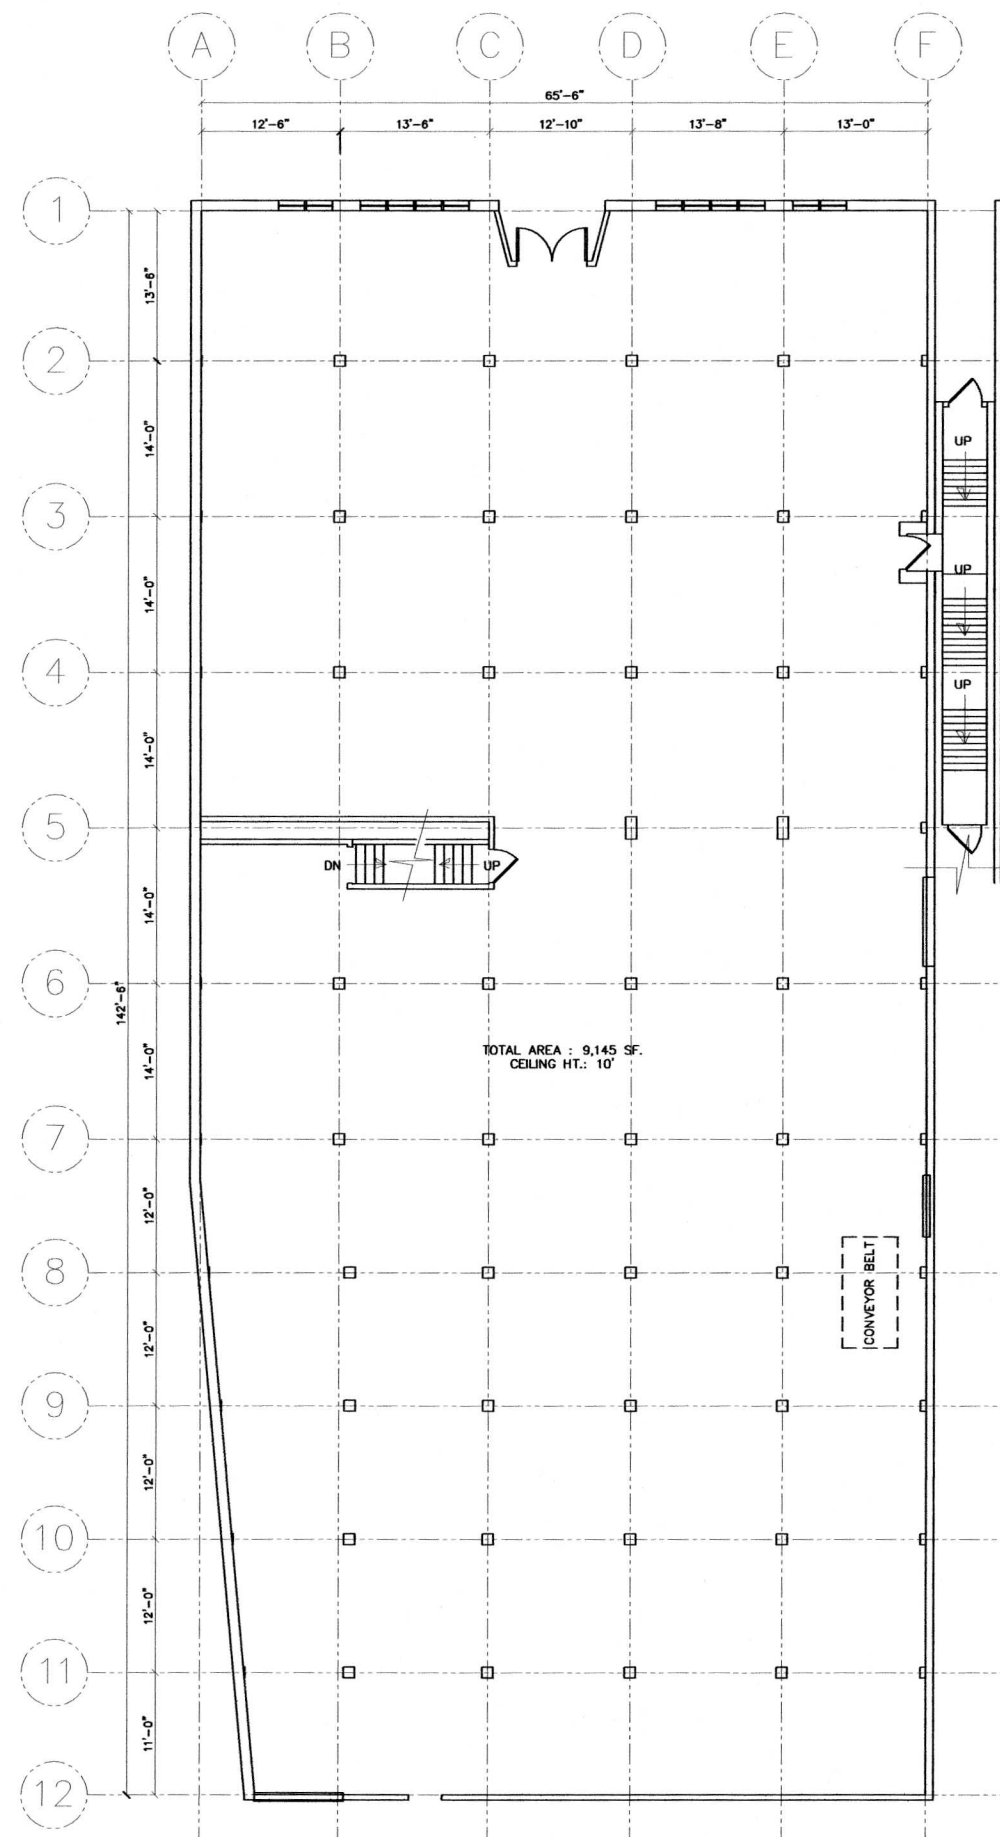


MAIN FLOOR F&K STORE LAYOUT
SCALE 1 : 1/16"

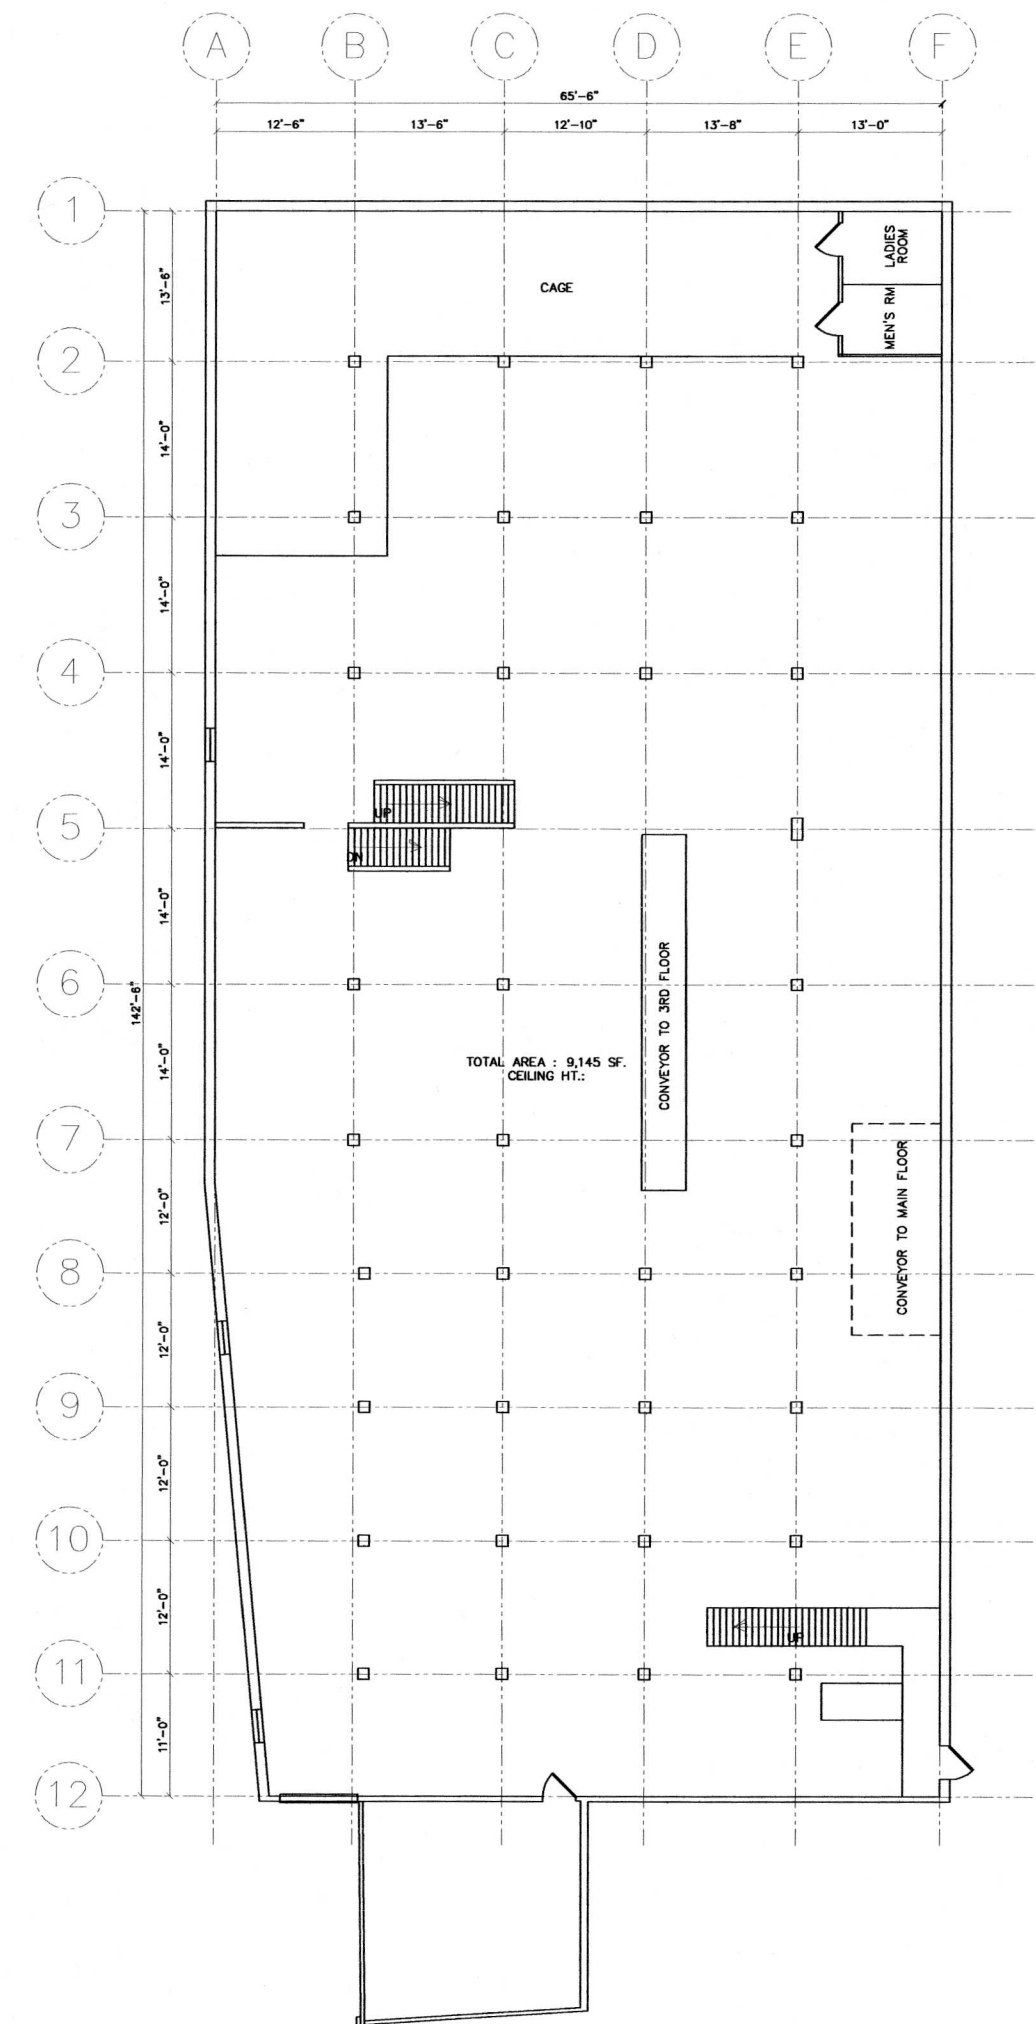

SECOND FLOOR F&K STORE LAYOUT
SCALE 1 : 1/16"

KEY PLAN

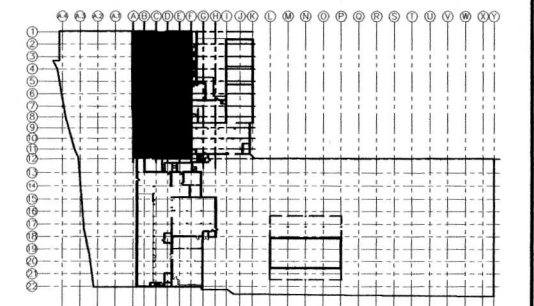

THIS DRAWING CONTAINS CONFIDENTIAL INFORMATION WHICH IS PROPERTY OF RIVERGATE DEVELOPMENT, LLC. THE INFORMATION CONTAINED HEREIN SHALL NOT BE USED OR COPIED IN ANY MANNER WITHOUT THE PRIOR CONSENT FROM RIVERGATE DEVELOPMENT, LLC.

GENERAL CONTRACTOR :	ARCHITECT:	OWNER :	PROJECT TITLE :	NO.	REVISION	DATE	SHEET CONTENT:	SHEET NO
RIVERGATE DEVELOPMENT, LLC 104 SMITH AVENUE KINGSTON, NEW YORK 12401 TEL # 845-331-0004 FAX # 845-331-1932	ARCHITECT ADD: TEL #	BIRCHEZ ASSOCIATES, LLC. LOCATION : 104 SMITH AVENUE, KINGSTON NY 12401	BIRCHEZ AS-BUILT DRAWING LOCATION : 104 SMITH AVENUE, KINGSTON NY 12401	Δ			F&K STORE MAIN FLOOR, 2ND FLOOR AND BASEMENT LAYOUT	A-3
							CHECKED TIM DRAWN FED SCALE FILE NAME APPROVED STEVE DATE 09/14/06 1 : 1/16" R:\Projects\2006\09\14\06\F&K Store\2006_09_14_06\F&K Store.dwg	AB