


WINGATE BUILDING



triad design group
 4807-C Koger Boulevard
 Greensboro, NC 27407
 Telephone 336-218-8282
 Facsimile 336-218-8010
 www.triad-designgroup.com

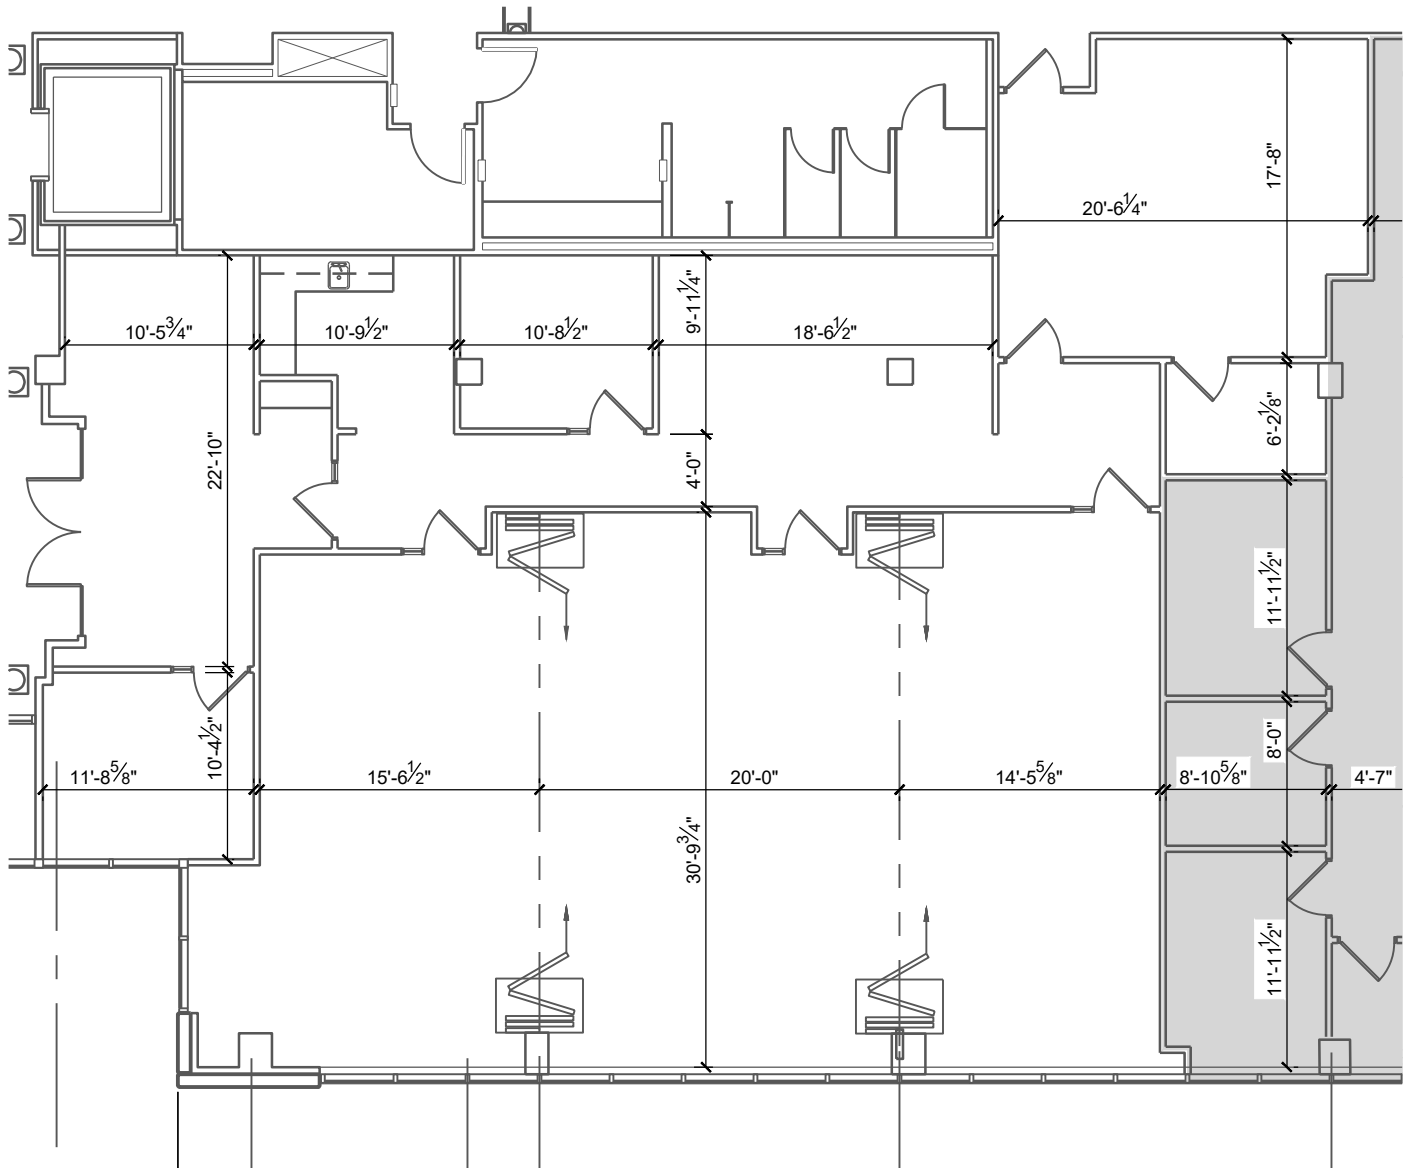

ORP Management
 7800 McCloud Road
 Suite 400
 Greensboro, NC 27409
 Telephone 336.567.2033
 www.owroostpartners.com

Suite 100
 4900 Koger Boulevard
 Greensboro, North Carolina

Wingate Building 1st Floor
 Date: February 24, 2021
 Scale: 3/32" = 1'-0"

This drawing and the details herein, as instruments of service, are property of Triad Design Group, PC, and may be used only for this specific project, and shall not be loaned, copied, or reproduced in any form without expressed written consent from Triad Design Group, PC. Copyright © 2021, Triad Design Group, PC. All rights reserved.
 Triad Design Group, PC, shall not be responsible for construction means, methods, techniques, or procedures utilized by the contractor, nor for the safety of public or contractor's employees, nor for the failure of the contractor to carry out the work in accordance with the contract documents.

RSF:
3,465 SF

Issue Type:
As Built