


**DIVISION WALL  
(CAN BE REMOVED)**

**10451 W. JEFFERSON BOULEVARD  
CULVER CITY, CA 90232**

**AS BUILT  
FIRST FLOOR – FLOOR PLAN**

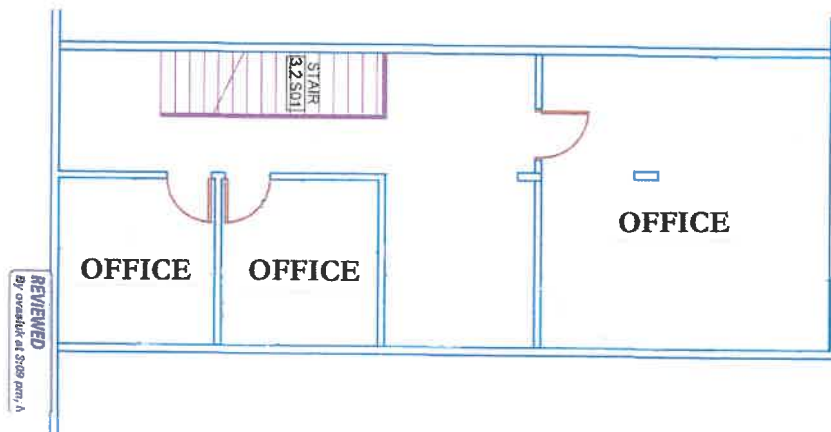

REVIEWED  
By: *overstake at 3:09 pm, 11*

10451 W. JEFFERSON BOULEVARD  
CULVER CITY, CA 90232

AS BUILT

SECOND FLOOR - FLOOR PLAN