


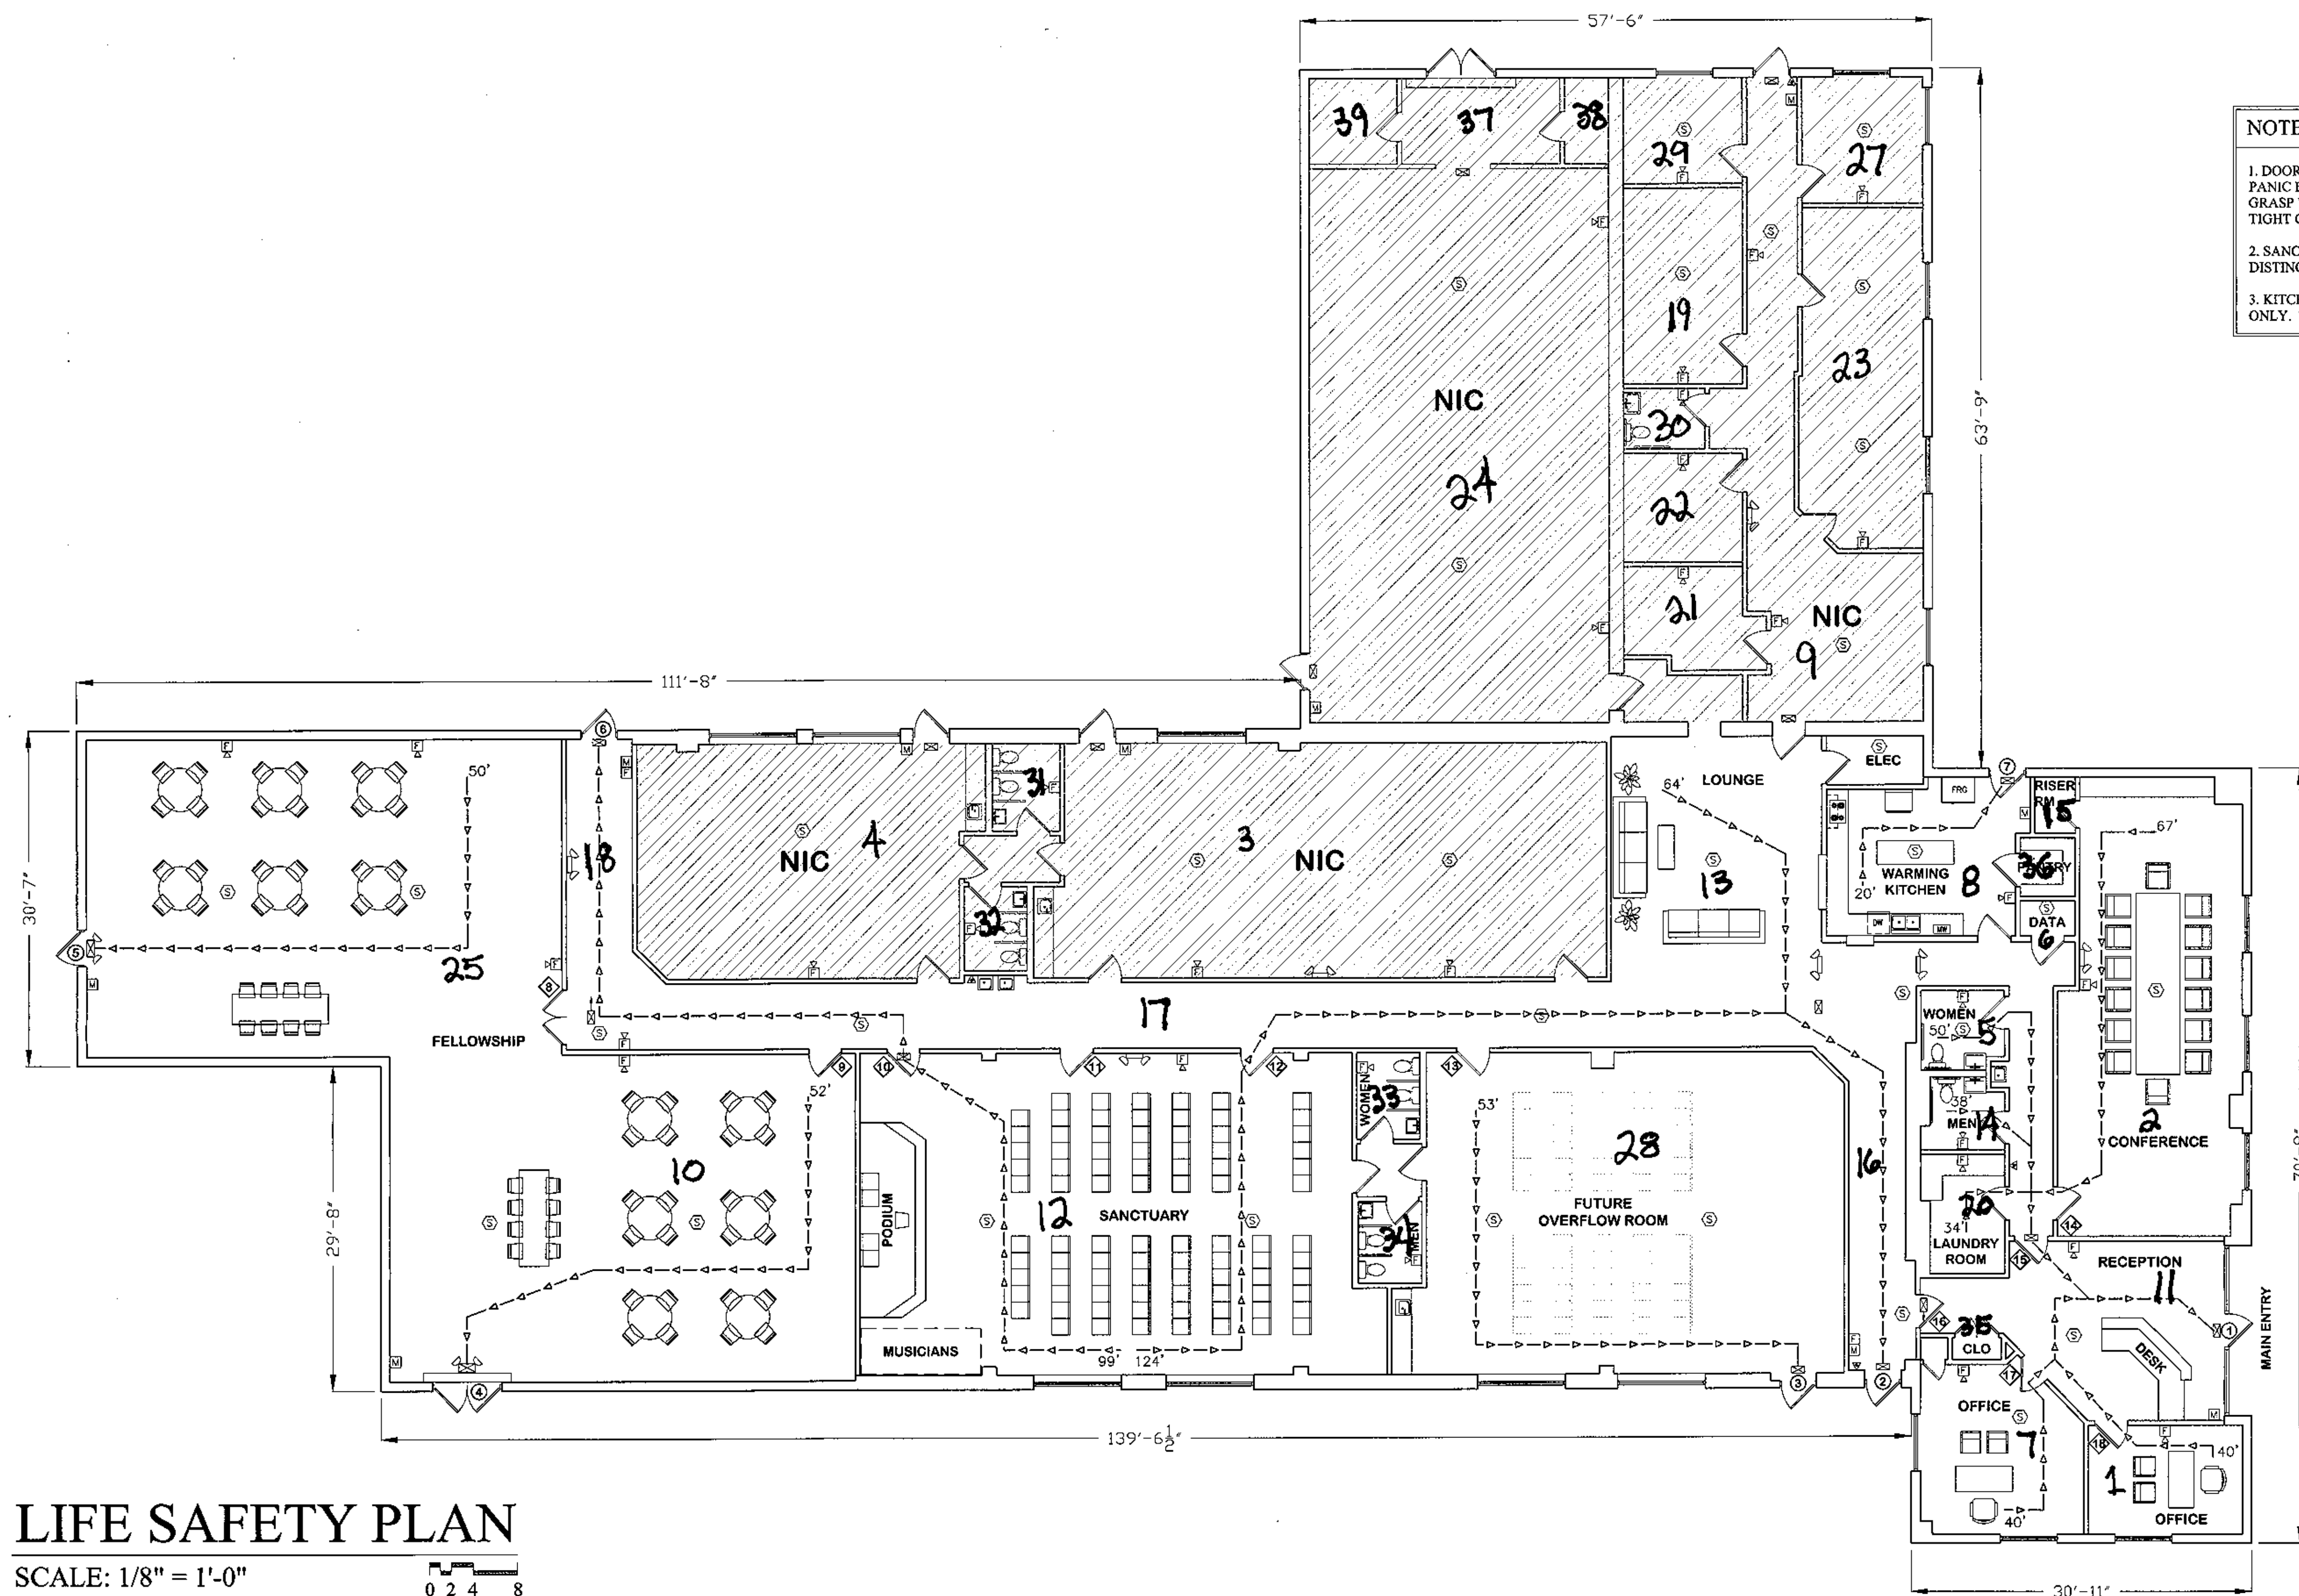

NOTES:


- DOORS SHALL BE LEVER TYPE HARDWARE, OR PANIC BARS, HAVING A SHAPE THAT IS EASY TO GRASP WITH ONE HAND AND DOES NOT REQUIRE TIGHT GRASPING.
- SANCTUARY TO MAINTAIN CLEAR AND DISTINGUISHABLE PATHS OF EGRESS
- KITCHEN TO BE USED AS WARMING STATION ONLY. THERE WILL BE NO COOKING.

Legend:

- EXISTING WALLS
- EXISTING DOORS
- EXISTING WINDOWS
- FIRE EXTINGUISHER
- LIGHTED EXIT SIGN
- EMERGENCY LIGHTS (BATTERY BACK-UP)
- EMERGENCY LIGHTS
- MANUAL PULL ALARM
- HORN STROBE
- SMOKE DETECTOR
- DOOR IDENTIFICATION NUMBERS (EXTERIOR)
- DOOR IDENTIFICATION NUMBERS (INTERIOR)

MAXIMUM TRAVEL TO NEAREST EXIT
TRAVEL DISTANCE
TRAVEL DIRECTION

LIFE SAFETY PLAN
SCALE: 1/8" = 1'-0"

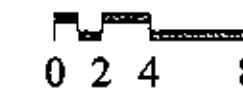

Emmanuel Haitian Church

1719 Redan East
Lithonia, Georgia 30058

APPROVAL SIGNATURE AND STAMP OF
COUNTY FIRE INSPECTOR
DATE: 3-2-15
BY: [Signature]
DEKALB COUNTY FIRE INSPECTION OFFICE

DEPT. OF PLANNING AND SUSTAINABILITY
CONSTRUCTION PLANS REVIEW DIVISION
No structural modifications were reviewed or
permitted on this plan. However, if during
the course of inspections the floor plan, as
submitted for review, is in conflict with the
actual floor space, a revised plan will be
required for re-submission and review.

AS-BUILT

Architect:
SCOTT D. HALE
ARCHITECT
2771 Lawrenceville Hwy
Suite 205
Decatur, GA 30033
Contact:
Scott D. Hale
(770) 939 9446



Drawn By:
CAD Specialist
EXPERIENCED CAD SUPPORT
P.O. Box 2108
Decatur, GA 30031
Contact:
Mary Alexander
(404) 377 6886

Project:
Emmanuel Haitian Church

1719 Redan East
Lithonia, Georgia 30058
Contact:
Raymond Saint-Amour
(678) 480 7081