


NOTE: ALL DIMENSIONS ARE APPROXIMATE BASED ON THE SKETCH PROVIDED AND THE AS-BUILT CONDITIONS MEASURED IN PLACE. EXACT MEASUREMENTS MUST BE FIELD VERIFIED.

TOTAL UNIT SQUARE FEET = 920sq.

SHEET #

1 OF 1

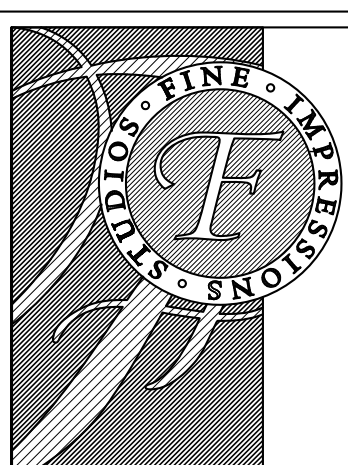

**FINE IMPRESSIONS STUDIOS**  
**DRAFTING & DESIGN**  
*Jeffrey M. Wilson*  
 920 59th Street West  
 Bradenton, FL 34209  
 941.526.6508

TITLE:

2704 14th Street West  
 Bradenton, Florida 34205

TO THE BEST OF THE DESIGNER'S KNOWLEDGE, THE DESIGN REPRESENTED BY THESE DRAWINGS CONTAINS ALL PERTINENT INFORMATION AS REQUESTED BY THE CLIENT AND FOUND EXISTING ON SITE.

ALL RIGHTS RESERVED. NO PART OF THESE PLANS IS TO BE REPRODUCED OR TRANSMITTED IN ANY FORM OR BY ANY MEANS, ELECTRONIC OR MECHANICAL, INCLUDING PHOTOCOPYING, RECORDING, OR BY ANY INFORMATION STORAGE AND RETRIEVAL SYSTEM, WITHOUT THE WRITTEN APPROVAL OF THE DESIGNER. THESE DRAWINGS REMAIN THE PROPERTY OF THE DESIGNER.

CLIENT:

AS-BUILT DATE:

11/03/'21

FINAL DRAFT:

SCALE:

REVISIONS:

REVISIONS:

DRAFTED BY:

J.M.W.

DESIGNED BY: