


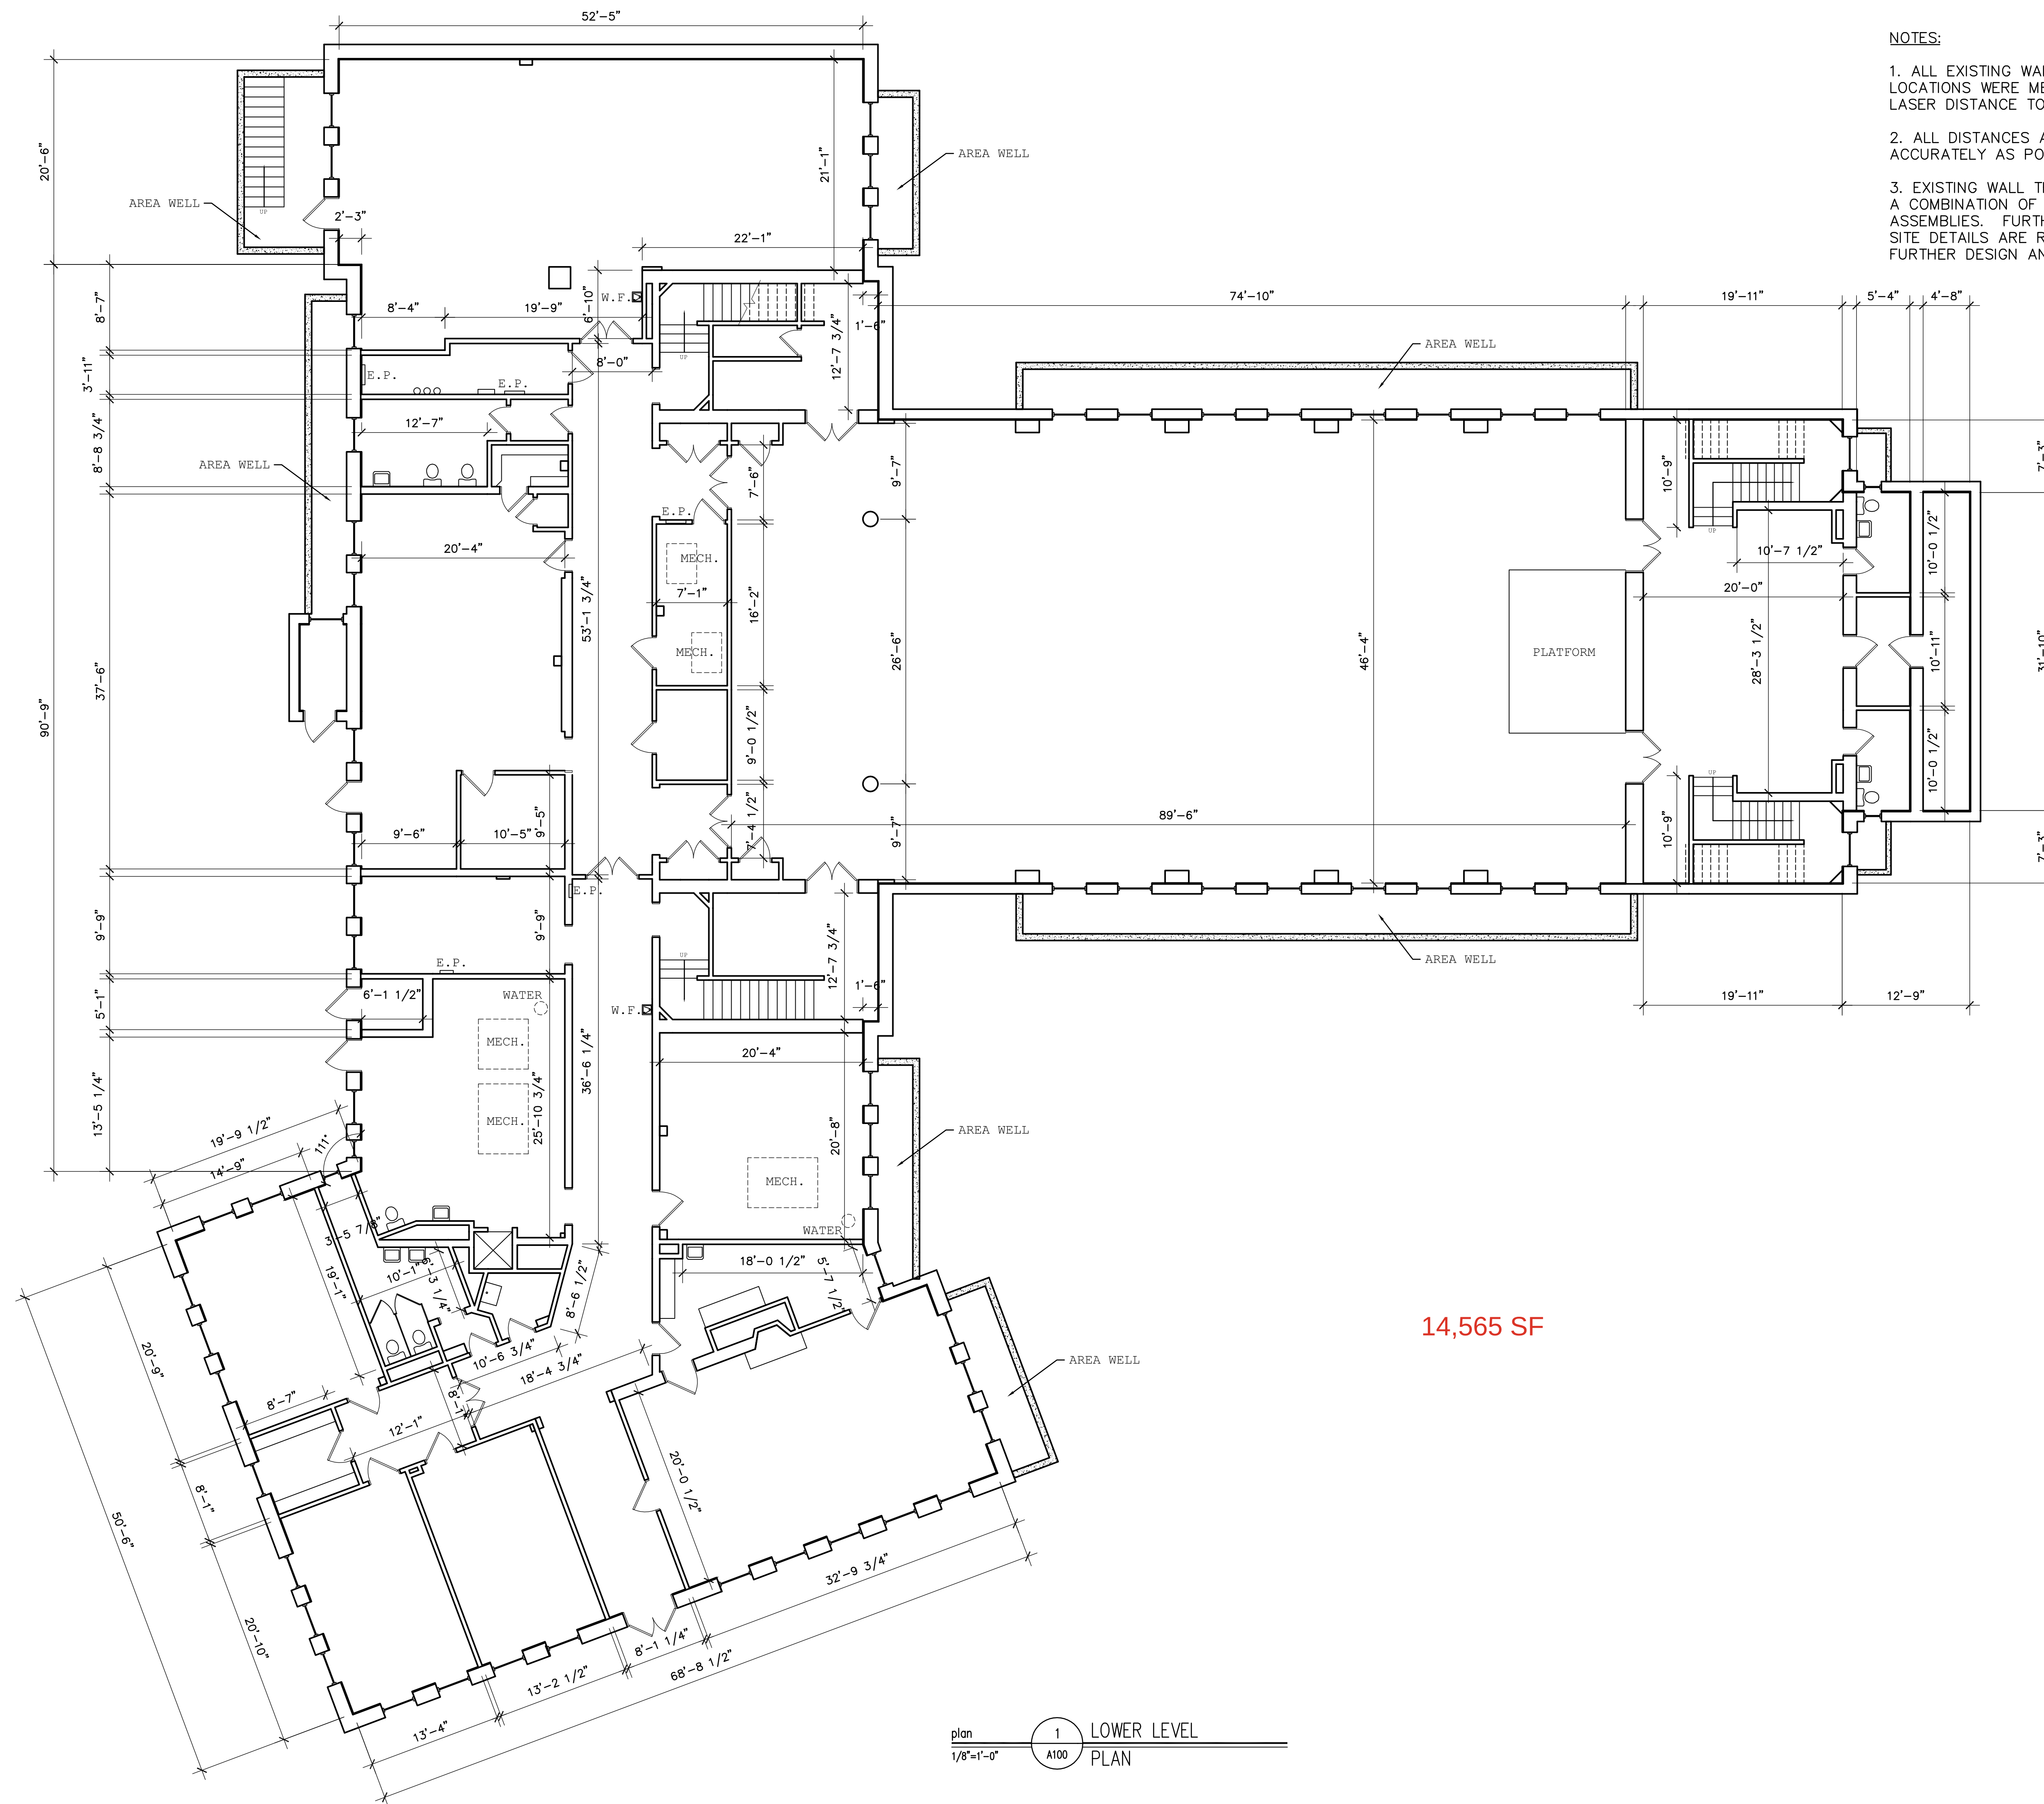


- NOTES:
1. ALL EXISTING WALL, DOOR, AND WINDOW LOCATIONS WERE MEASURED BY USE OF LASER DISTANCE TOOL AND TAPE MEASURE.
 2. ALL DISTANCES ARE ESTIMATED AS ACCURATELY AS POSSIBLE.
 3. EXISTING WALL THICKNESS VARY BASED ON A COMBINATION OF DIFFERENT CONSTRUCTION ASSEMBLIES. FURTHER ASSESSMENT OF ON SITE DETAILS ARE REQUIRED PRIOR TO FURTHER DESIGN AND CONSTRUCTION.



834 INMAN VILLAGE PARKWAY
THE BLUE HORSE , SUITE 280
ATLANTA , GEORGIA 30307
678.244.6270 PH 6272 FX
www.KuoDiedrich.com

SEAL

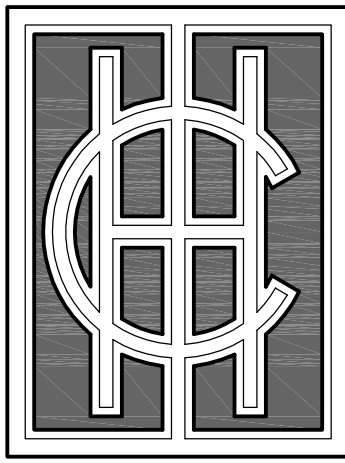

CHI Design Group
Phone (404) 822-6630
Fax (404) 935-9333

08.10.14	ASBUILT SET
DATE	DESCRIPTION

PROJECT

1450 RALPH DAVID
ABERNATHY

PROJ	14000
START	08.25.14
DRAWN	CGK
CHECKED	JC/MAD

TITLE

LOWER LEVEL
PLAN


SHEET

A100



3. EXISTING WALL THICKNESS VARY BASED ON A COMBINATION OF DIFFERENT CONSTRUCTION ASSEMBLIES. FURTHER ASSESSMENT OF ON SITE DETAILS ARE REQUIRED PRIOR TO FURTHER DESIGN AND CONSTRUCTION.



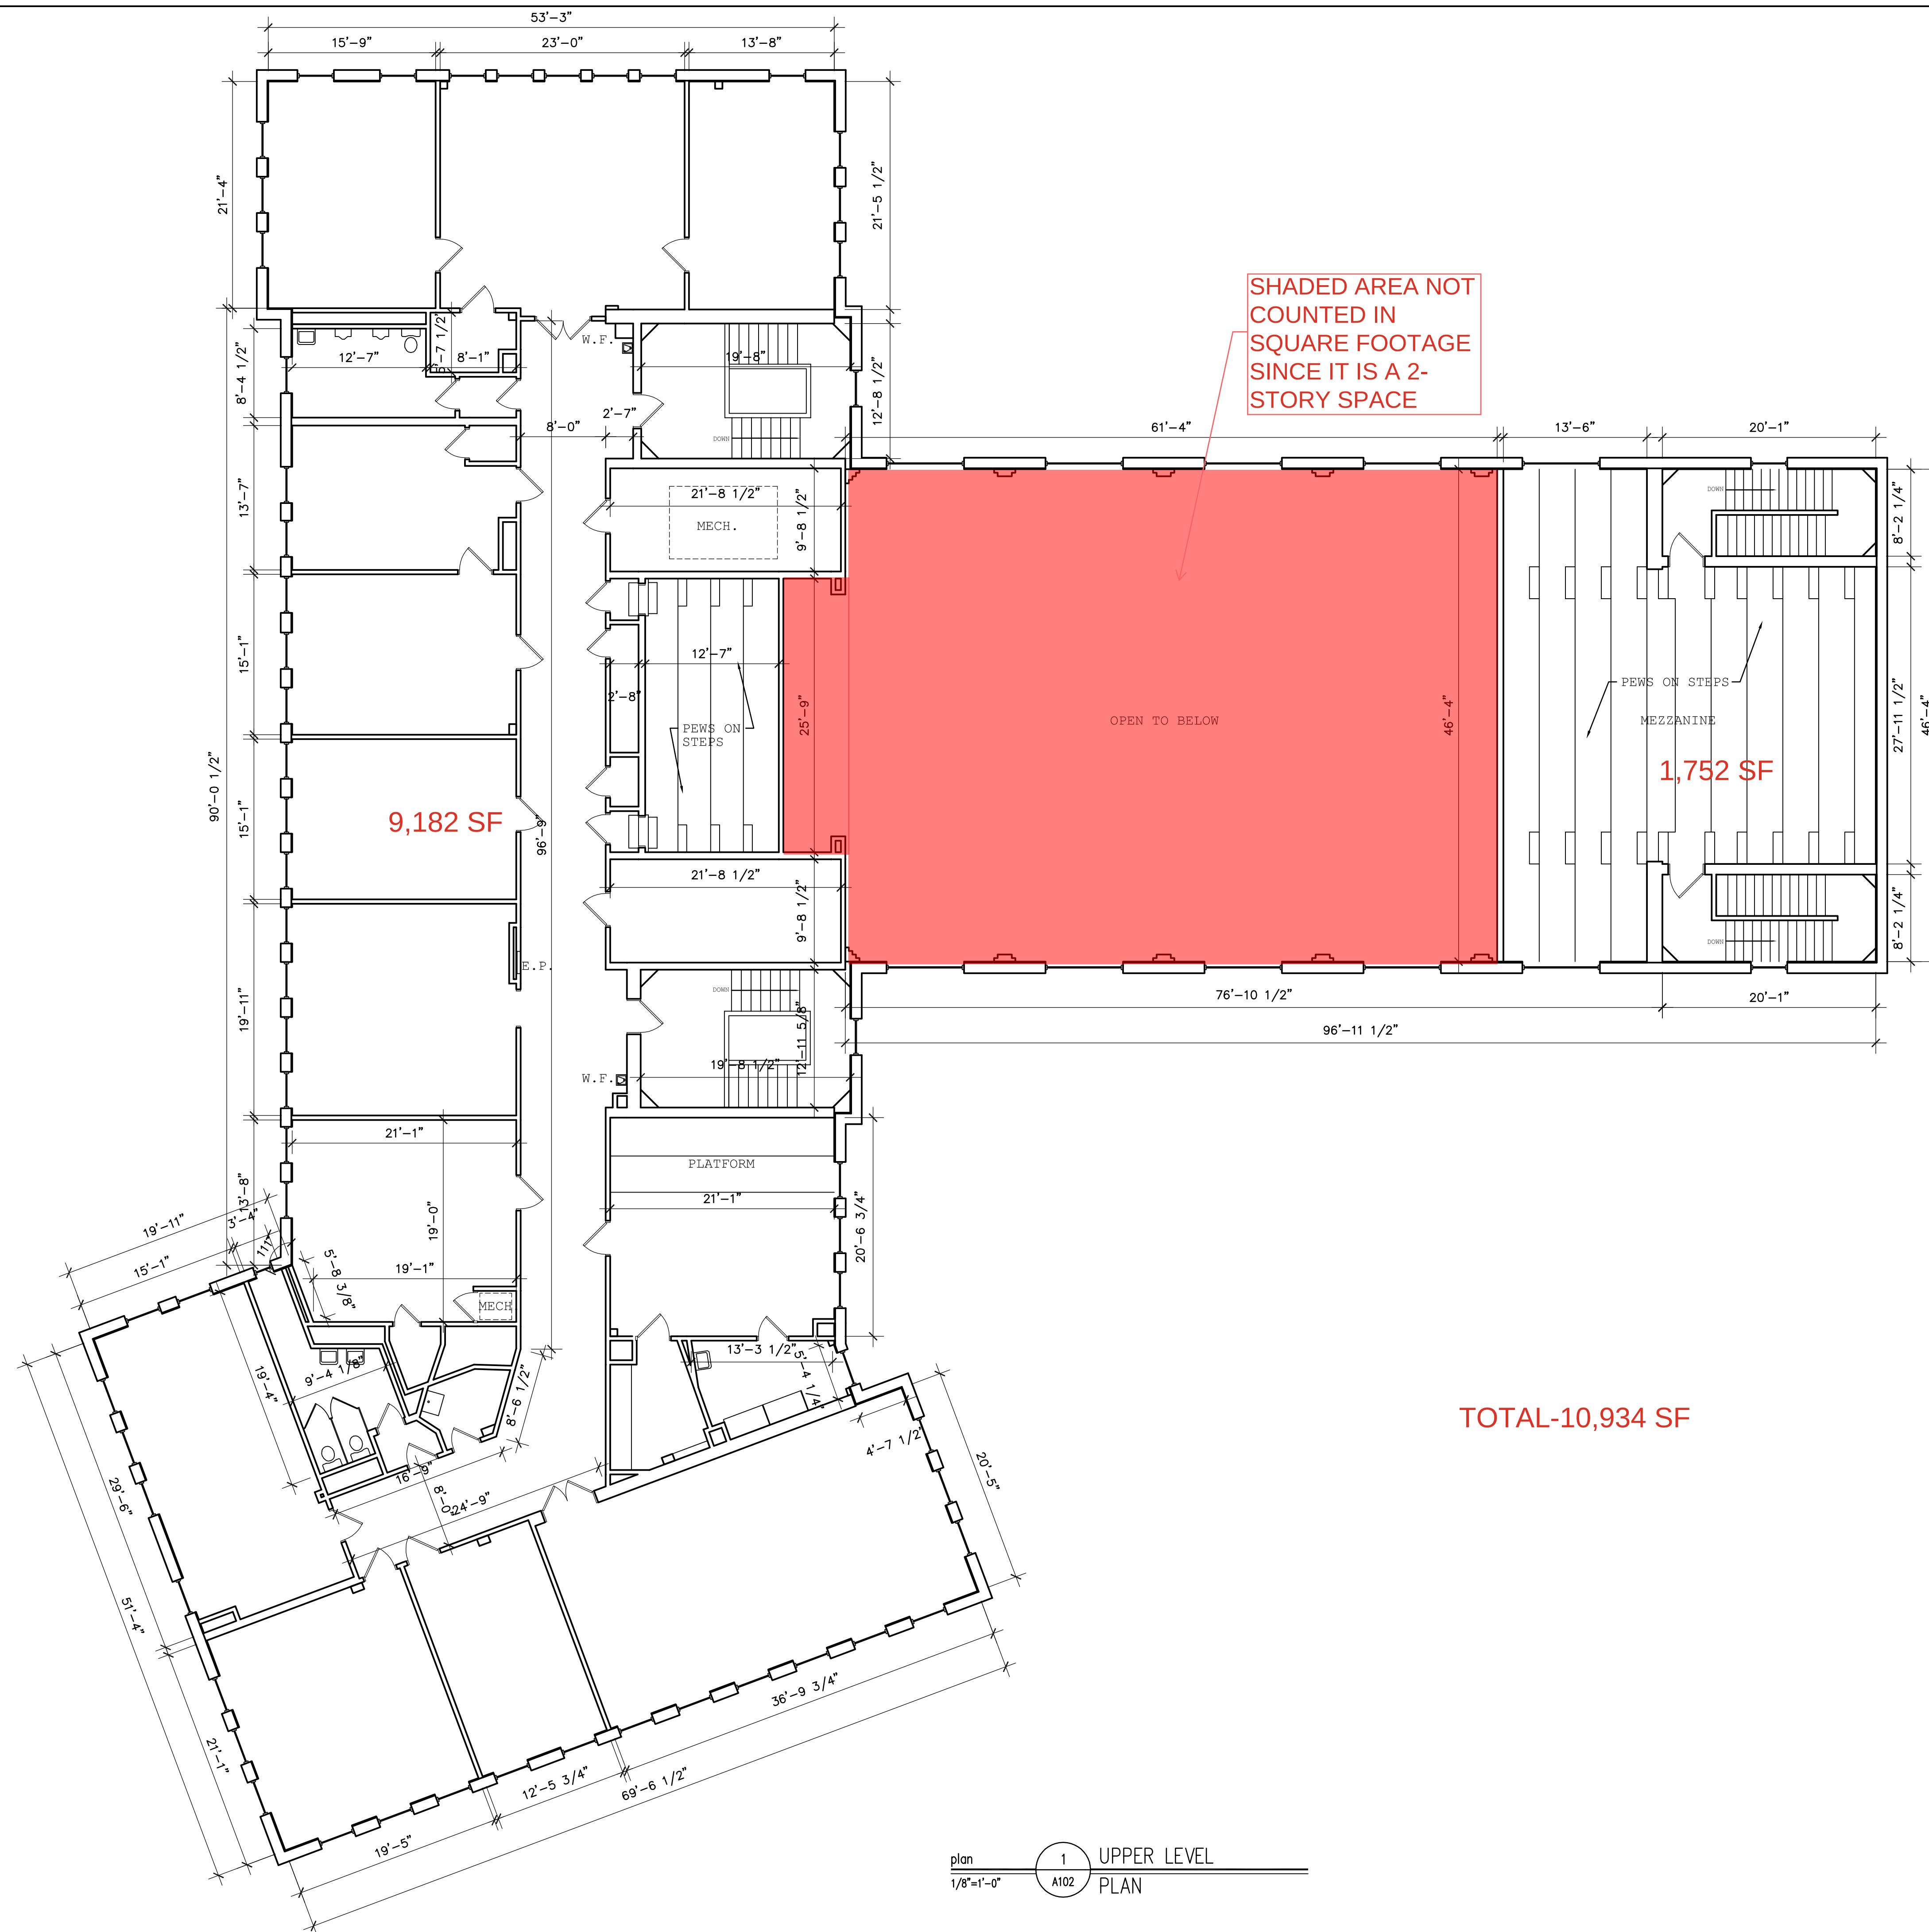


- NOTES:
1. ALL EXISTING WALL, DOOR, AND WINDOW LOCATIONS WERE MEASURED BY USE OF LASER DISTANCE TOOL AND TAPE MEASURE.
 2. ALL DISTANCES ARE ESTIMATED AS ACCURATELY AS POSSIBLE.
 3. EXISTING WALL THICKNESS VARY BASED ON A COMBINATION OF DIFFERENT CONSTRUCTION ASSEMBLIES. FURTHER ASSESSMENT OF ON SITE DETAILS ARE REQUIRED PRIOR TO FURTHER DESIGN AND CONSTRUCTION.



834 INMAN VILLAGE PARKWAY
THE BLUE HORSE , SUITE 280
ATLANTA , GEORGIA 30307
678.244.6270 PH 6272 FX
www.KuoDiedrich.com

SEAL

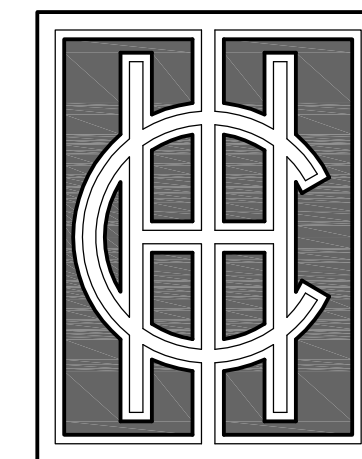

CHI Design Group
Phone (404) 822-6630
Fax (404) 935-9333

08.10.14
DATE

ASBUILT SET
DESCRIPTION

PROJECT

1450 RALPH DAVID
ABERNATHY

PROJ 14000

START 08.25.14

DRAWN CGK

CHECKED JC/MAD

TITLE
MAIN LEVEL
PLAN

SHEET

A102