

Hawes Township Zoning Map

ZONING DISTRICTS



R-1 - Residential District
R-2 - Residential-Lake Shore District
AR - Agricultural-Residential District

Alcona County Michigan

Hawes Township Zoning Map

This map displays the Northeast Michigan Council of Government area, covering parts of Emmet, Cheboygan, and Oscoda counties. It includes the following features:

- Overlay Zones:**
 - F-4 Overlay Zone (Yellow stars)
 - Trask Lake Overlay Zone (Red X's)
 - Hubbard Lake Rd/Ritchie Rd Overlay Zone (Blue X's)
- Land Use Categories:**
 - Lakes (Blue cloud)
 - Roads (Black line)
 - Parcels (White box)
 - Rivers (Blue wavy line)
- Scale:** 0 to 2 miles.
- Adoption Dates:** Adopted: June 14, 2022; Effective: June 29, 2022.
- Map Credits:** Map produced by: Northeast Michigan Council of Government.
- Section Lines:** Section lines are indicated by red lines.

Map produced by:
**Northeast Michigan
Council of Governments**

DISCOVER
 **NorthEast**
 Michigan
 EAST

Rivers
Section 1

A wavy line and a square frame.

Play Zone

Rd Over

Development District

C - Commercial |

Central District

Residential-Lake Shores

R-2 - R
AR - Ag

Michigan

County



Water Well And Pump Record

Completion is required under authority of Part 127 Act 368 PA 1978.


Welloptic

Import IP:

Tax No:	Permit No: 01-04-02	County: Alcona		Township: Hawes	
Well ID: 01000001880		Town/Range: 27N 07E	Section: 1	Well Status: Active	WSSN: 2003001
		Source ID/Well No: 002			
Distance and Direction from Road Intersection:					
1/2 mile West of Hubbard Lake Rd. on the North Side of Mt. Maria.					
Well Owner: Jen & Barts Restaurant					
Well Address: 214 Mt. Maria Rd. Spruce, MI 48762				Owner Address: 60 Ritchie Rd. Lincoln, MI 48742	
Method of Collection: GPS Std Positioning Svc SA Off					

DISTRICT HEALTH DEPARTMENT NO. 2
RECORD OF SEWAGE DISPOSAL SYSTEM FINAL INSPECTION

NAME Shane Atchison (OBA Cruise Inn) SITE ADDRESS 214 MT MARIA rd
TOWNSHIP Hawes COUNTY Arizona Comp # 01588

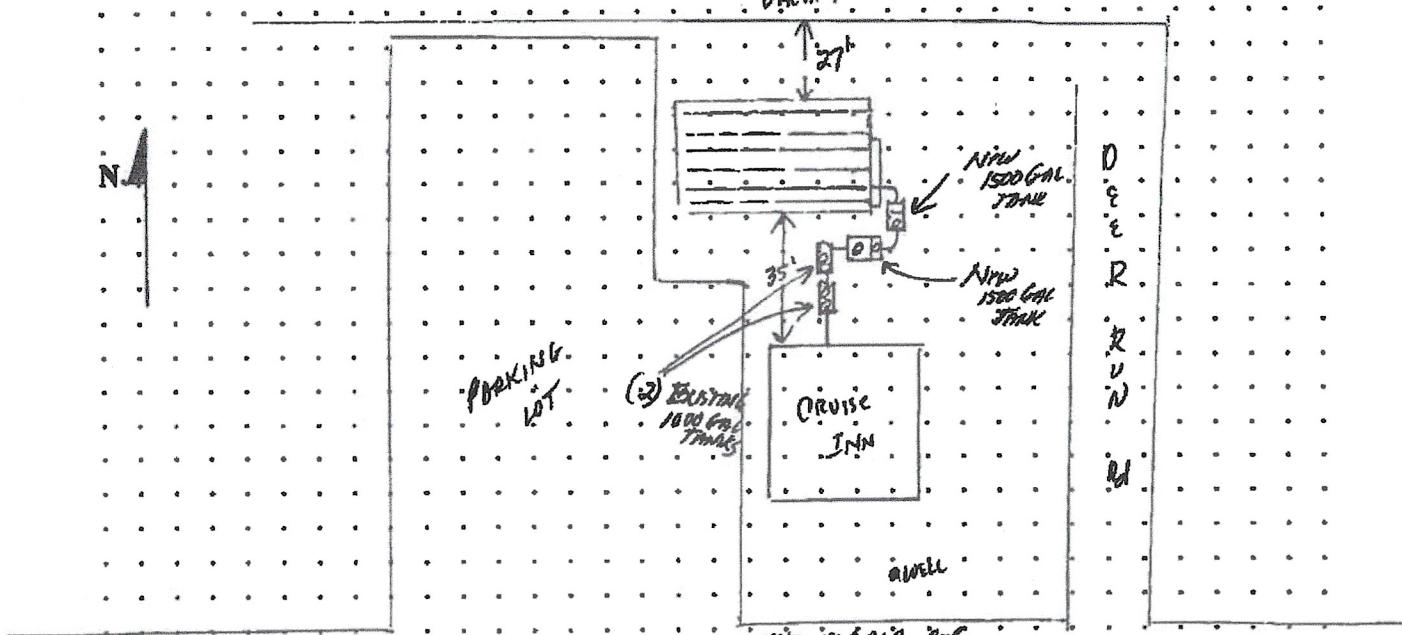

CONTRACTOR: ALPEA SEAPAC (REMY CONSTRUCTION) TANK MFG: GOLDRICK

SEPTIC TANKS: 1ST TANK SIZE 1500 ^{(2) 1000 EXISTING} POLY CONCRETE 2ND TANK SIZE 1500 ^{OC} POLY CONCRETE

PUMPING CHAMBER SIZE: _____ POLY CONCRETE BAFFLE TYPE: PVC CONCRETE

EFFLUENT FILTER: YES NO SIZE/MODEL: ZABUL - A 300

DRAINED TRENCHES BLOCK TRENCH CHAMBER OTHER _____

TOTAL AREA: 2112 **SQ. FT.**

NUMBER OF LINES/TRENCHES: 8 DIMENSIONS: 32 W x 66 L

SEWER LINE TO TANK: EXISTING

SAND FILL AS REQUIRED: N/A

ISOLATION FROM: *Leucosphaera* (L.) Breyne

a. HOUSE TO TANK: _____ TO FIELD: 35'
b. PROPERTY LINE: 27' (North Line)
c. WELLS: 75'
d. SURFACE WATER: n/a

INSTALLED AS DRAWN ON PERMIT AND REFERENCE POINT(S) ACCEPTABLE: YES NO (if no, explain under comments)

COMMENTS: MANHOLE COVERS WERE INSTALLED OVER GABBE ON ALL SEWAGE TRUNKS

APPROVED DENIED

✓ APPROVED

DENIED

INSPECTED BY: *John S. Stetson* DATE: 10-29-04

Word w: septicfomes
Rev. 903

White - Health Dept. Yellow - Copy