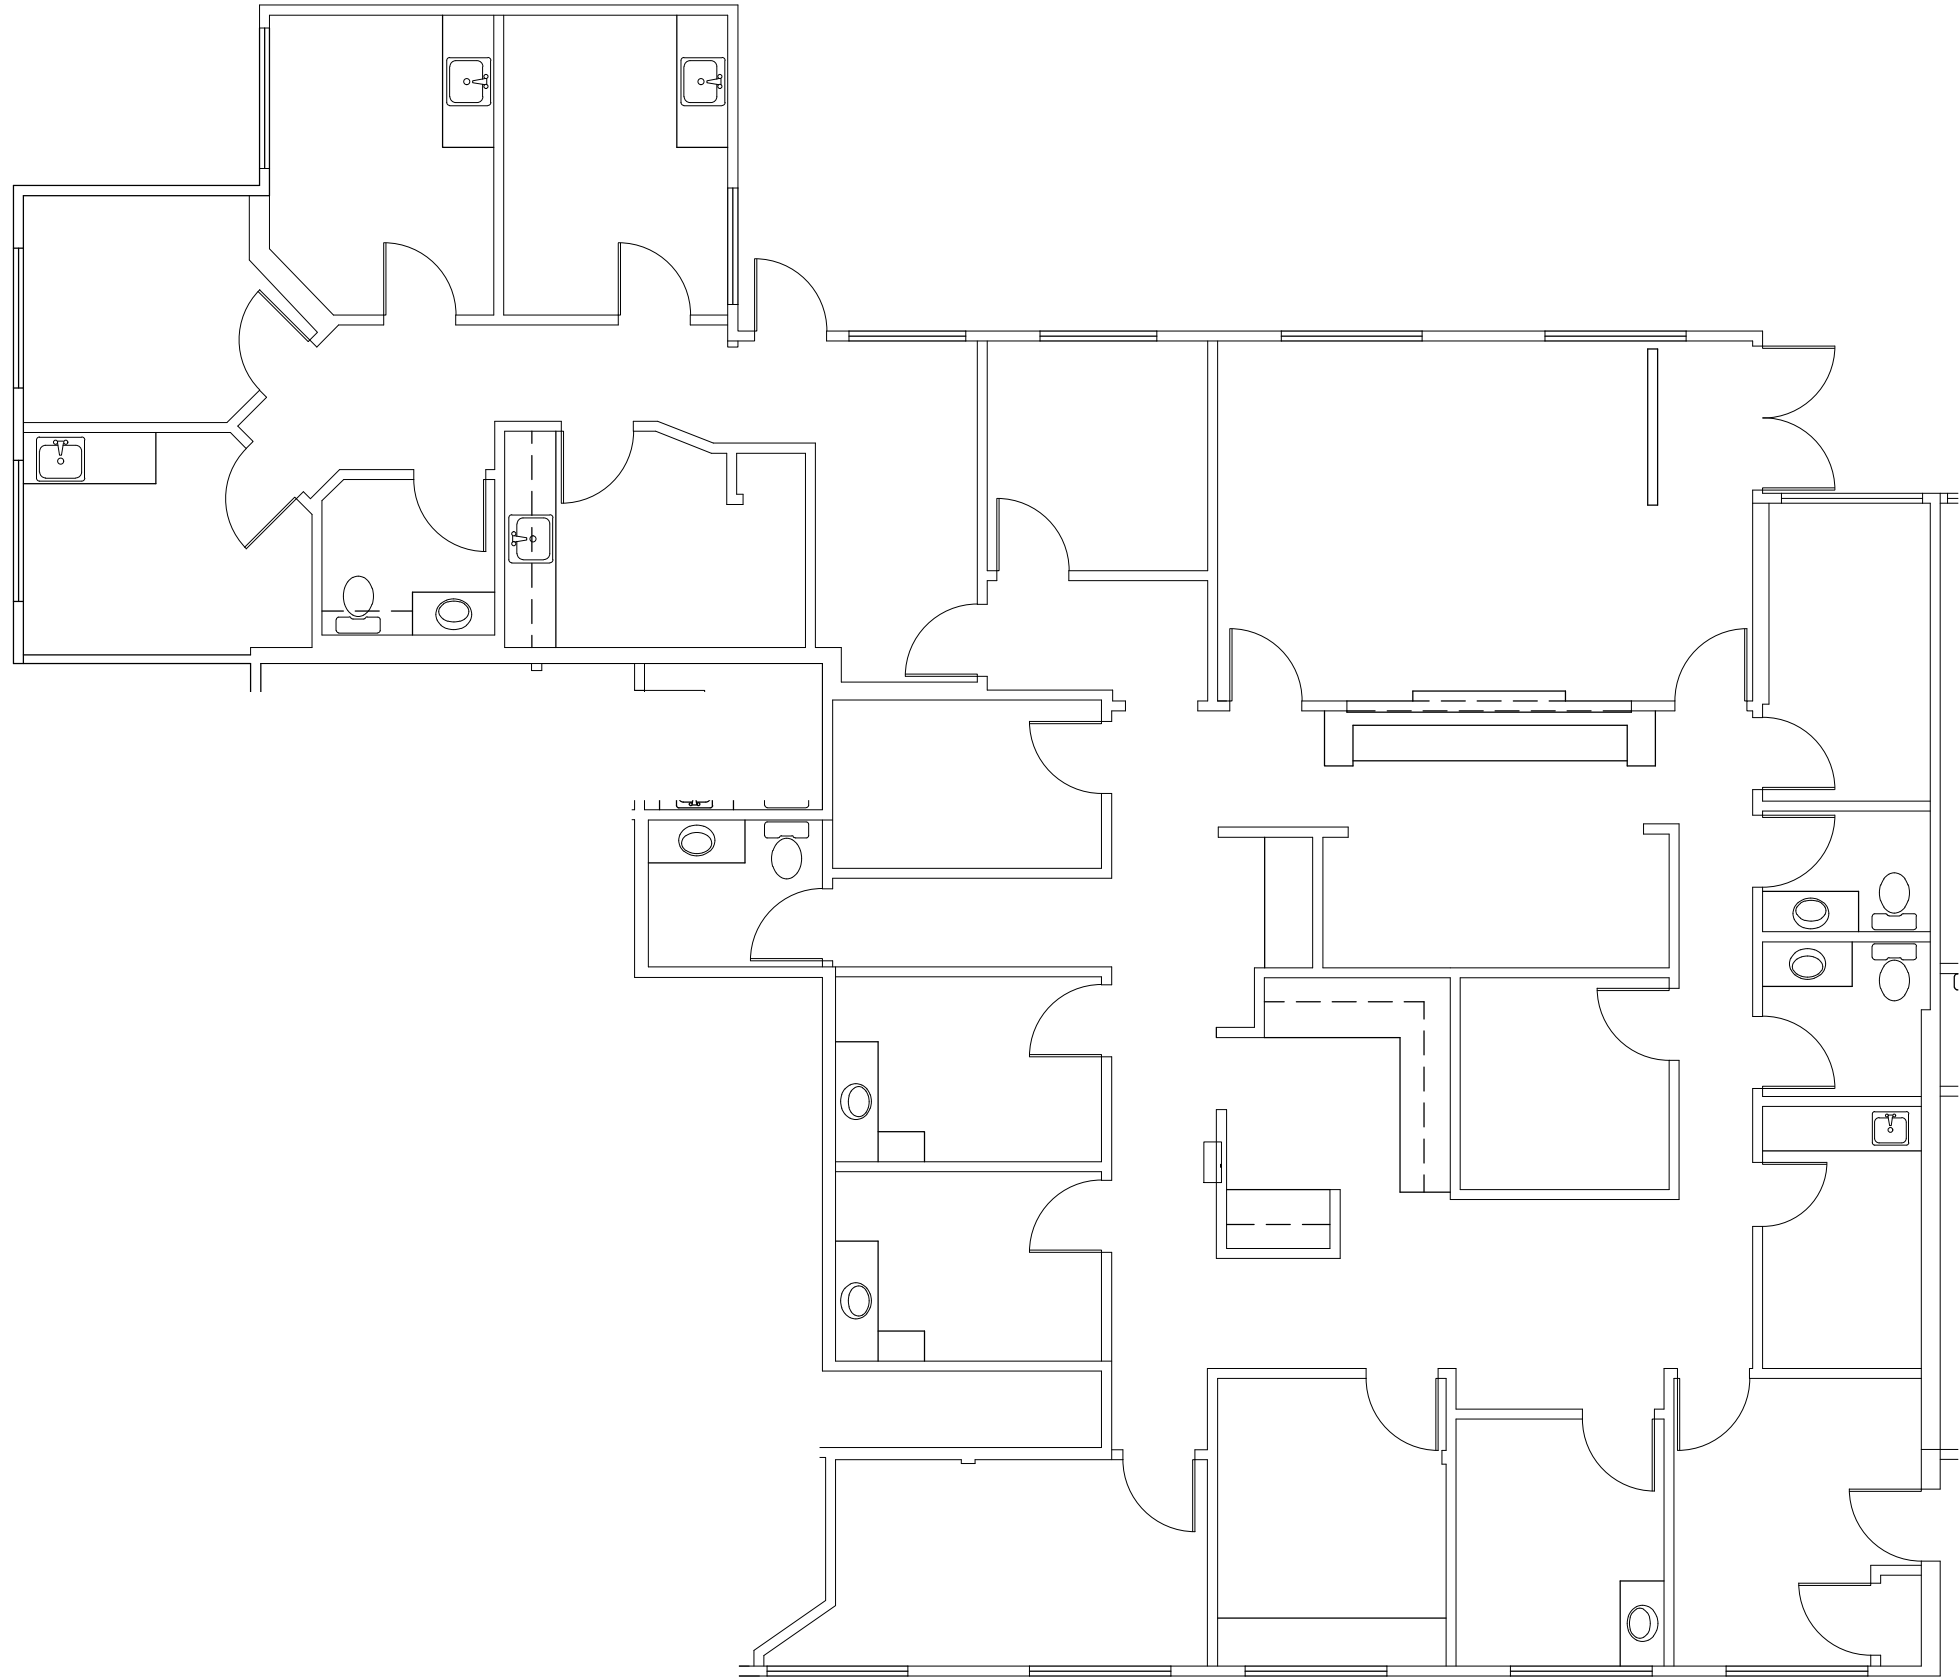


FLOOR PLAN - B2

SCALE: 1/8" = 1'-0"

3,256 SF

AS BUILT FOR:

NEIGHBORHOOD HEALTH BUILDING B, SUITE 2

17175 SW TV HWY., SUITE A1
BEAVERTON, OR 97006

DATE:	05-10-2016
FILE:	2016-14-00
JOB:	2016-14-01
DWN:	CR
CHK:	PK

A1.3

[TKA] space planning/commercial renovation/
interior design/dental/medical

1327 SE Division St.
Portland Oregon 97202
ph: 503 235 0243
fx: 503 546 5698

TONI KING & ASSOCIATES