


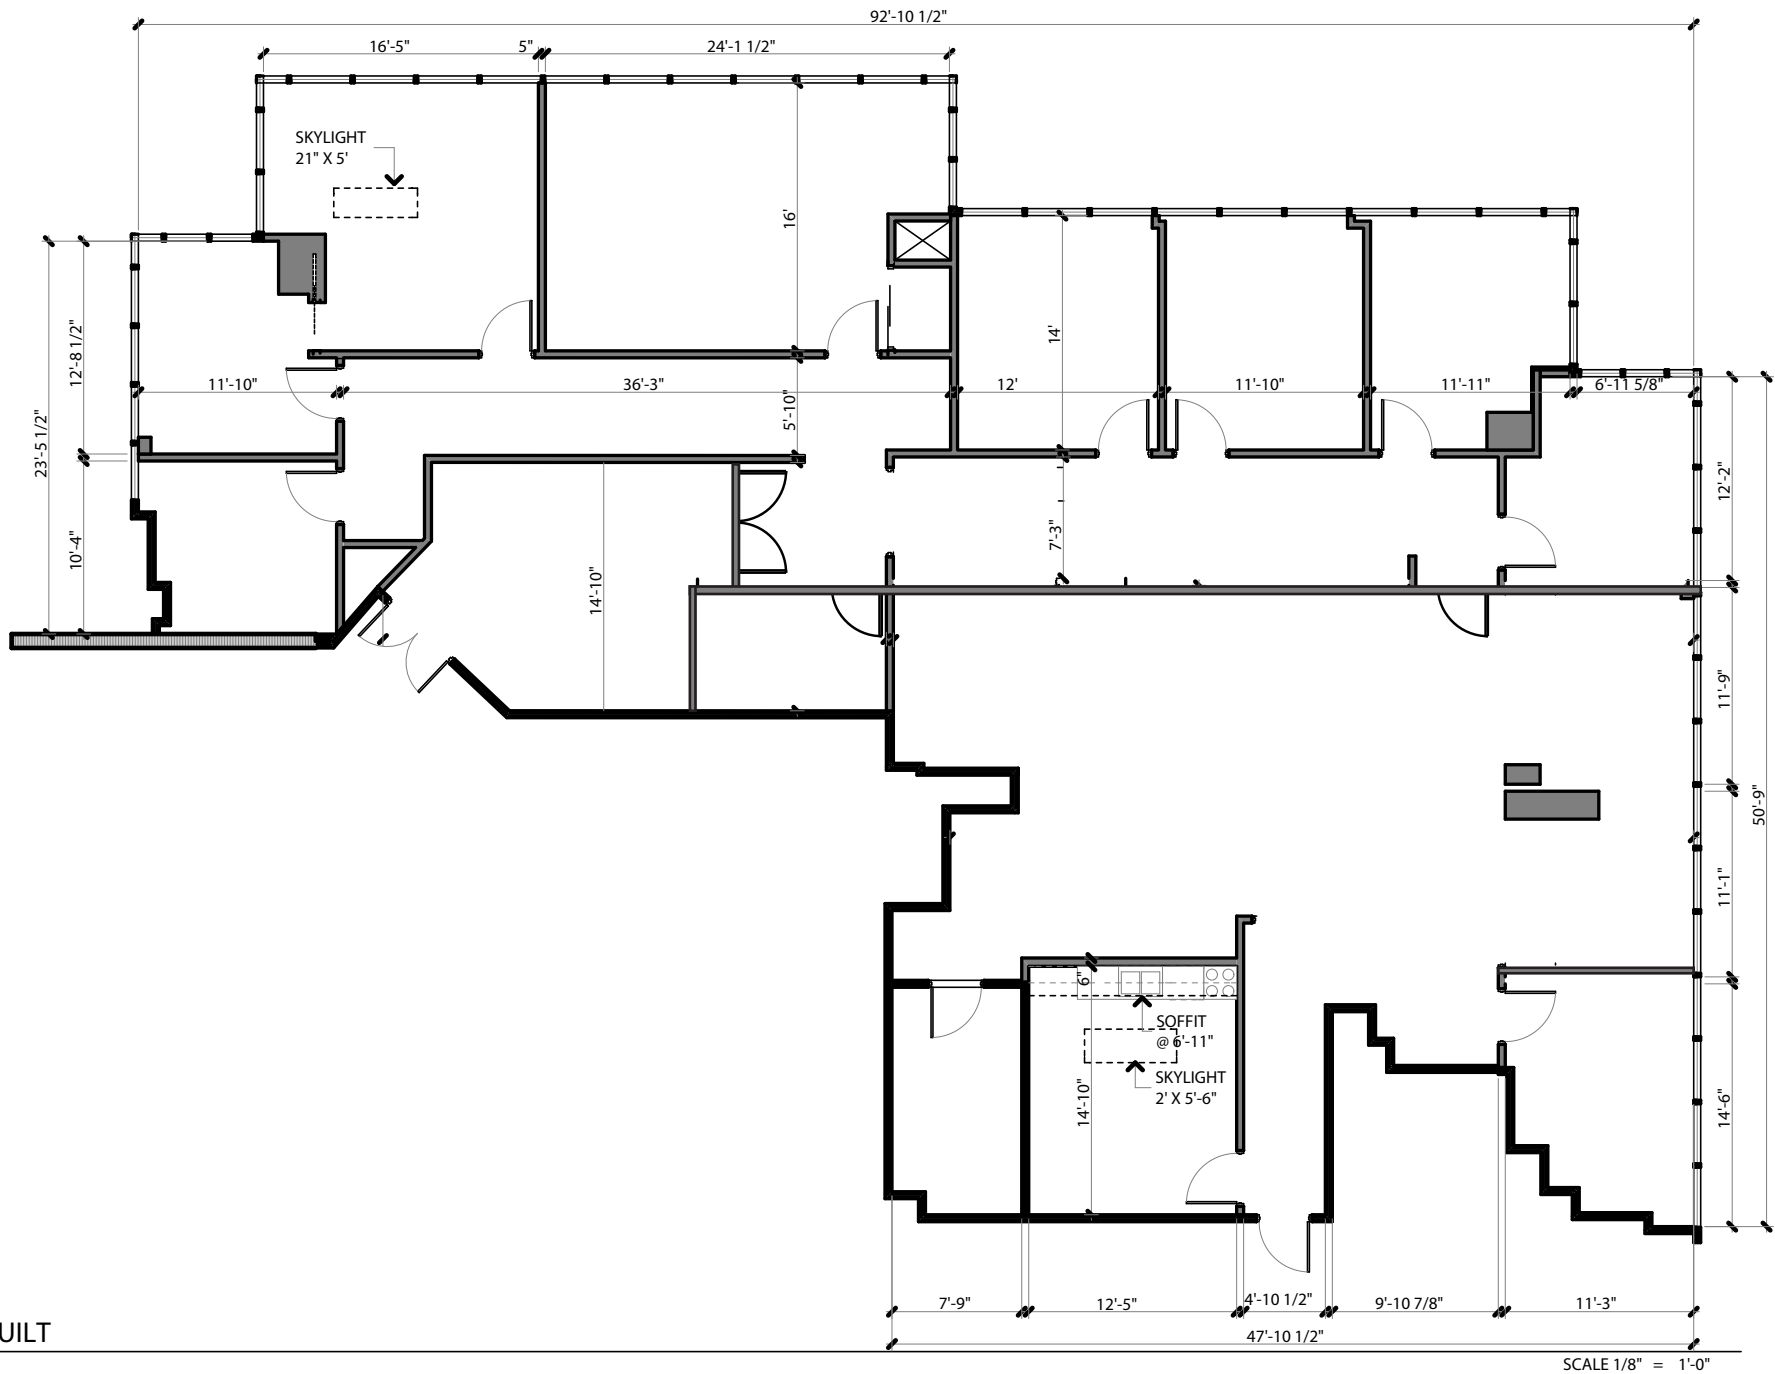

AS-BUILT

SCALE 1/8" = 1'-0"

AS-BUILT

