
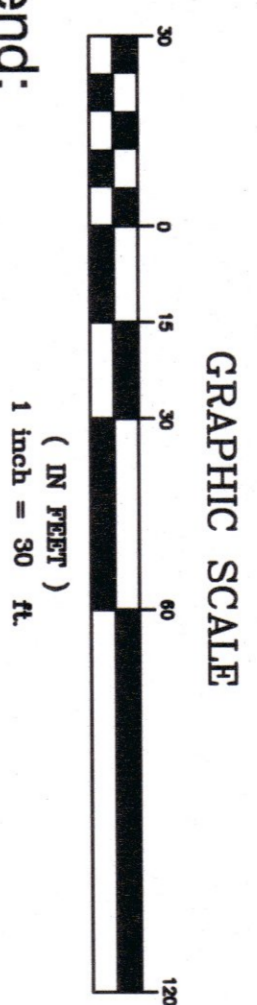


ARBOR LAKE PHASE II WATER AS-BUILT

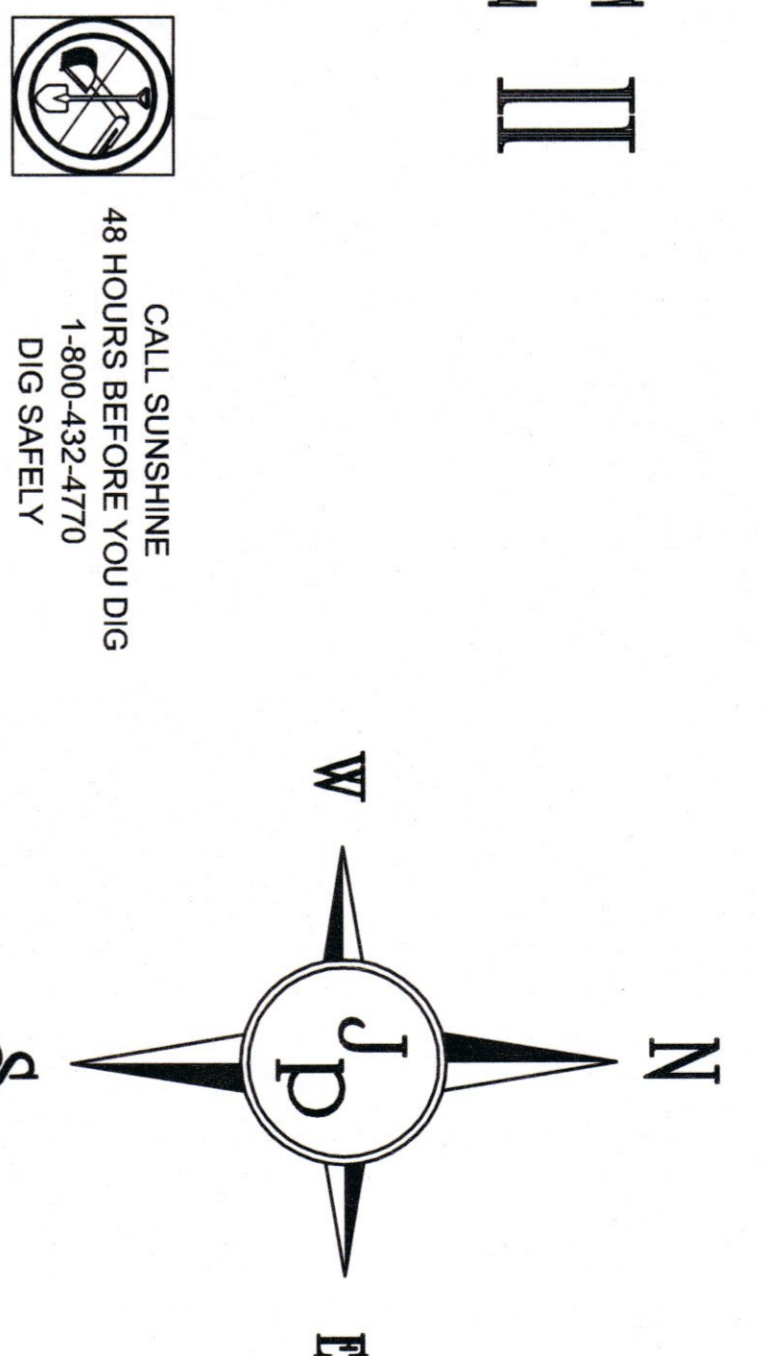

Water As-built Location Legend:

- 100 DENOTES LOCATION OF TWO ~ ONE INCH WATER SERVICES
- 25 6"GV DENOTES LOCATION OF 6" GATE VALVE
- 100 DISTANCE MEASURED FROM THE DOWNSTREAM MANHOLE
- 25 DISTANCE PERPENDICULAR RIGHT OR LEFT OF SEWER MAIN
- 100 DISTANCE MEASURED FROM THE DOWNSTREAM MANHOLE
- 25 DISTANCE PERPENDICULAR RIGHT OR LEFT OF SEWER MAIN

Water As-built Legend:

- 100 SEWER MANHOLE
- 3' SPLIT RAIL WOOD FENCE
- 4' CHAINLINK FENCE
- 6' WOOD PRIVACY FENCE
- WOOD PORCH COLUMN
- CONDOMINIUM BUILDING NUMBER
- LIFT STATION (NET WELL CONTROL PANEL & GRINDER)
- PROPOSED PRIVATE 15' DRAINAGE EASEMENT
- PROPOSED INGRESS/EGRESS & UTILITY EASEMENT (CITY OF CRESTVIEW)
- EXISTING CONCRETE
- EXISTING ASPHALT PAVEMENT
- EXISTING COVERED CONCRETE
- SET CONCRETE MONUMENT
- SET CAPPED IRON ROD LB #7191
- STORM WATER MANHOLE CURB INLET
- STORM WATER INLET
- WATER METER
- WATER VALVE
- FIRE HYDRANT
- WATER SERVICE STUB OUT
- CONCRETE RETAINING WALL (PHASE 2)
- CONCRETE RETAINING WALL (PHASE 1)

Abbreviations:

- # = NUMBER OF SLOPE
- AND
- AT
- 3N = TOWNSHIP 3 NORTH
- D = DEED
- EOP = EDGE OF PAVEMENT EXISTING
- F = FIELD
- GV = GATE VALVE
- INTV = INTERSECTION
- INV = INVERT
- LB = LICENSED SURVEYING & MAPPING BUSINESS
- LF = LINEAR FEET
- LS = LIFT STATION
- MH = MANHOLE
- O.R. = OFFICIAL RECORDS
- P.G. = POLYVINYL CHLORIDE
- P.W. = RIGHT OF WAY
- R/W = RIGHT OF WAY
- SCM = SURVEYOR'S CONCRETE MONUMENT
- SW = SWIFTY SEWER
- TYP = TYPICAL
- WM = WATER MAIN
- WV = WATER VALVE

CONTRACTOR: On Site Construction Company

5808 HIGHWAY 189 N
BAKER, FL 32531
PHONE: (850) 537-8815
CONTACT: MR. REX HOLLEY

