


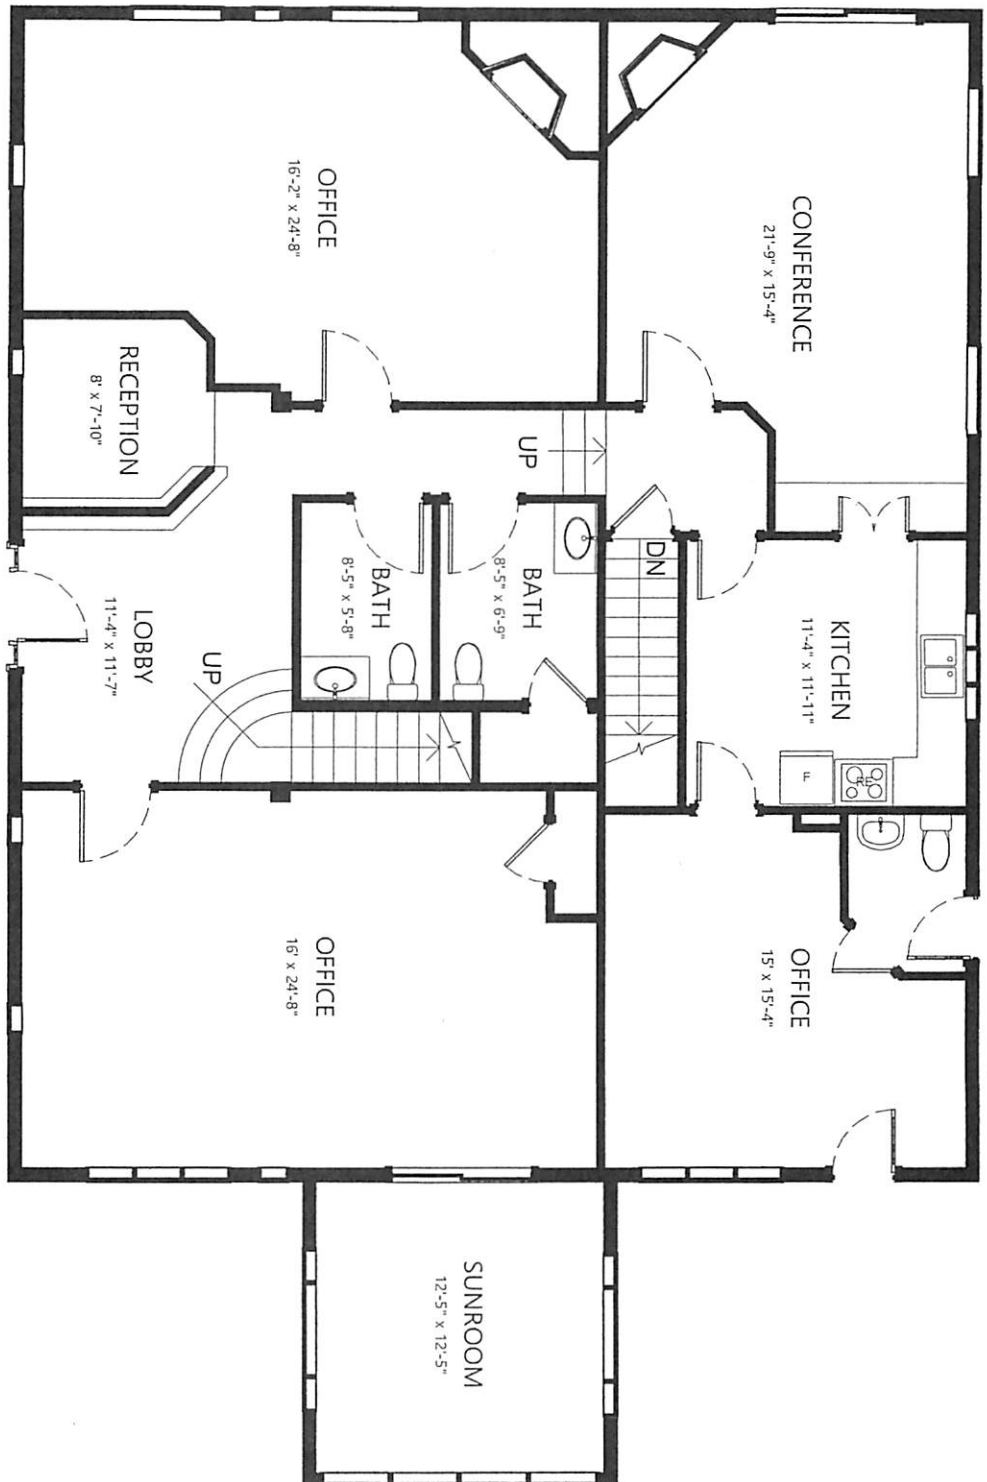

1

Ground Floor

1/8" = 1'-0"




MAIN FLR	2,130 SF
UPPER FLR	1,150 SF
TOTAL	3,280 SF

Rocky Mountain Conservancy
Field Institute
 1895 Fall River Rd
 Estes Park CO 80517

Issue:
 As-built
 Date:
 4/2/2021

Sheet Title:
 Plan
 Sheet No:

A1

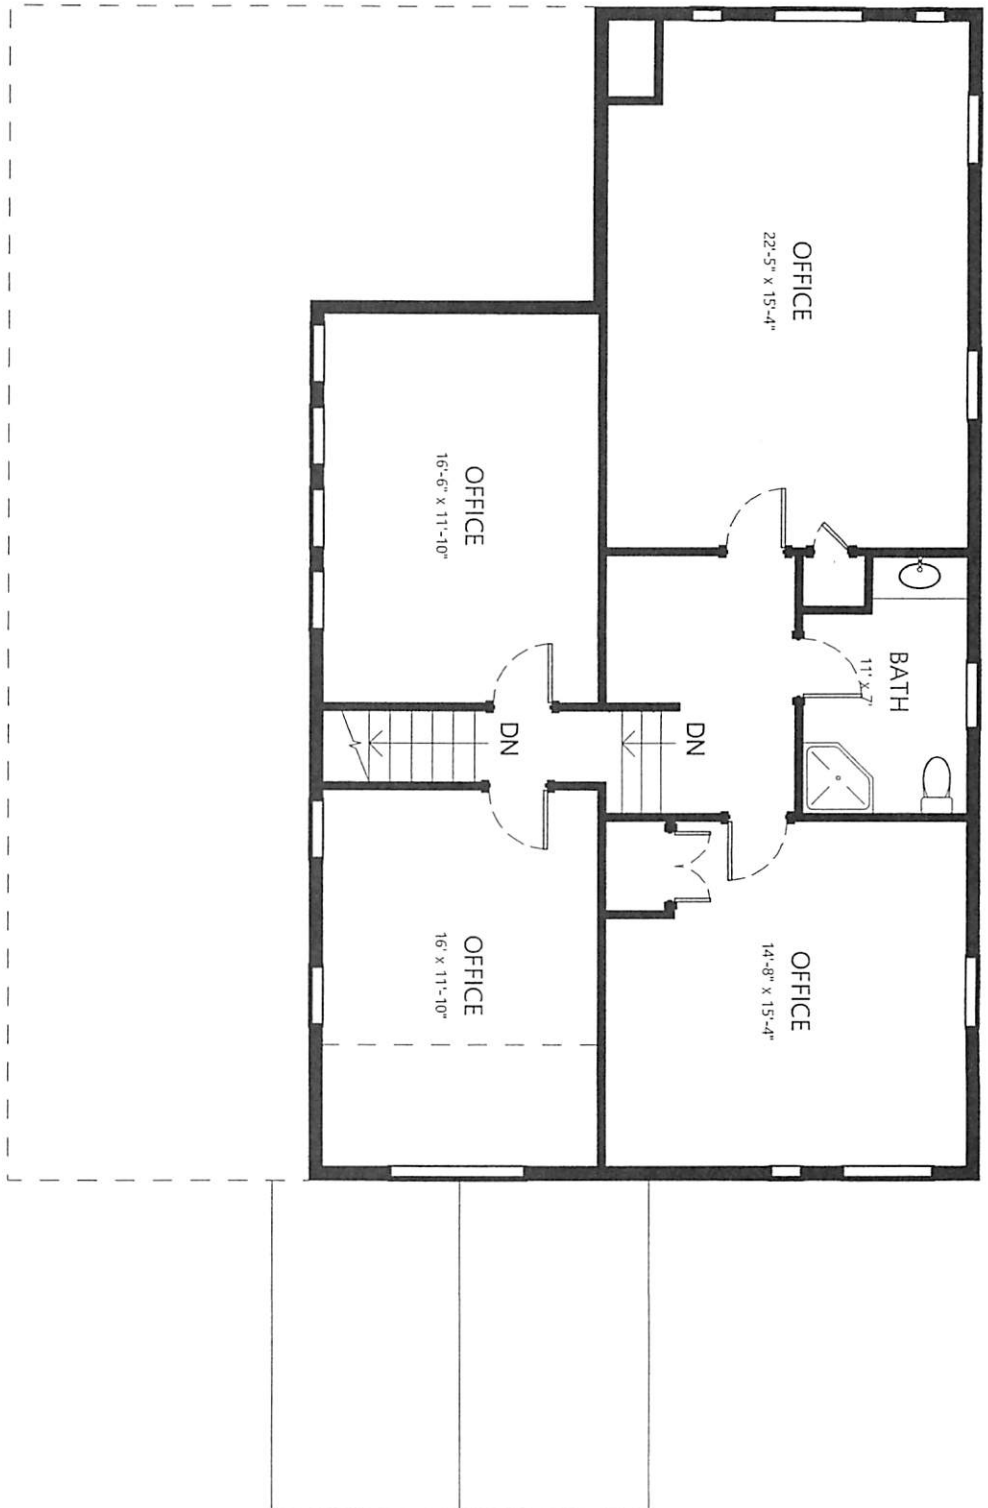

1

Second Floor

1/8" = 1'-0"

**Rocky Mountain Conservancy
Field Institute**
1895 Fall River Rd
Estes Park CO 80517

Issue:
As-built
Date:
4/2/2021

Sheet Title:
2nd Floor Plan
Sheet No:

A2