



A SITE PLAN
SCALE: 1" = 40'-0"
NORTH

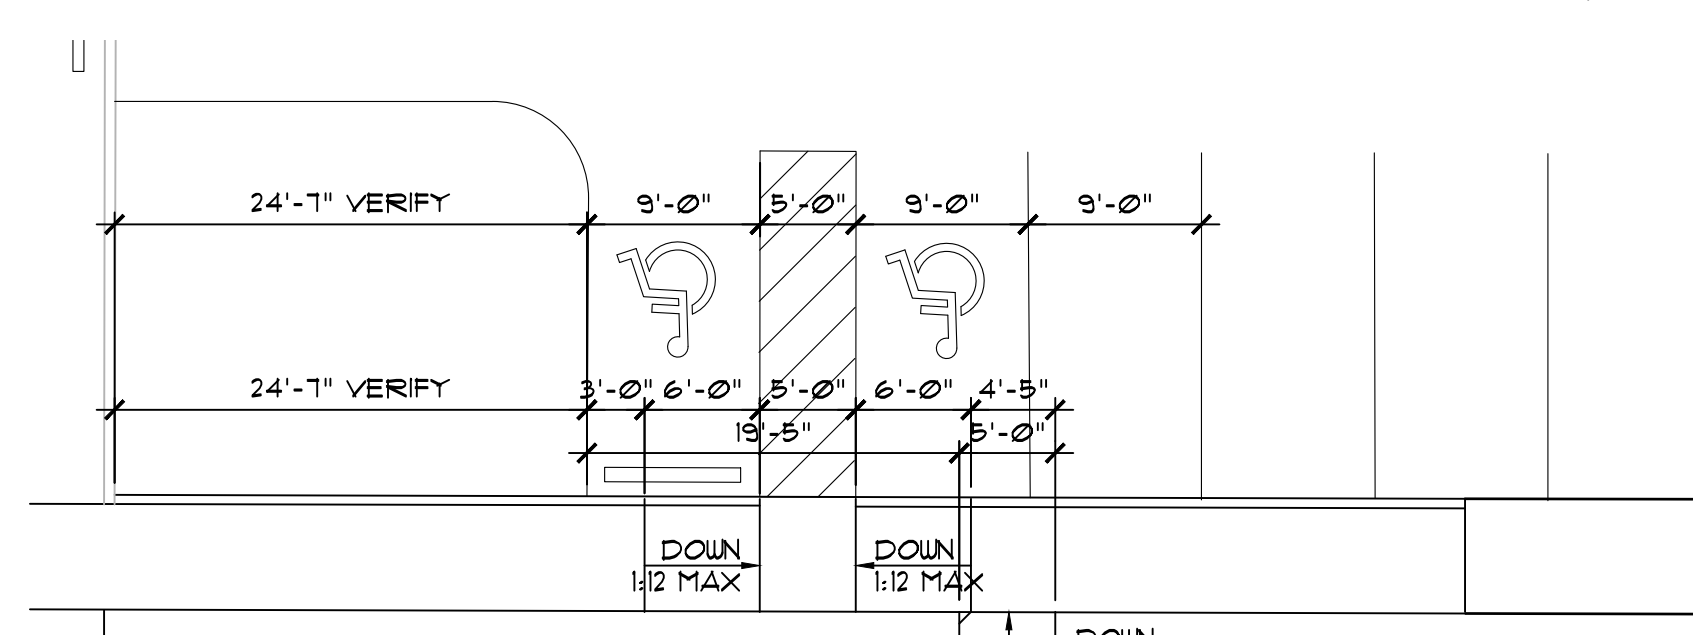

B SITE PLAN
SCALE: 1" = 10'-0"
NORTH

20'-10" VERIFY

DATE	DESCRIPTION
12-03-18	CHANGE ORDER 1
02-08-19	SITE REVISION
02-26-19	TEMPORARY TRAILER ADDITION
03-08-19	SITE VERIFICATION FENCE - EXIT
03-22-19	CONCRETE PAVING APRON ADDITION
03-29-19	BAE REVISION
04-15-19	BAE REVISION
04-15-19	BAE REVISION
08-27-19	AS-BUILT REVISION

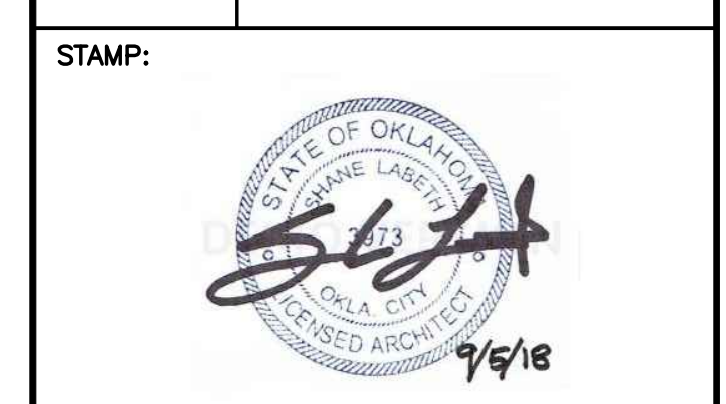

CORNERSTONE
ARCHITECTURE

1601 S W 89TH SUITE G100
OKLAHOMA CITY, OK 73159

P: (405) 609-6161
F: (405) 401-6810

COPYRIGHT © 2017
CORNERSTONE ARCHITECTURE
ALL RIGHTS RESERVED

2017 ADDITION/REMODEL
BAE SYSTEMS
ELGIN, OKLAHOMA

JOB SITE ADDRESS:
200 INDUSTRIAL BOULEVARD
ELGIN, OK 73638

OWNER:
BAE SYSTEMS
200 INDUSTRIAL BOULEVARD
ELGIN, OK 73638

JOB NUMBER:
1705

DRAWN BY: _____ CHECKED BY: _____

SHEET TITLE:
**ARCHITECTURAL
SITE PLAN**

DATE:
SEPTEMBER 5, 2018

SHEET NUMBER:
A-101