



Brighton Park Shopping Center

118 Brighton Park Boulevard
Frankfort, Kentucky 40601

Property Highlights

- +/-104,386 SF community center shadow-anchored by a top performing Kroger in the region
- +/-3,200 - 34,464 SF for lease
- Potential new anchor space available with +/-135 SF of frontage currently in place
- Center has undergone significant capital improvements over the last 18 months
- Excellent visibility on US Hwy 60 in Frankfort, 1 mile from I-64
- Tenants include Ace Hardware, Great Cilps, Modern Nails and more
- Area retailers include McDonald's, Arby's, Auto Zone, Advanced Auto Parts, Penn Station, Save-a-Lot, White Castle, Dollar General, Dollar Tree, Walgreen's and more
- Traffic count of +/-22,556 on US Highway 60 near the site
- Pylon signage opportunities available

Suite

Size

Suite 104	20,000 SF
Suite 110	3,200 SF
Suite 114	9,030 - 21,074 SF
Suite 116	9,225 - 34,464 SF
Suite 118	5,972 - 34,464 SF
Suite 132	7,223 - 34,464 SF

Proposed Outparcel 0.5 Acres

For More Information

Paul Ray Smith, Jr

Executive Vice President

O: 859 224 2000

prsmith@naiisaac.com | KY #183529

Zach Smith, CCIM

Senior Associate

O: 859 224 2000

zachsmith@naiisaac.com





Commercial Real Estate Services, Worldwide.


For Lease

3,200 - 34,464 SF | Negotiable
Retail Space



NO WARRANTY OR REPRESENTATION, EXPRESS OR IMPLIED, IS MADE AS TO THE ACCURACY OF THE INFORMATION CONTAINED HEREIN, AND THE SAME IS SUBMITTED SUBJECT TO ERRORS, OMISSIONS, CHANGE OF PRICE, RENTAL OR OTHER CONDITIONS, PRIOR SALE, LEASE OR FINANCING, OR WITHDRAWAL WITHOUT NOTICE, AND OF ANY SPECIAL LISTING CONDITIONS IMPOSED BY OUR PRINCIPALS NO WARRANTIES OR REPRESENTATIONS ARE MADE AS TO THE CONDITION OF THE PROPERTY OR ANY HAZARDS CONTAINED THEREIN ARE ANY TO BE IMPLIED.

771 Corporate Drive, Suite 500
Lexington, KY 40503
859 224 2000 tel
naiisaac.com

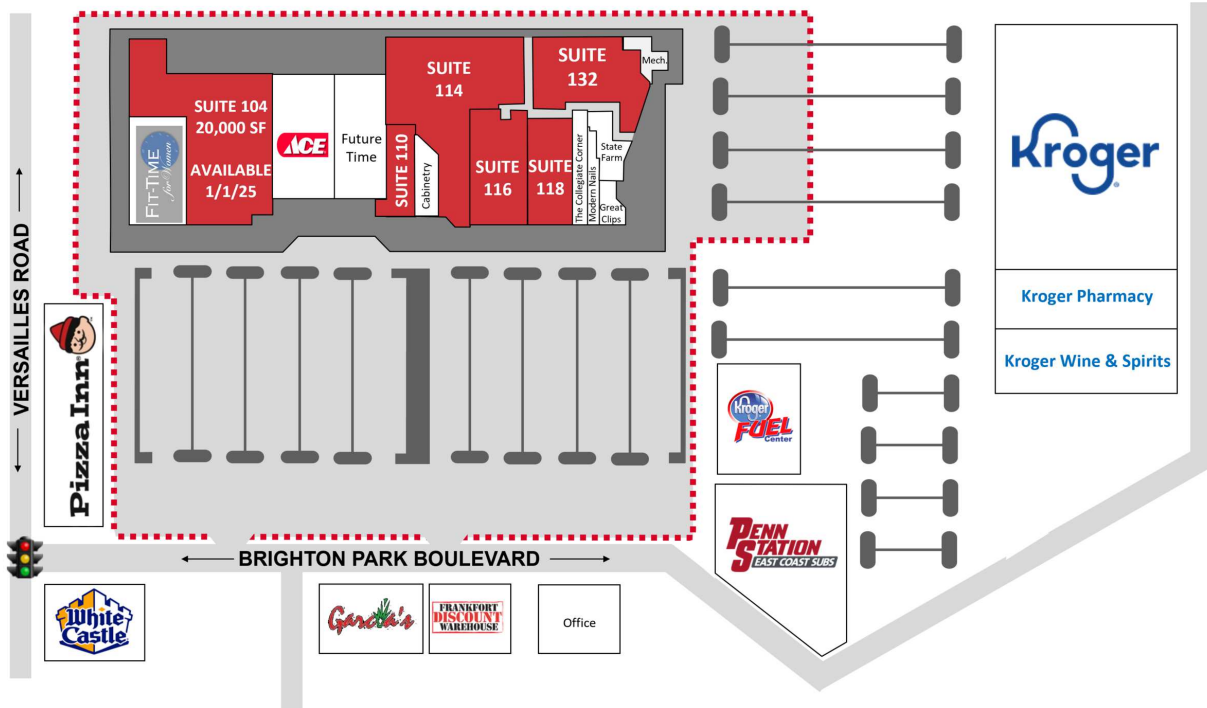

Lease Information

Lease Type:	NNN; Ground	Lease Term:	Negotiable
Total Space:	3,200 - 34,464 SF	Lease Rate:	Negotiable


Available Spaces

Suite	Size (SF)	Lease Type	Lease Rate	Description
Suite 104	20,000 SF	NNN	Negotiable	Available 1/1/25
Suite 110	3,200 SF	NNN	Negotiable	-
Suite 114	9,030 - 21,074 SF	NNN	Negotiable	Second Generation Entertainment Venue
Suite 116	9,225 - 34,464 SF	NNN	Negotiable	Can be combined with portion of Suite 114, 118 and 132
Suite 118	5,972 - 34,464 SF	NNN	Negotiable	Can be combined with portion of Suite 114, 116 and 132
Suite 132	7,223 - 34,464 SF	NNN	Negotiable	Can be combined with portion of Suite 114, 116 and 118
Proposed Outparcel	0.5 Acres	Ground Lease	Negotiable	Exact location TBD

NO WARRANTY OR REPRESENTATION, EXPRESS OR IMPLIED, IS MADE AS TO THE ACCURACY OF THE INFORMATION CONTAINED HEREIN, AND THE SAME IS SUBMITTED SUBJECT TO ERRORS, OMISSIONS, CHANGE OF PRICE, RENTAL OR OTHER CONDITIONS, PRIOR SALE, LEASE OR FINANCING, OR WITHDRAWAL WITHOUT NOTICE, AND OF ANY SPECIAL LISTING CONDITIONS IMPOSED BY OUR PRINCIPALS NO WARRANTIES OR REPRESENTATIONS ARE MADE AS TO THE CONDITION OF THE PROPERTY OR ANY HAZARDS CONTAINED THEREIN ARE ANY TO BE IMPLIED.


For Lease

3,200 - 34,464 SF | Negotiable
Retail Space

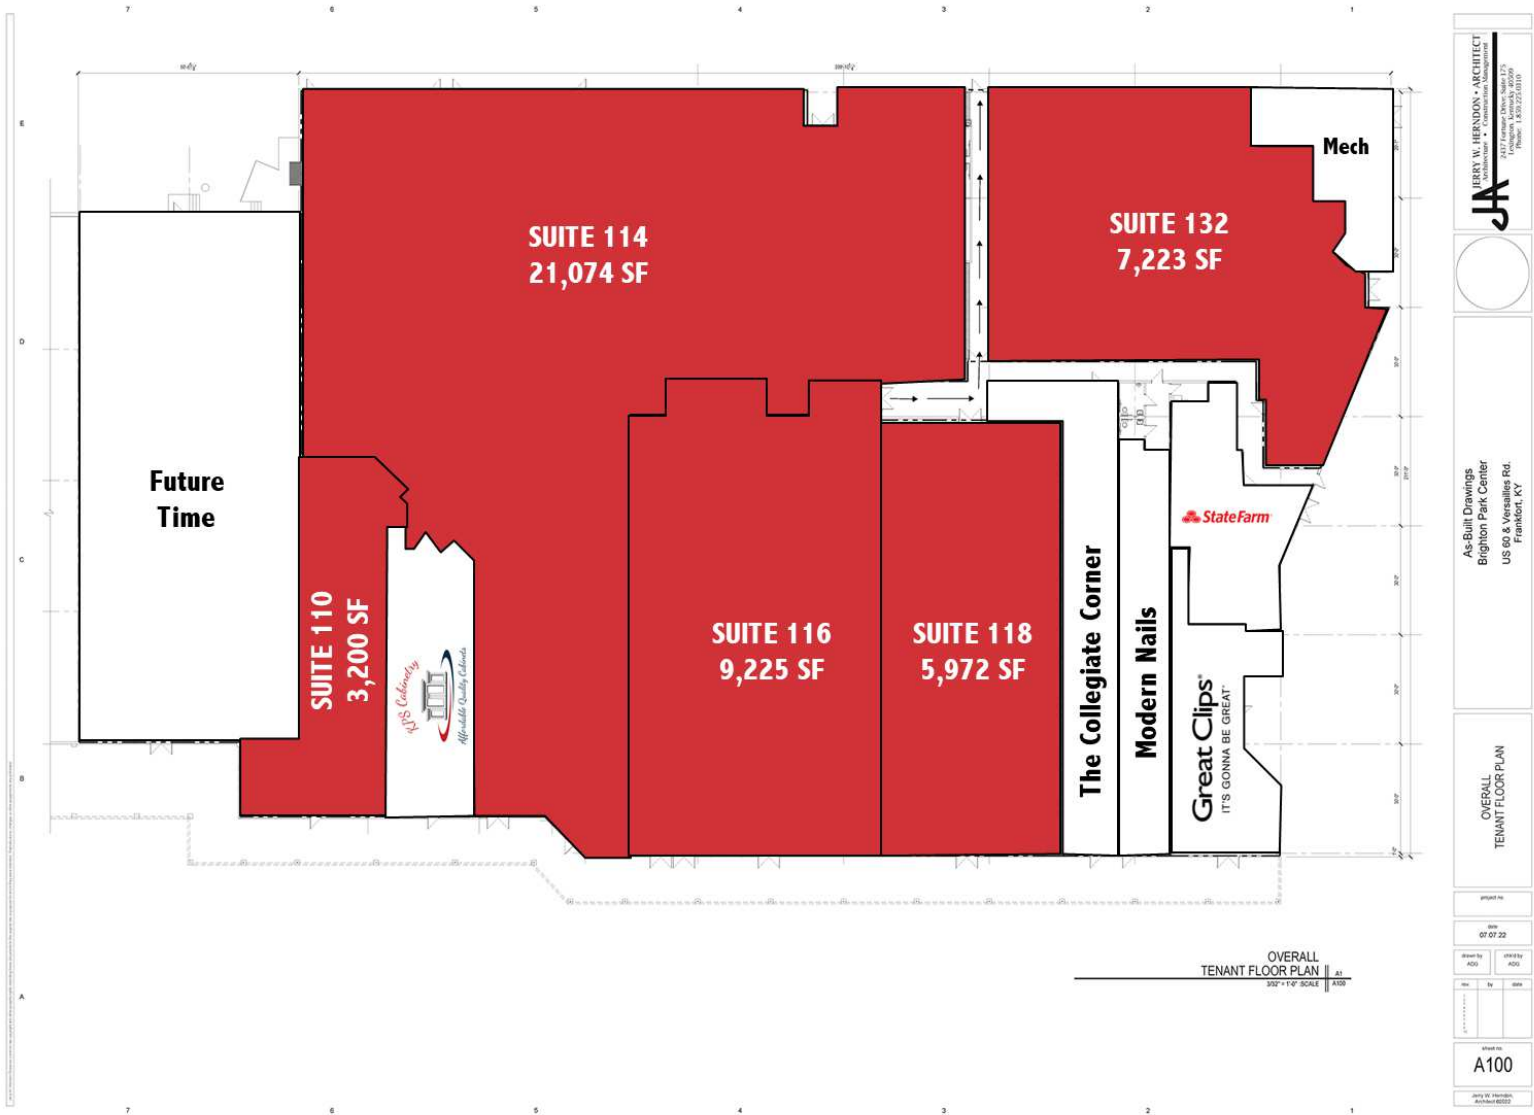


NO WARRANTY OR REPRESENTATION, EXPRESS OR IMPLIED, IS MADE AS TO THE ACCURACY OF THE INFORMATION CONTAINED HEREIN, AND THE SAME IS SUBMITTED SUBJECT TO ERRORS, OMISSIONS, CHANGE OF PRICE, RENTAL OR OTHER CONDITIONS, PRIOR SALE, LEASE OR FINANCING, OR WITHDRAWAL WITHOUT NOTICE, AND OF ANY SPECIAL LISTING CONDITIONS IMPOSED BY OUR PRINCIPALS NO WARRANTIES OR REPRESENTATIONS ARE MADE AS TO THE CONDITION OF THE PROPERTY OR ANY HAZARDS CONTAINED THEREIN ARE ANY TO BE IMPLIED.


771 Corporate Drive, Suite 500
Lexington, KY 40503
859 224 2000 tel
naiisaac.com

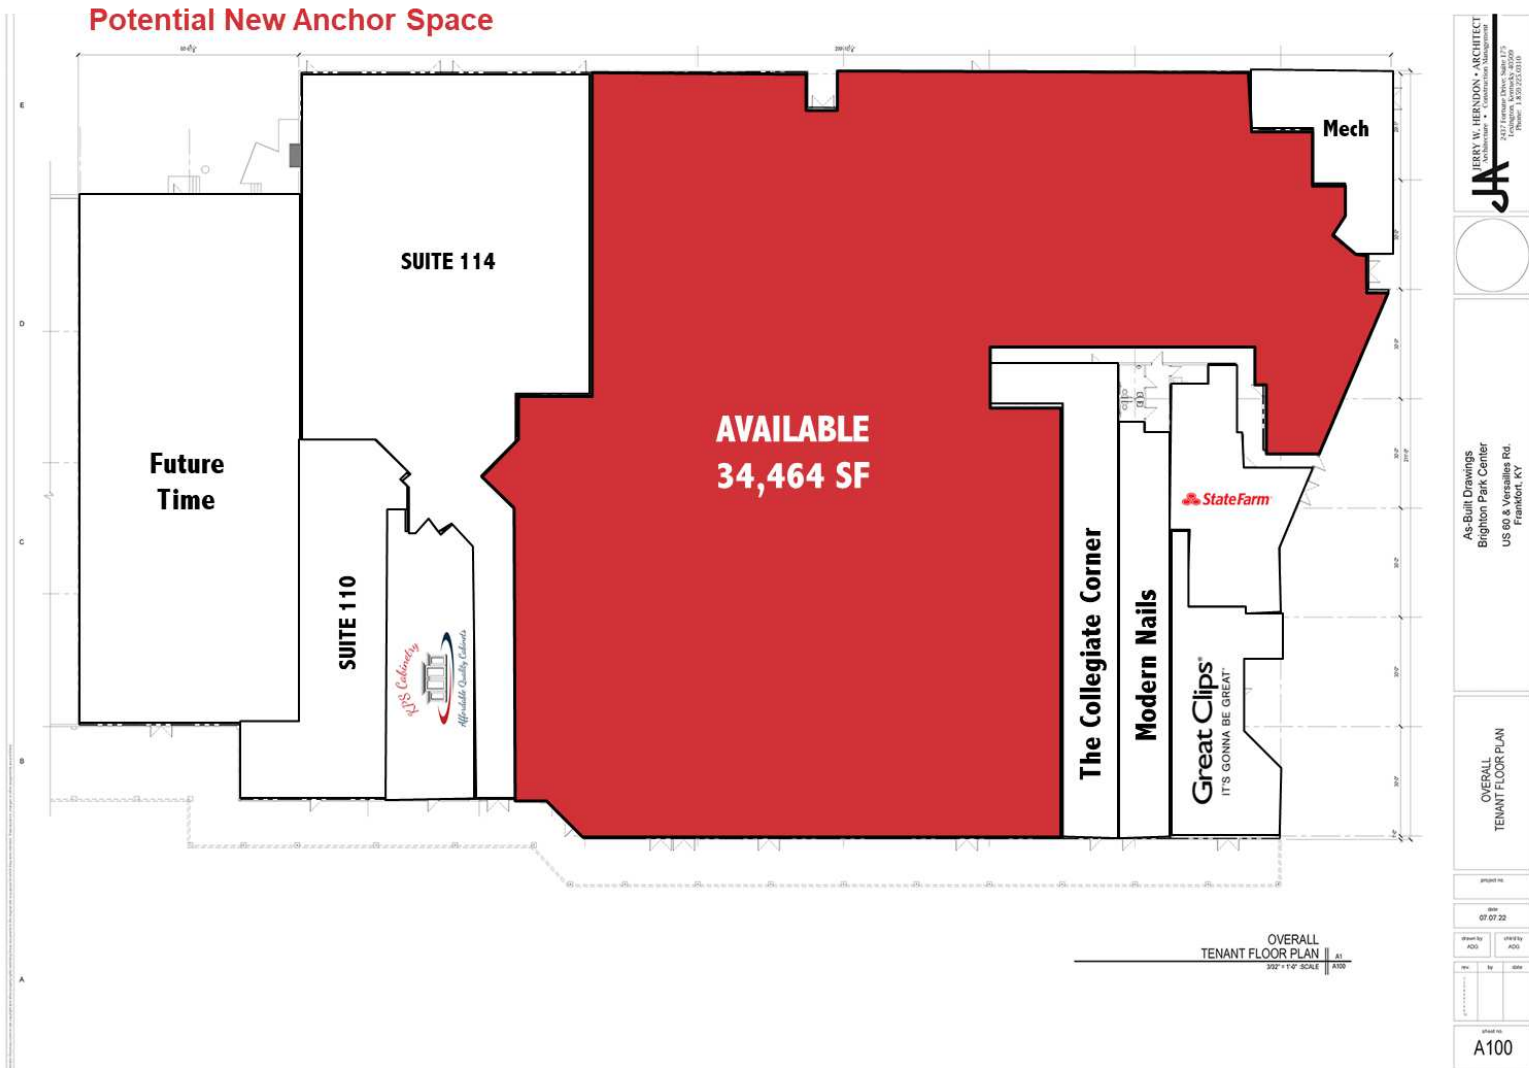


For Lease

9,030 - 21,074 SF | Negotiable
Suite 114

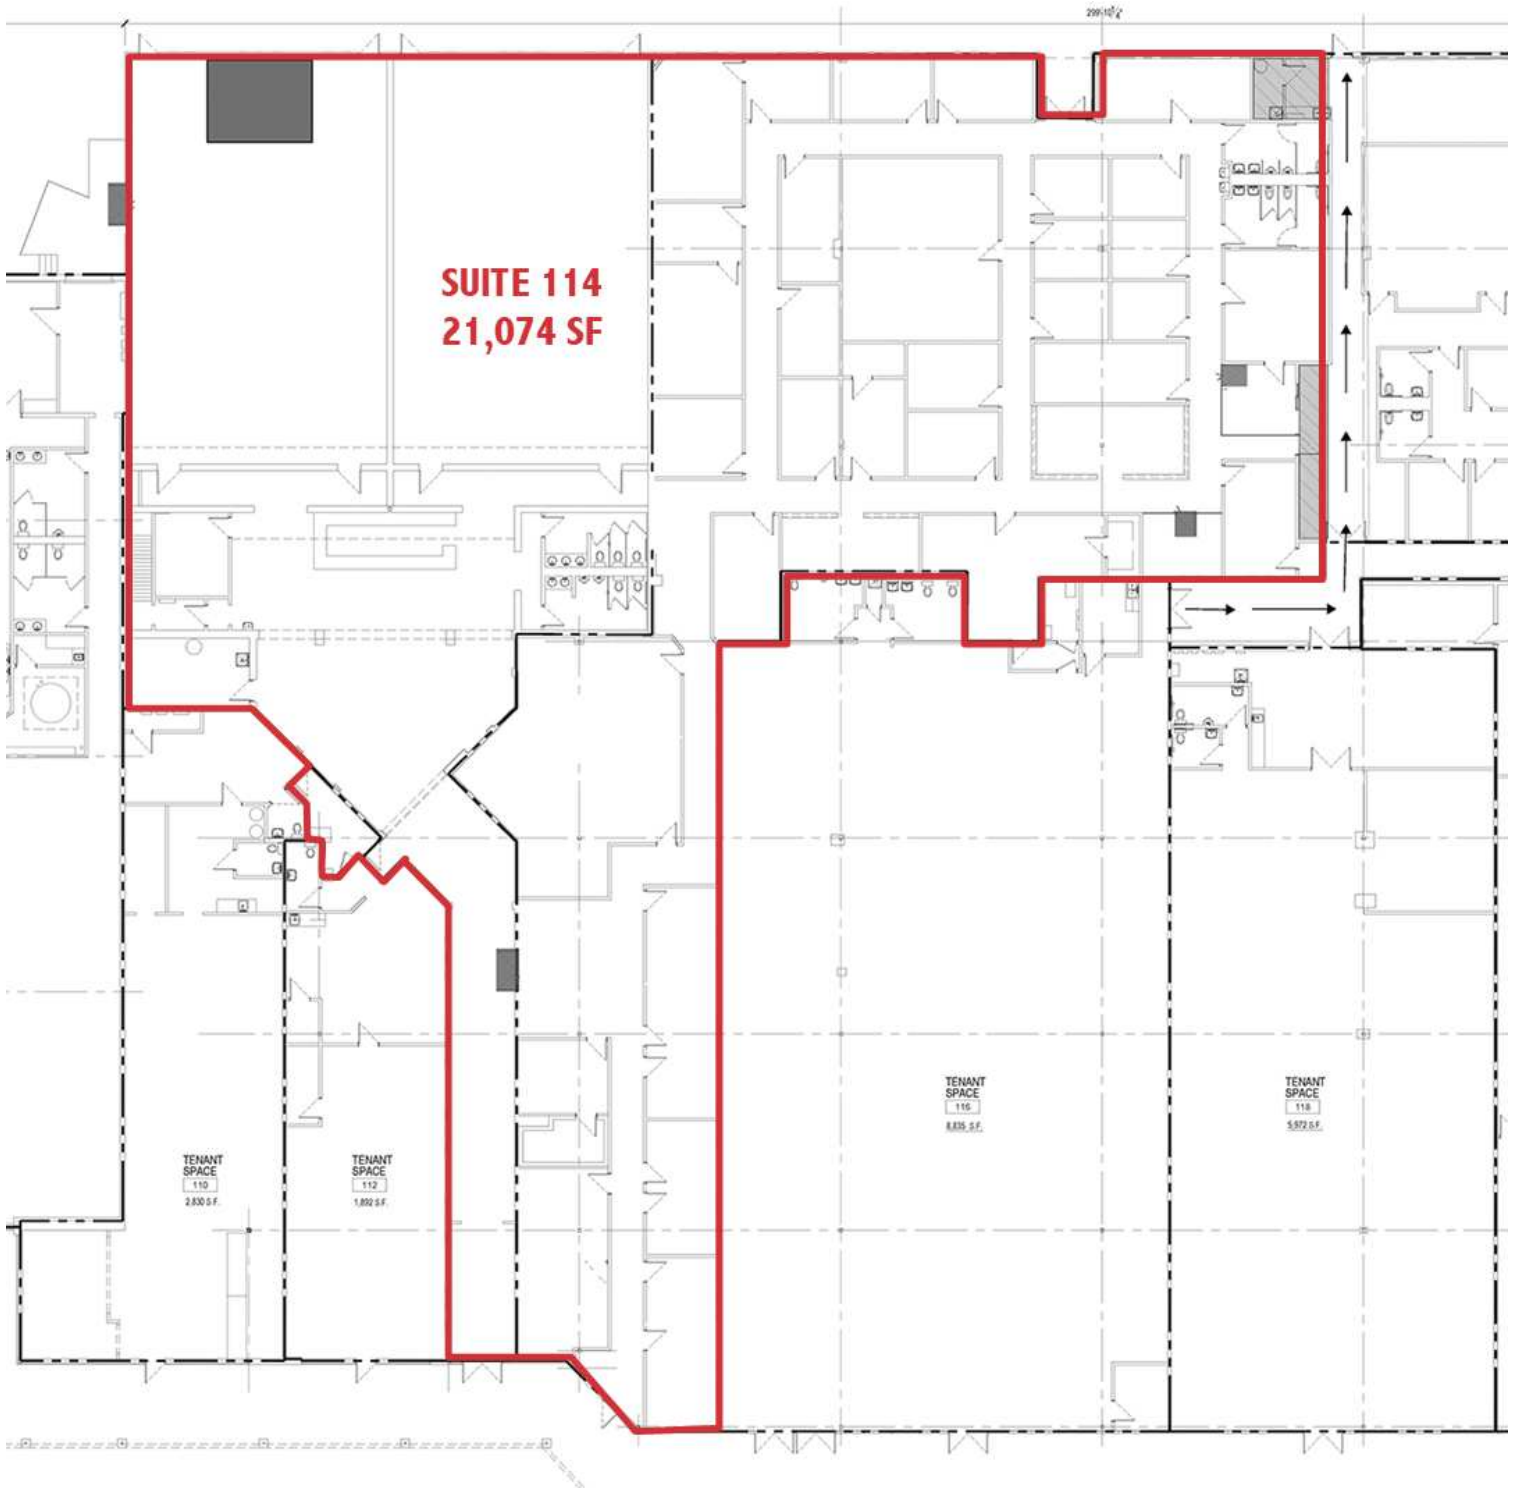


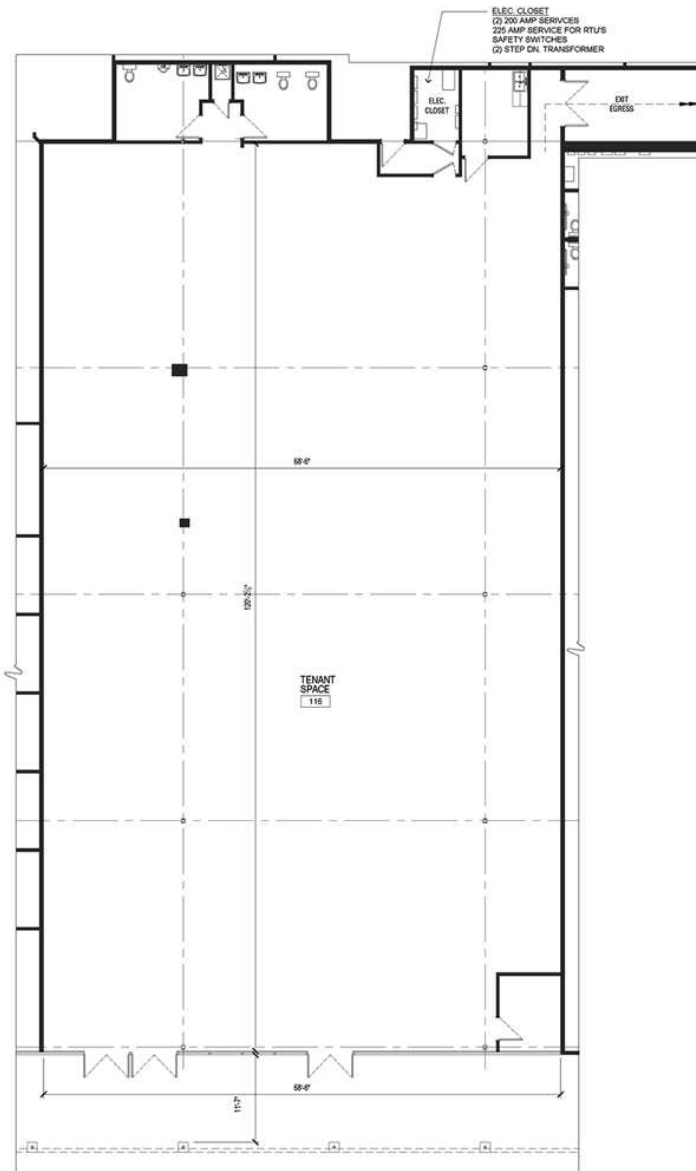


TENANT SPACE #116
FLOOR PLAN
1/8" = 1'-0" SCALE A1

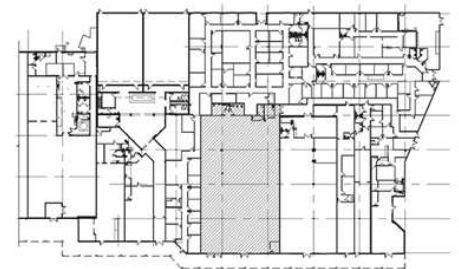

KEY PLAN
NTS SCALE

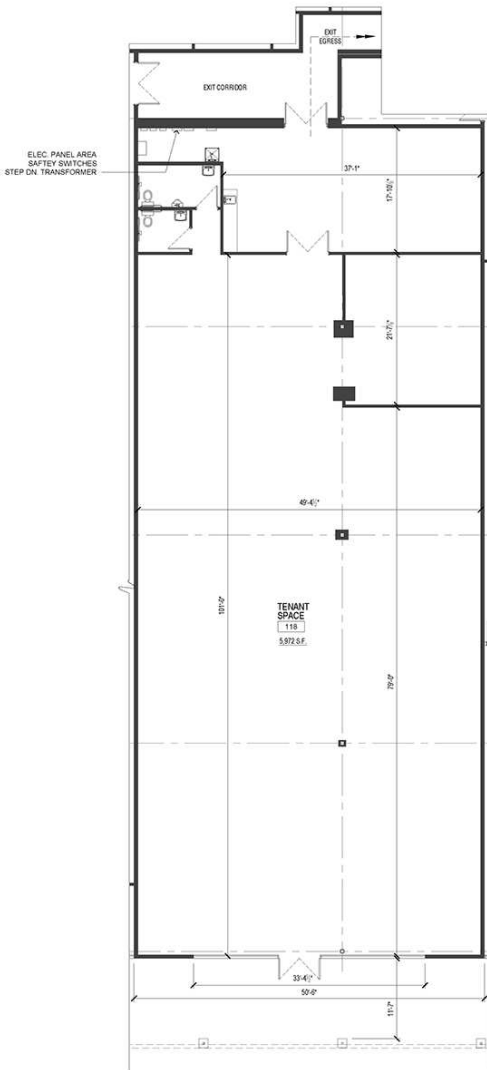

TENANT SPACE #118
FLOOR PLAN
1/8" = 1'-0" SCALE || A1
A101

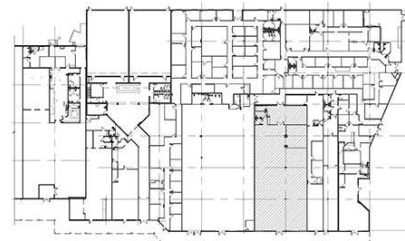

KEY PLAN
NTS SCALE

JERRY W. HERNDON • ARCHITECT
Architecture • Construction Management
2437 Fortune Drive, Suite 500
Lexington, KY 40503
Phone: 1.859.222.0310

As-Built Drawings
Brighton Park Center
US 60 & Versailles Rd.
Frankfort, KY

TENANT FLOOR PLAN

project no.

date

08.01.22

drawn by

ADD

checked by

ADD

rev.


by

date

sheet no.

A101



Jerry W. Herndon,
Architect ©2022

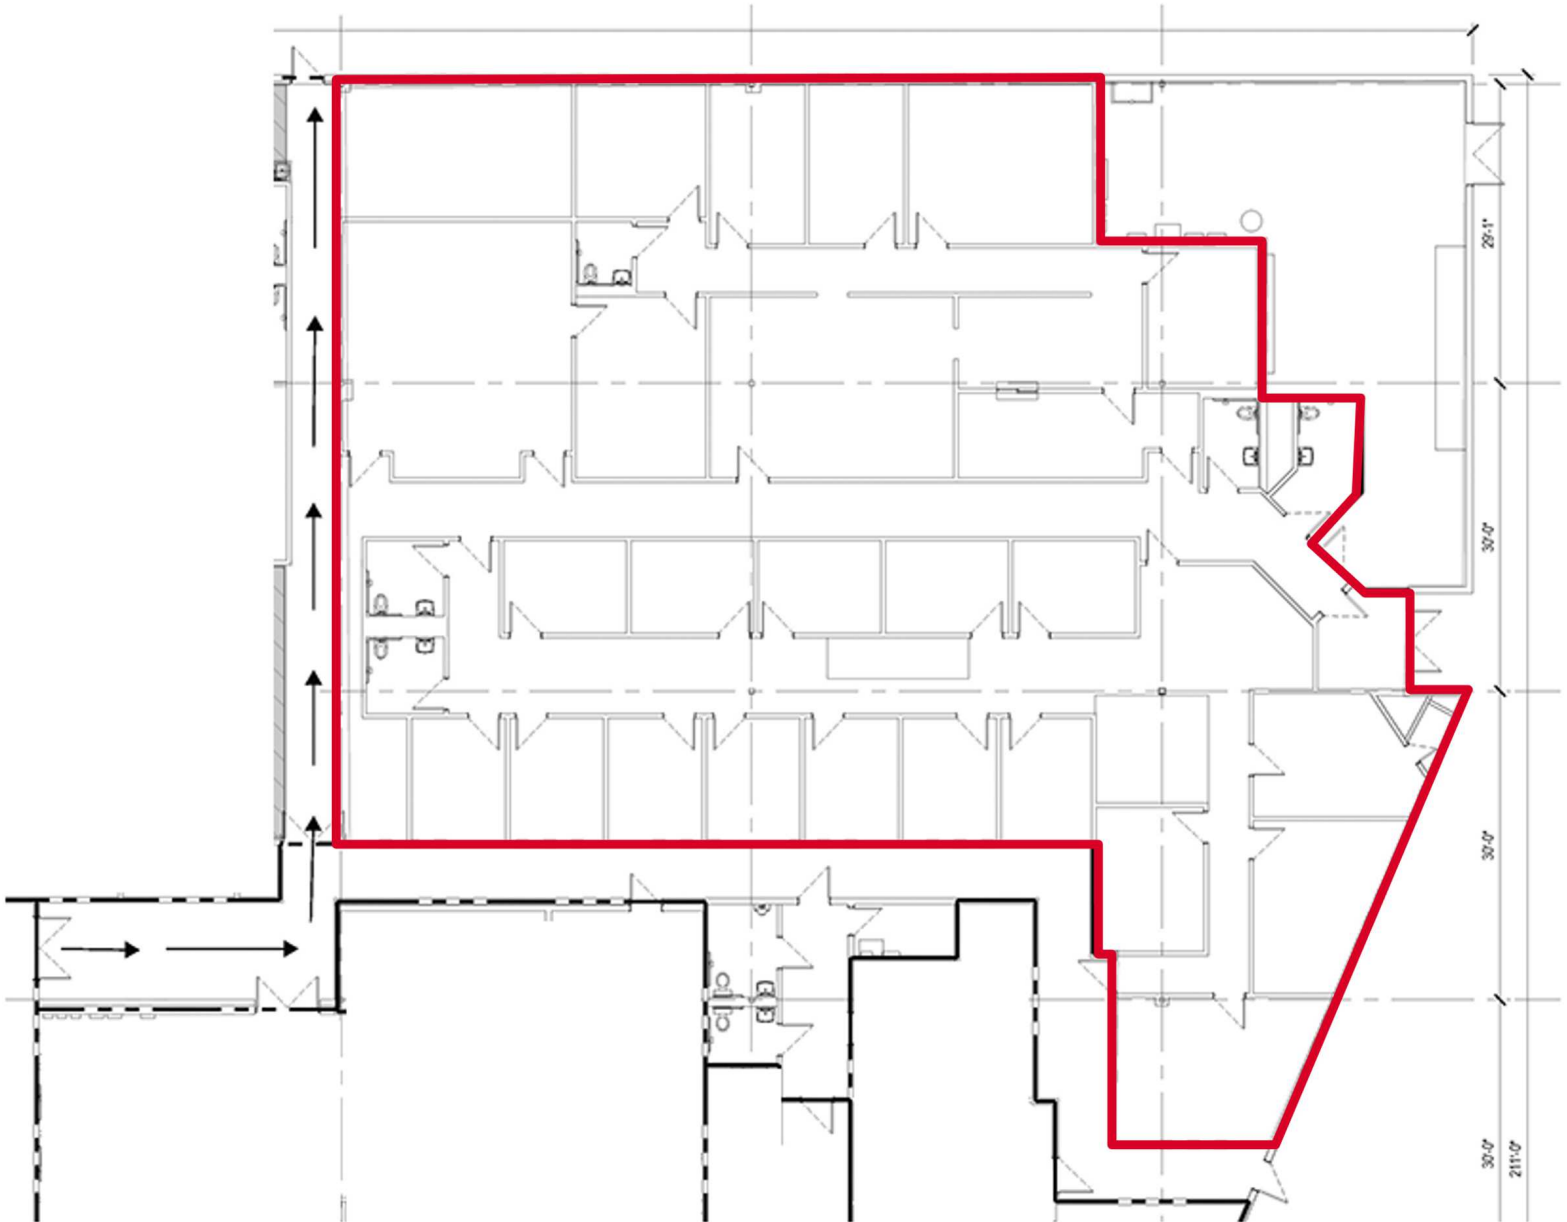

For Lease


3,200 - 34,464 SF | Negotiable

Retail Space

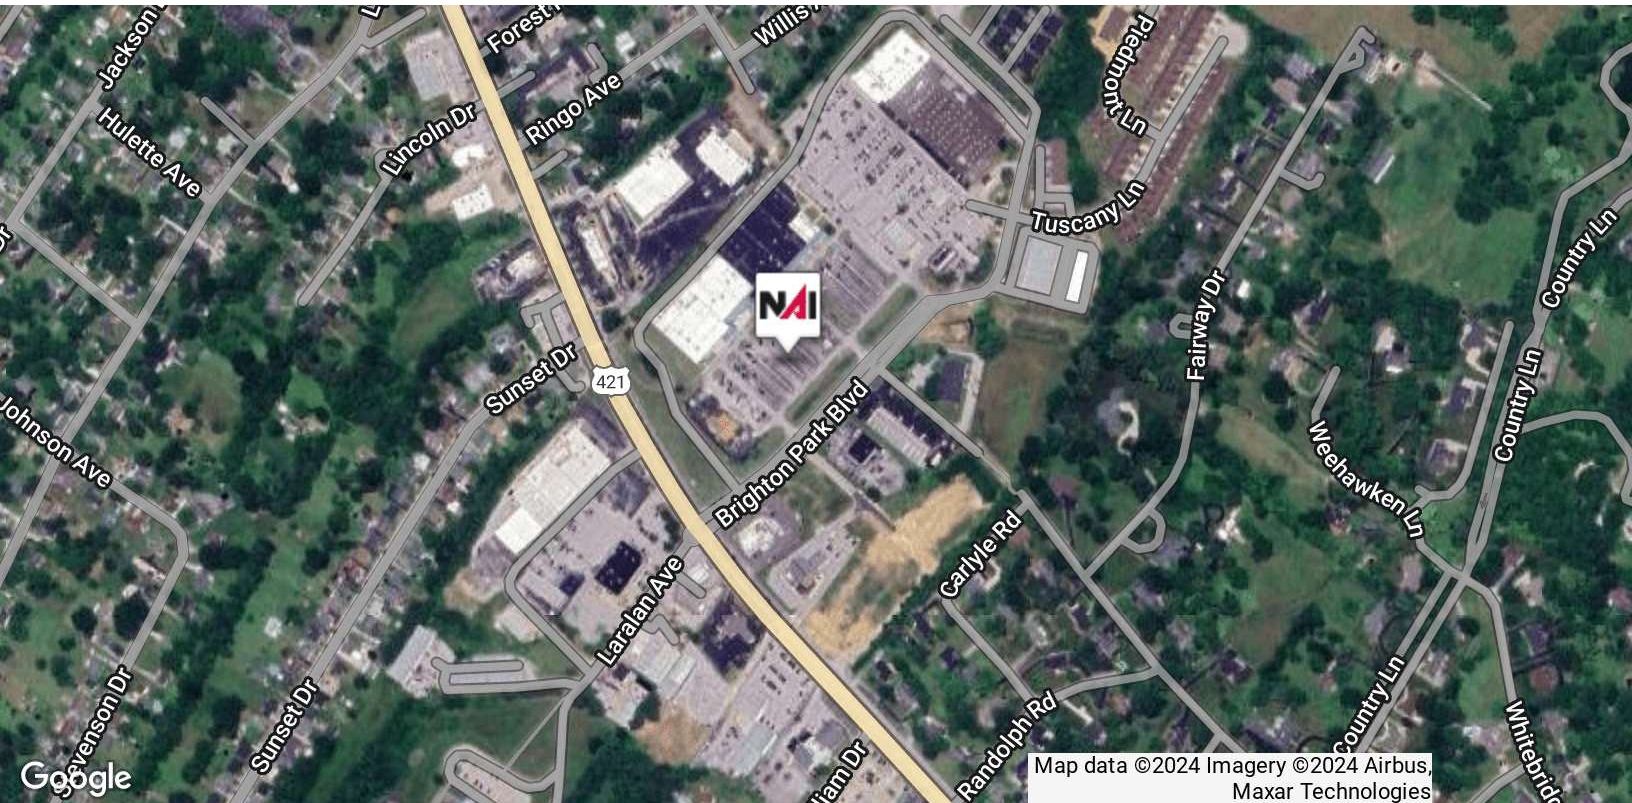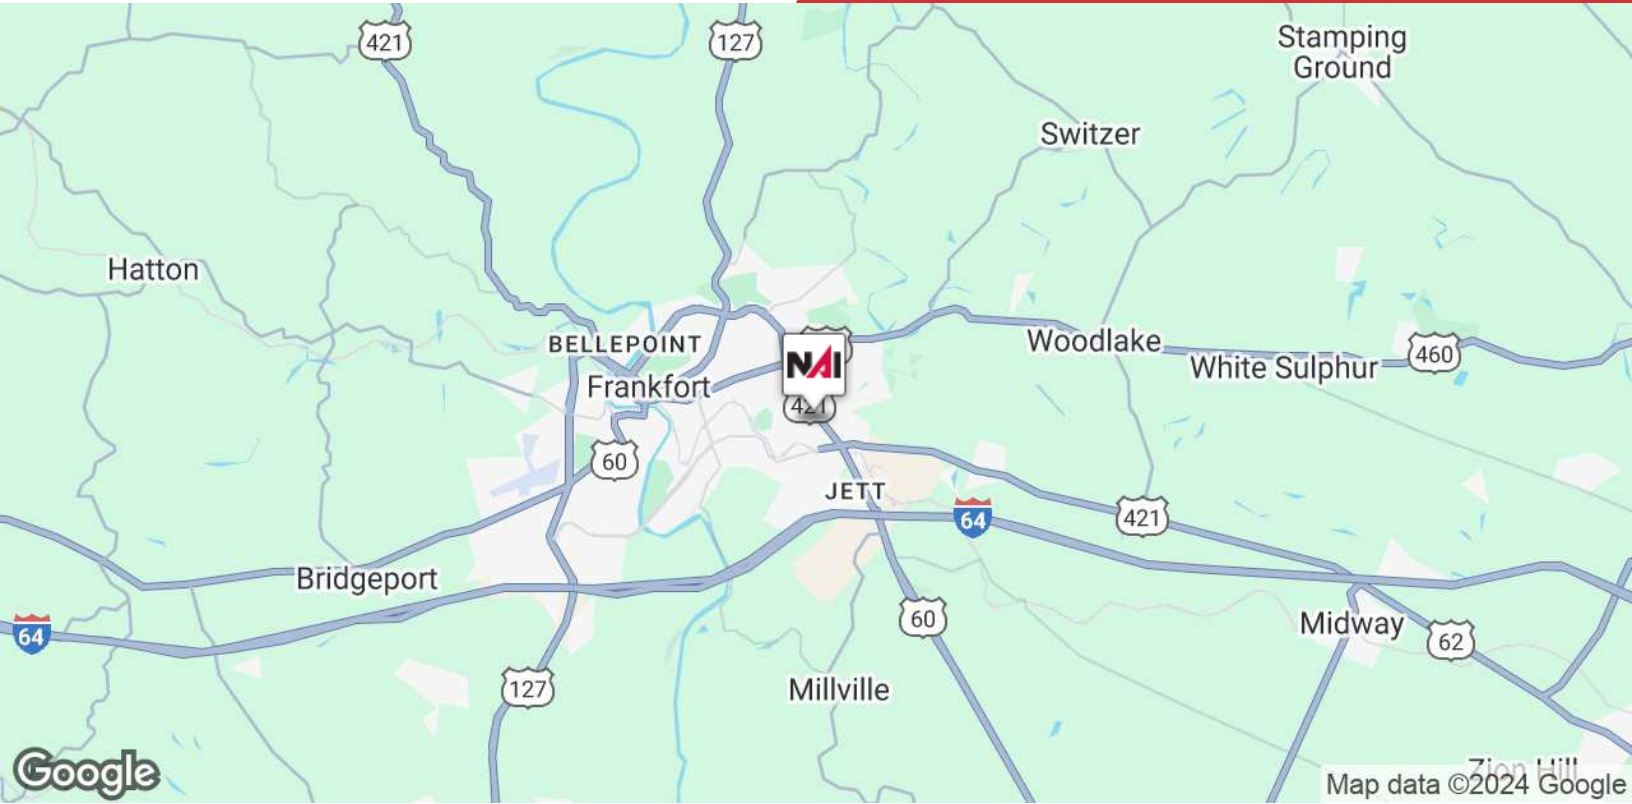

NO WARRANTY OR REPRESENTATION, EXPRESS OR IMPLIED, IS MADE AS TO THE ACCURACY OF THE INFORMATION CONTAINED HEREIN, AND THE SAME IS SUBMITTED SUBJECT TO ERRORS, OMISSIONS, CHANGE OF PRICE, RENTAL OR OTHER CONDITIONS, PRIOR SALE, LEASE OR FINANCING, OR WITHDRAWAL WITHOUT NOTICE, AND OF ANY SPECIAL LISTING CONDITIONS IMPOSED BY OUR PRINCIPALS NO WARRANTIES OR REPRESENTATIONS ARE MADE AS TO THE CONDITION OF THE PROPERTY OR ANY HAZARDS CONTAINED THEREIN ARE ANY TO BE IMPLIED.

771 Corporate Drive, Suite 500
Lexington, KY 40503
859 224 2000 tel
naiisaac.com

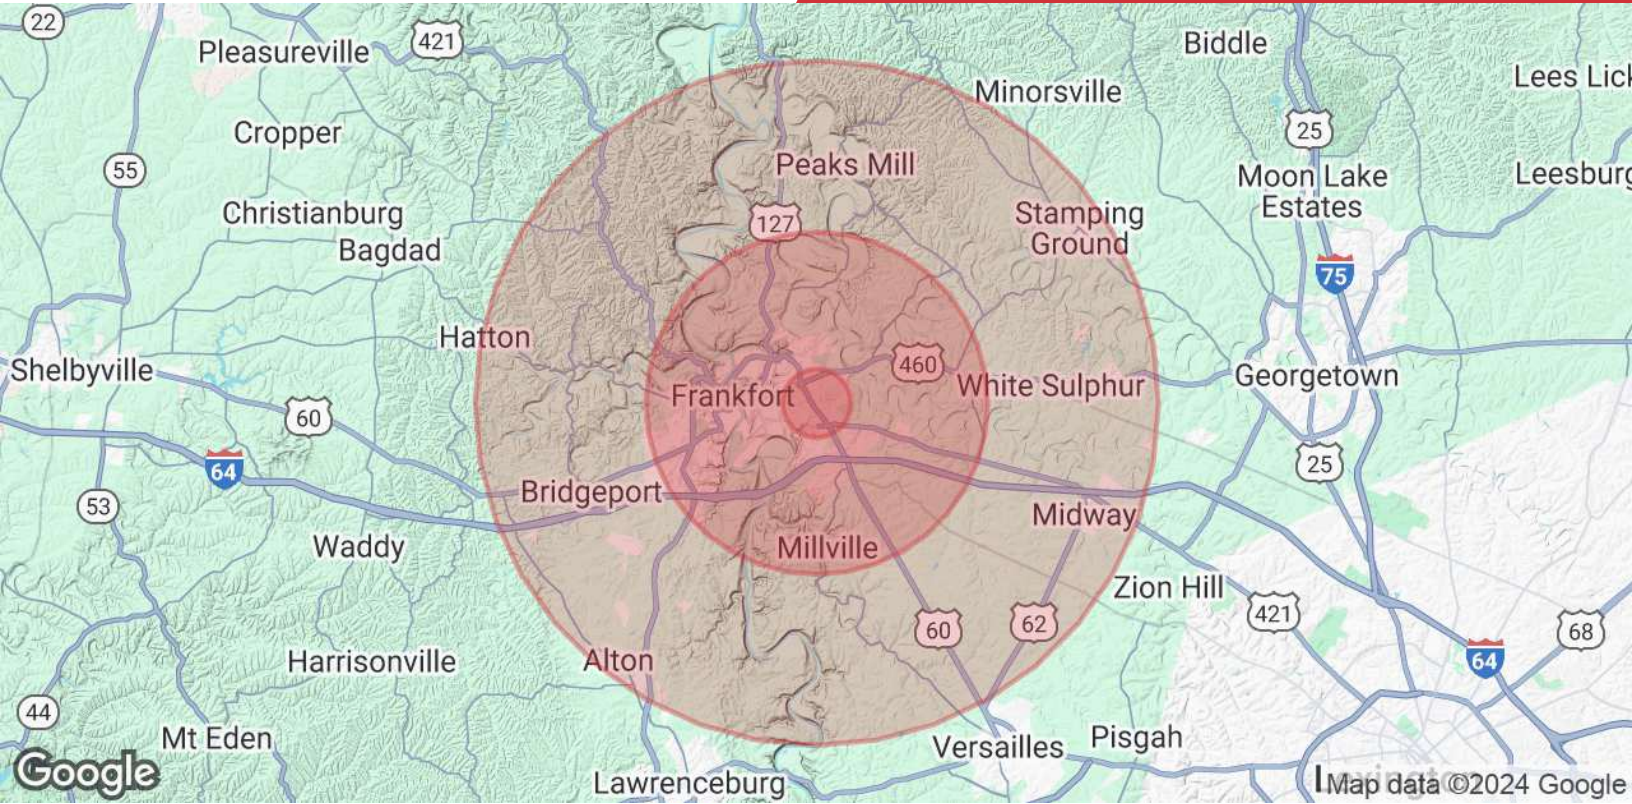

Population	1 Mile	5 Miles	10 Miles
Total Population	1,976	38,040	68,710
Average Age	37.4	37.6	38.4
Average Age (Male)	37.0	36.6	37.5
Average Age (Female)	37.4	38.4	39.3
Households & Income	1 Mile	5 Miles	10 Miles
Total Households	799	16,472	29,155
# of Persons per HH	2.5	2.3	2.4
Average HH Income	\$70,125	\$58,985	\$62,501
Average House Value	\$143,280	\$146,208	\$158,672

* Demographic data derived from 2021 STDB