

For Lease – 549 Keystone Drive

Thorn Hill Industrial Park, Warrendale PA



Property Highlights

- Building Constructed In 2000
- Single-story Conditioned Office/Service Space
- Tenant Identification Signage Available
- As-Built Floor Plan on the Back
- Exclusive Drive-in door

Office Space For Lease

Available Fourth Quarter 2023

+ / - 11,000 SF

Area

Minutes to Interstate 79 and PA Turnpike

Lease Rate

\$15.50 / SF + Utilities & Janitorial Services

For information, please contact:

Jeffrey Schultz

Managing Director

t 412-434-1030

Fjeffrey.schultz@nmrk.com

210 Sixth Avenue, Suite 600

Pittsburgh, PA 15222

412-281-0100

nmrk.com


NEWMARK

Licensed in Pennsylvania as Newmark Real Estate

The information contained herein has been obtained from sources deemed reliable but has not been verified and no guarantee, warranty or representation, either express or implied, is made with respect to such information. Terms of sale or lease and availability are subject to change or withdrawal without notice.

549 Keystone Drive

As-Built Floor Plan

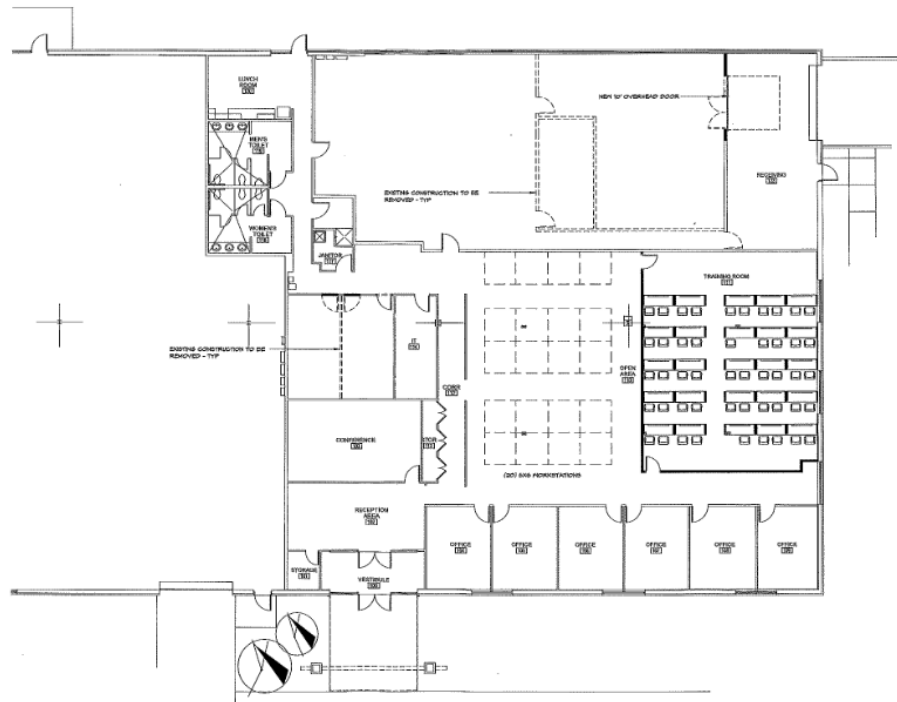

Aerial

