





Colliers International  
1301 Gervais St, Suite 600  
Columbia, SC, 29201  
803-254-2300  
www.colliers.com

# One Harbison Way As Built

One Harbison Way, Columbia, SC, 29212

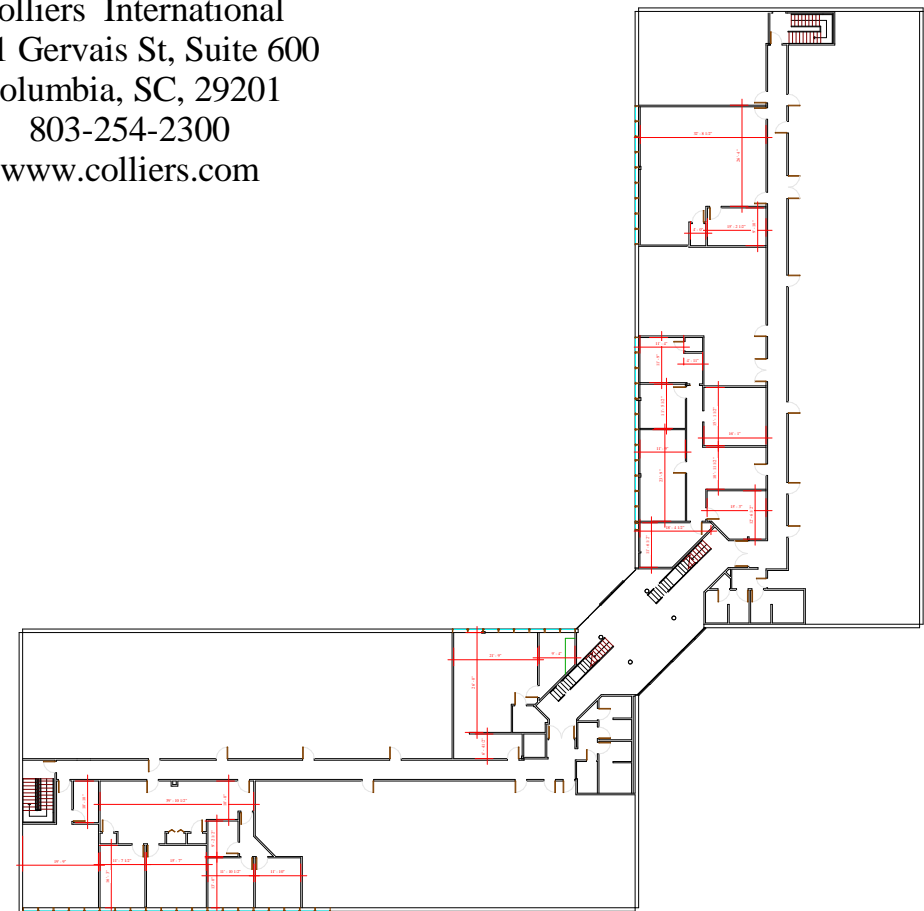


2 2nd Floor Dimension Plan  
1" = 50'-0"

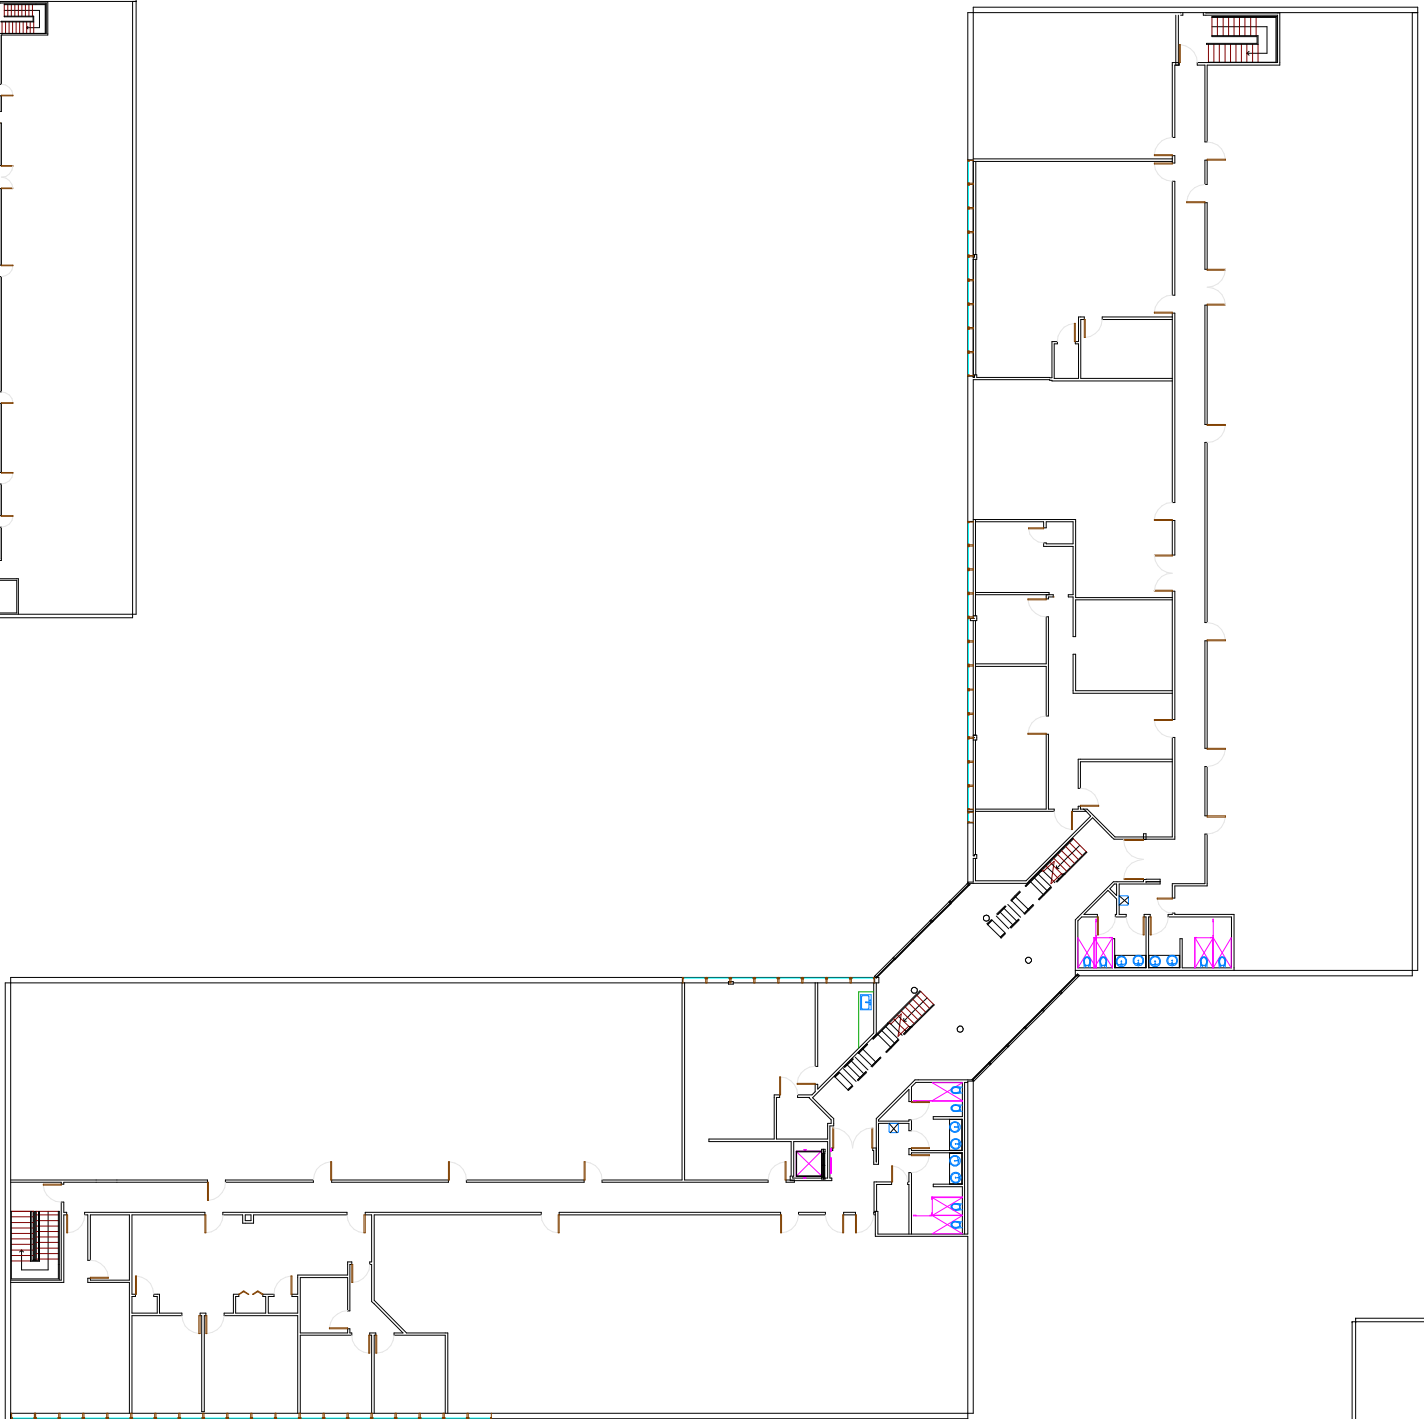

1 2nd Floor Wall Plan  
1/32" = 1'-0" Formatted for 11" x 17" Sheet

## Usable Area Legend

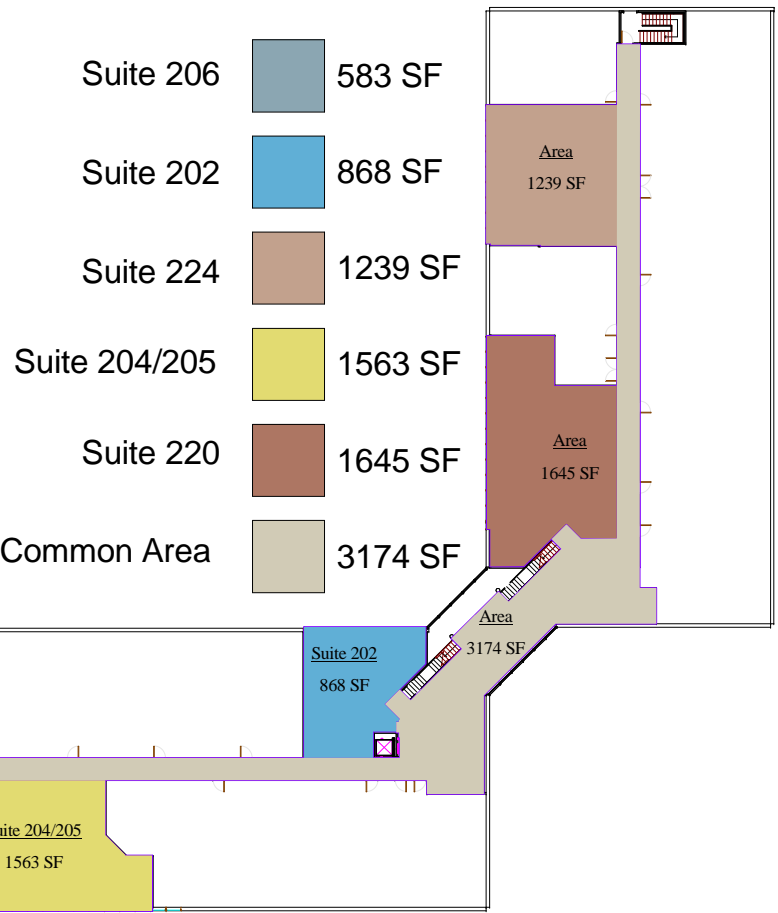

3 2nd Floor Area Plan  
1" = 50'-0"

Prepared by **DSquared Consulting**  
1432 D Avenue  
West Columbia, SC, 29169  
p - 803-622-9037  
f - 877-651-9982  
www.dsquaredconsulting.com



These drawings are provided solely for graphic representation purposes. DSquared shall not be held liable for any and all misstatements of facts, errors or omissions, prior sale, change of price or withdrawal from the market without notice, or damages connected with the use of this information. Recipient acknowledges that acceptance of this information effectively transfers any and all responsibility to recipient for use of this information.

ALL DIMENSIONS SHOULD BE FIELD VERIFIED!  
Published on 5/21/2012 2:31:08 PM