


As-built Plans for
256 E. CAWSON STREET
Hopewell, Virginia 23860

REVISIONS:

DATE: 4/20/24

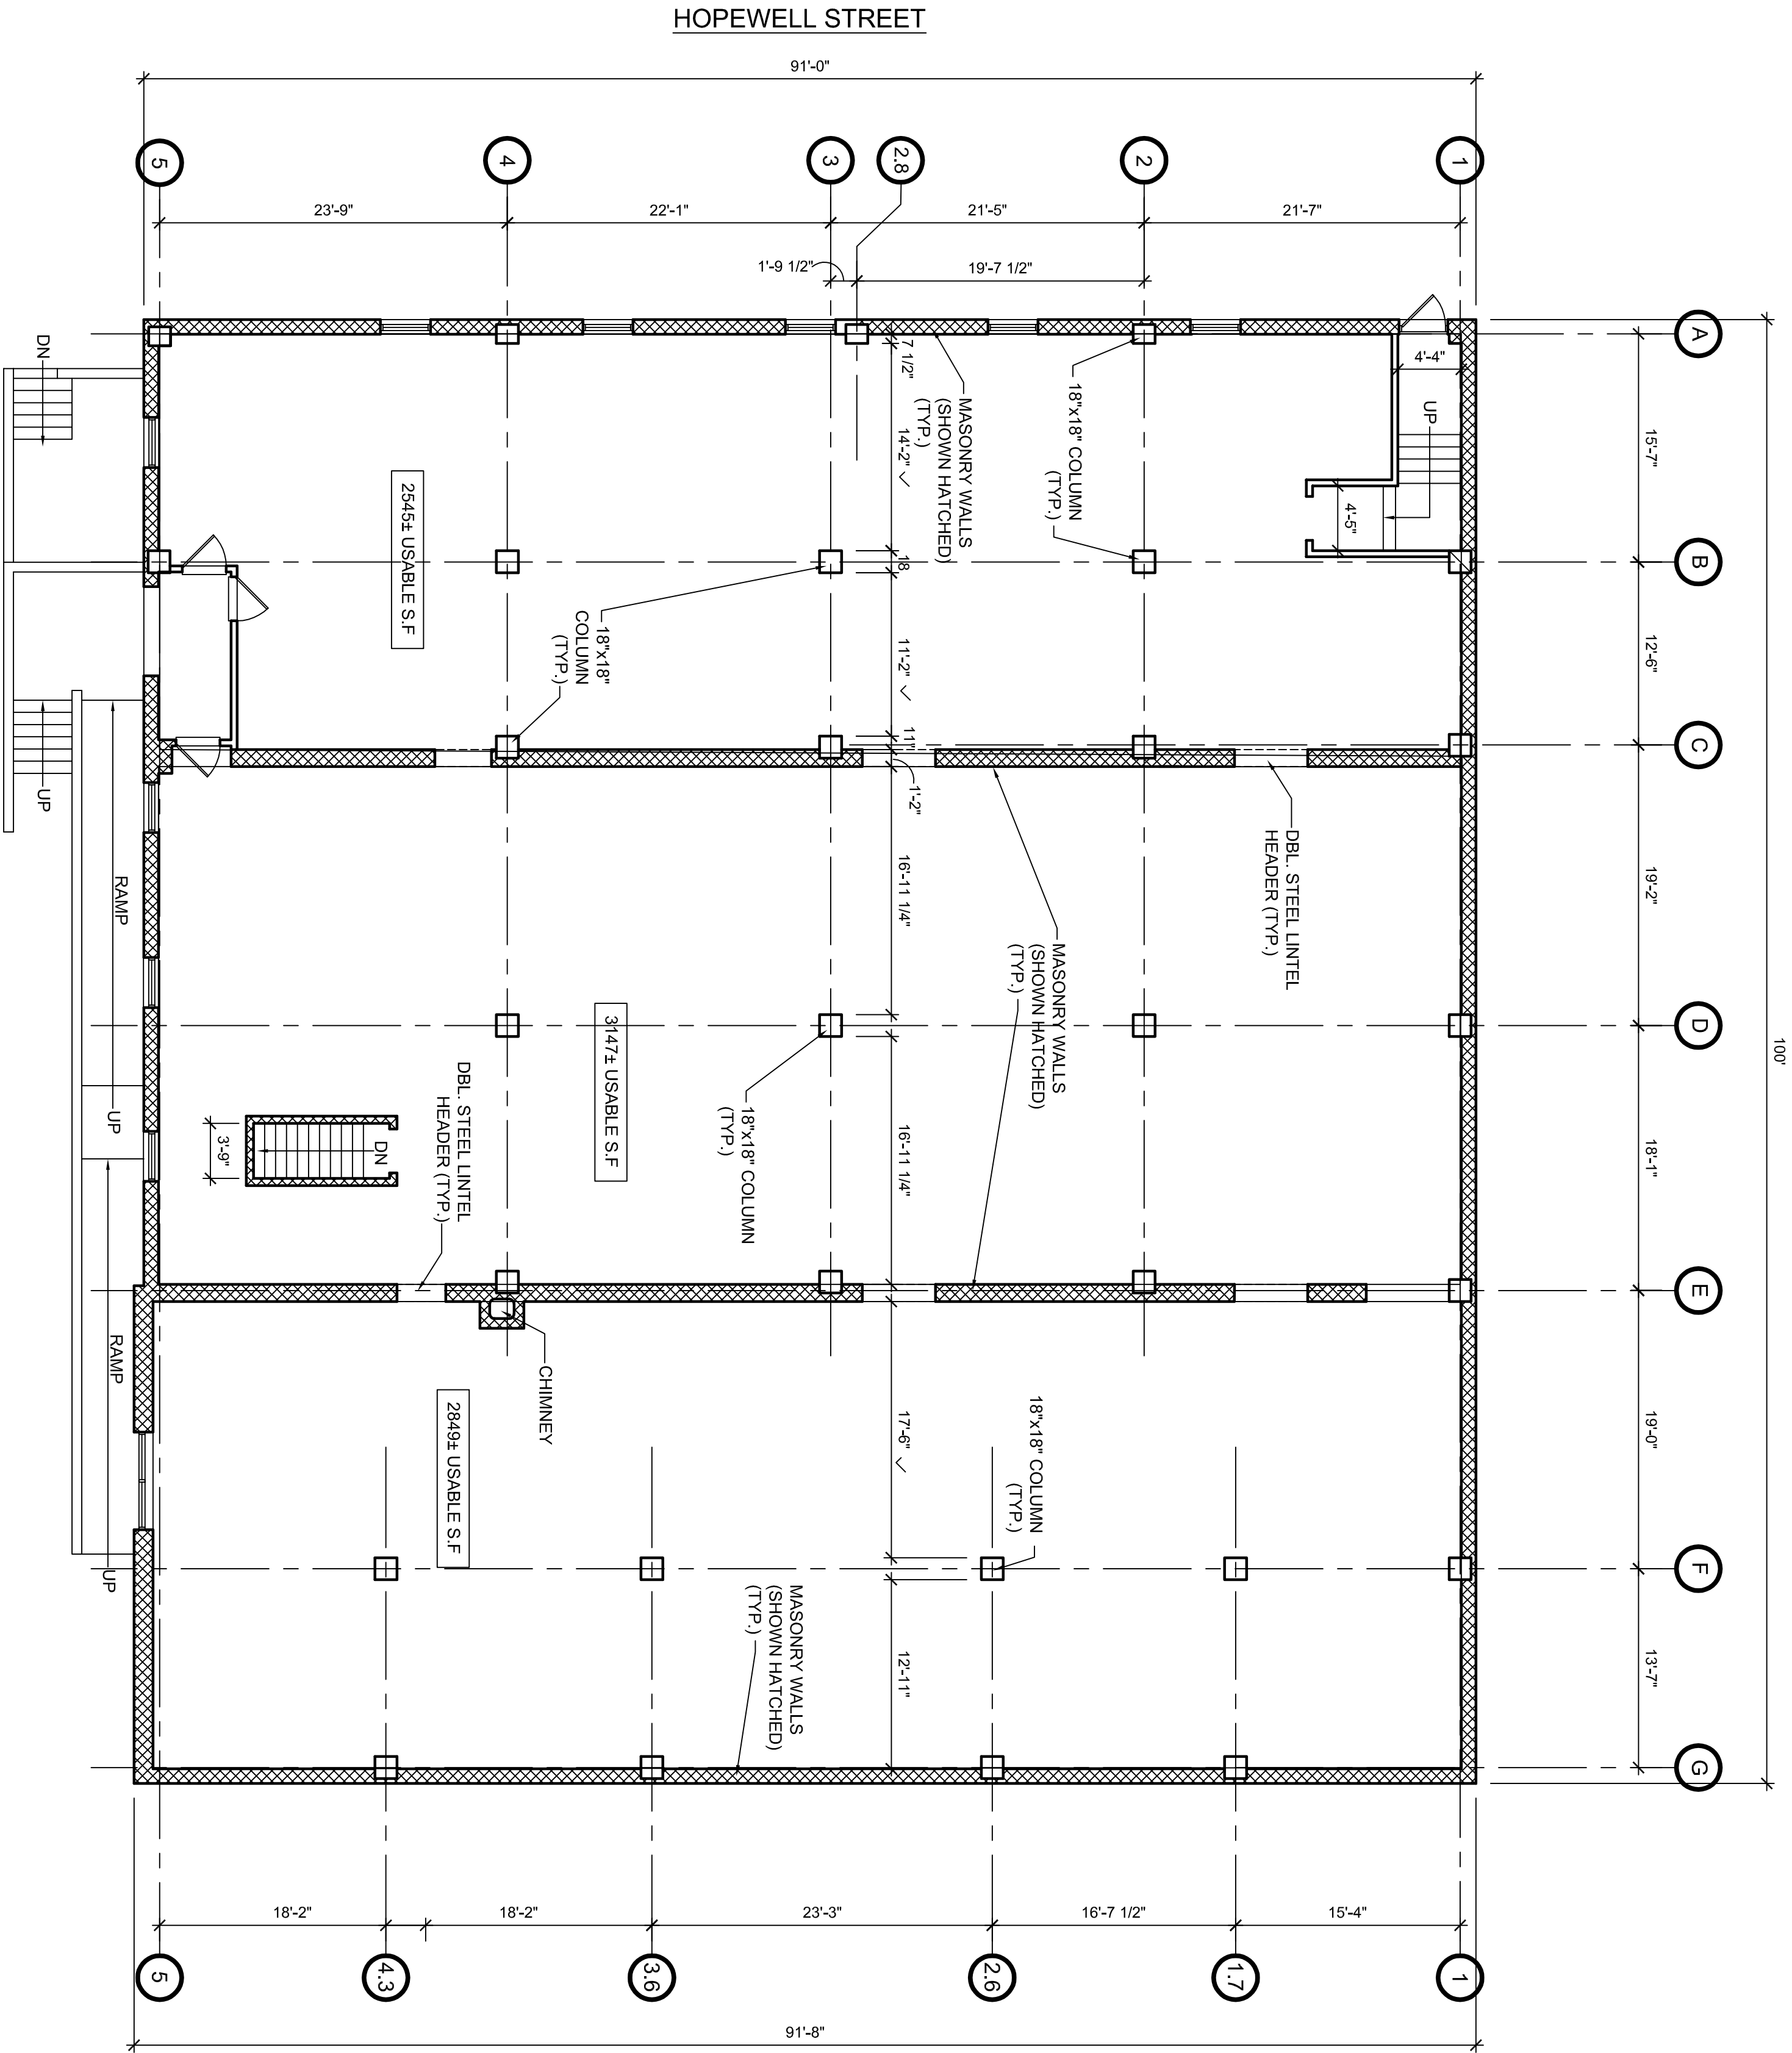

MAIN FLOOR PLAN (AS-BUILT)

0' 4' 8' 16'

1/8" = 1'-0"

EAST CAWSON STREET

HOPEWELL STREET

NOTE: THESE PLANS ARE FOR CONCEPTUAL
USE ONLY. WHILE DEVELOPED FROM ON-SITE
DOCUMENTATION, BUILDING CONDITIONS
LIMITED ABILITY TO DOCUMENT WITHOUT
ASSUMPTIONS AND ESTIMATES.