

STORE PLANNING
DEPARTMENT
P.O. BOX 3165
HARRISBURG, PA 17105
(717) 761-2633

STORE NO.
4144 PPR

RITE AID PHARMACY

341 HIGH STREET
SOMERWORTH, NH

TYPES

PROJECT
PPR
BUILDING
BA5
PHARMACY
16' RA1
DECOR
HW

PROJECT ATTRIBUTES

Photo ☐ HAND DIP ☐ LIQUOR
Drive-Thru ☒ G. N. C.

SECURITY LEVEL

High ☐ Medium ☐ Low
High* SECURITY DESIGNATION BUILDING WILL REQUIRE SECURITY SHUTTERS @ FRONT WINDOWS.

BUILDING AREA (SQ. FT.)

EXIST	NEW
SALES FLOOR:	9477 9364
PHARMACY:	478 478
WAITING AREA:	103 113
REC./STORAGE:	419 419
LOUNGE:	0 0
CONSULTATION RM:	0 103
SPECIAL:	0 0
MEZZANINE:	0 0
RESTROOMS:	175 175
SUB TENANT:	0 0
RTTE ADJ TOTAL:	10652 10652
OVERALL TOTAL:	10953 10953

REFRIGERATION

COOLER DRS	14 14
FREEZER DRS	4 4

FIXTURES (LIN. FEET)

SALES FLOOR:	1283 1337
WINE DEPT:	0 0
TOTAL:	1283 1337

PROJECT CONTACTS
DIR OF CONSTRUCTION
GARY ANTOS
REG. CONST. MANAGER

PHIL MARSHALL

RITE STORE
AID NUMBER
4144 PPR

CONSTRUCTION NOTES

#CIRCLE WITH NUMBER REFERENCES CONSTRUCTION NOTES

- 1) INSTALL NEW STEEL AS SHOWN ON PLAN.
- 2) RELOCATE EXISTING STEEL AS SHOWN ON PLAN.
- 3) REMOVE EXISTING PHOTO CABINETS.
- 4) INSTALL NEW TIER 4 PHOTO KIT AS SHOWN ON PLAN.
- 5) INSTALL NEW WELCOME FIXTURE.
- 6) INSTALL NEW 66" FITNESS COOLER.
- 7) INSTALL (2) NEW 90" (66") COSMETIC PROMO FIXTURES AS SHOWN ON PLAN.
- 8) INSTALL NEW P&G HM & HER ENDS.
- 9) INSTALL NEW 8' FRAGRANCE FIXTURE WITH POWER REQUIRED.
- 10) INSTALL 4 CUSTOMER PULL BASKET STANDS WITH BASKETS SHOULD BE SPACED THROUGHOUT THE SALES AREA IN EASYLY VISIBLE LOCATIONS AS FOLLOWS: 2 STANDS NEAR STORE ENTRANCES(1) STAND NEAR RX AND 1 NEAR MIDDLE OF STORE PREFERABLY CLOSE TO 12 PACK BEVERAGE MEGACANDISER.
- 11) INSTALL NEW FURNITURE IN LOUNGE AS SHOWN ON PLAN.
- 12) INSTALL NEW WELLNESS STATION AS SHOWN ON PLAN.
- 13) CONSTRUCT NEW CONSULTATION ROOM & WAITING AREA AS SHOWN ON PLAN.
- 14) INSTALL NEW BULK STICKS AS SHOWN ON PLAN.
- 15) REMOVE/ RELOCATE CABINETS AS SHOWN.
- 16) CUT OPENING AND INSTALL NEW 30"x24" FLIP-UP COUNTERTOP WITH GATE BELOW.
- 17) INSTALL NEW COUNTERTOPS AS NEEDED TO ACCOMMODATE FLIP TOP COUNTERTOP.
- 18) INSTALL NEW WOOD CANOPY PROVIDED BY RA FDC.
- 19) INSTALL NEW 37" WOOD ENDPANEL PROVIDED BY RA FDC.
- 20) INSTALL NEW ACRYLIC SIGN HOLDER PROVIDED BY RA FDC.
- 21) INSTALL TAN SHELVES IN GNC DEPARTMENT.
- 22) ADD NEW 6" EXTENDERS AS SHOWN.

► DENOTES NEW PHONE LOCATION

PLAN APPROVAL	
SIGNED DAVID KELLY	DATE 6/20/12
SIGNED BRYAN SHIRTLIFF	DATE 6/20/12


PHOTO EQUIPMENT			
NAME	4X6 PRINTER	BX10 PRINTER	DIGI SCANNER
STATUS	NEW	NEW	NEW

CEILING HEIGHTS:	12'-0"
COSMETIC OVERHEAD:	N/A
SALES FLOOR:	9'-11"
PHARMACY:	9'-11"


REVISIONS

NO.	DATE	BY	DESCRIPTION
△	JUNE 12 12	MS1	PROPOSED PLAN PER REDLINE.
△	JUNE 26, 12	MS1	ADDED TWO BULKSTICKS ON S12 AND S15. PROPOSED PLAN FOR DISTRIBUTION.
△	AUG 1, 12	MS1	MERCH REVISION: WILL NEED TO CHANGE CONSTRUCTION NOTE 6-GNC COOLER. ALSO NEED TO ADD TO CONSTRUCTION NOTES FOR GNC CANOPY. FIELD VERIFIED - CHANGED CANDIDUS AND B RACKS. BULK STICK & 3 TIER BIN. ADDED 1/4" LITTER TERMINAL TO CHECK VAL.
△	AUG 23, 12	MS1	RESEARCH COMPLETE
△	SEPT 26, 2012	EQ1	RY REVISIONS - JUNE URMAL TO PROPOSE WALL, RELOCATED NEW WESTERN UNION TO PHOTO PROP. CORRECTED COLUMN LOCATIONS
△			
△			


KEY#	TYPE	LENGTH	HEIGHT-EXT	BD	FRONT-ENCAP	FRONT-BASE	FRONT-ENPANEL	BACK-ENCAP	BACK-BASE	SHELVING LEGEND	COLOR	VALANCE	LIGHTING	BRACKETS	COMMENTS
S01	NEW	28"	60"	14 BD		NEW 90" COSMETIC PROMO TABLE (66")					GREY				
S02	NEW	28"	60"	14 BD		NEW 90" COSMETIC PROMO TABLE (66")					GREY				
S03	NEW	28"	60"	14 BD		NEW HAIR (66")					GREY				
S04	NEW	20"	60"	14 BD		NEW HAIR (66")					GREY				
S05	NEW	32"	60"	14 BD		NEW HAIR (66")					GREY				
S06	NEW	32"	60"	14 BD		NEW HAIR (66")					GREY				
S07	RELO	32"	60"x6"	14 BD		WELLNESS STATION					GREY				
S08	RELO	28"	60"x6"	14 BD		GNC COOLER (66")					GREY				
S09	EXIST	16"	72"	14 BD							GREY				
S10	RELO	20"	72"	14 BD		R 36" X 60"					GREY				
S11	RELO	20"	72"	14 BD		R 36" X 60"					GREY				
S12	NEW	28"	72"	16 BD		E 24" (72")14 BD					GREY				
S13	NEW	28"	72"	16 BD		E 24" (72")14 BD					GREY				
S14	NEW	24"	72"	14 BD		E 36" (72")14 BD					GREY				
S15	NEW	24"	72"	14 BD		E 36" (72")14 BD					GREY				
S16	RELO	32"	72"	14 BD		E 24" (72")14 BD					GREY				
S17	RELO	32"	72"	14 BD		E 24" (72")14 BD					GREY				
S18	RELO	32"	72"	14 BD		E 24" (72")14 BD					GREY				
S19	RELO	32"	72"	14 BD		E 24" (72")14 BD					GREY				
S20	NEW	16"	66"	16 BD		PER PAD					GREY				
S21	NEW	16"	66"	16 BD		PER PAD					GREY				
S22	NEW	40"	90"	16 BD							GREY				
S23	NEW	40"	90"	16 BD							GREY				
S24	NEW	20"	90"	16 BD							GREY				
S25	NEW	47"	90"	16 BD							GREY				
S26	NEW	14"	90"	16 BD							GREY				
S27	NEW	4"	90"	16 BD							GREY				
S28	NEW	8"	90"	16 BD							GREY				
S29	NEW	23"	60"	12 BD							GREY				

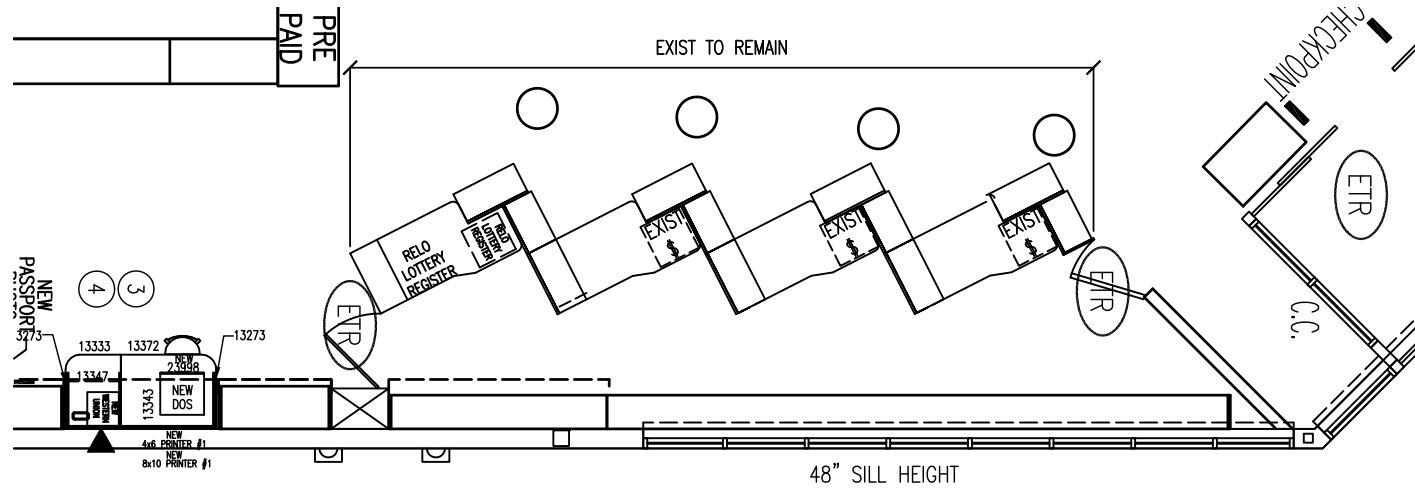

FRONT END PLAN
SCALE: 1/8" = 1'-0"

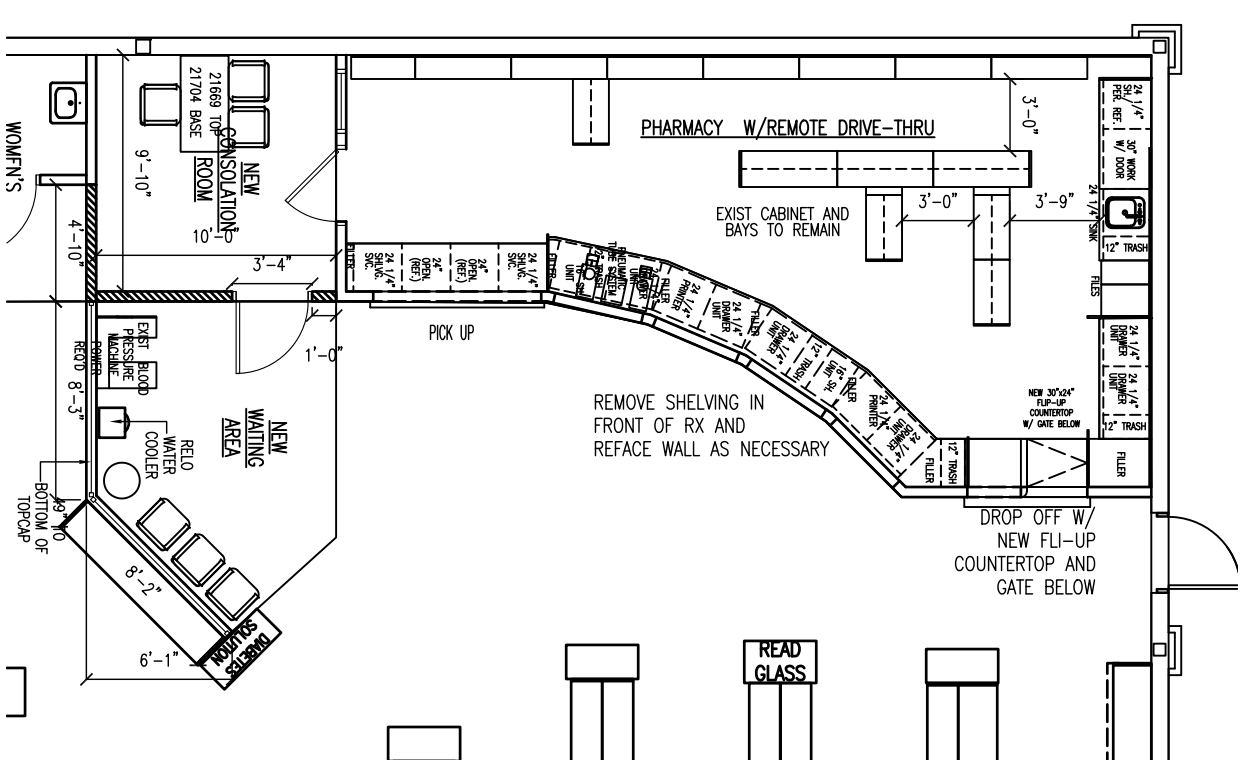

PHARMACY PLAN
SCALE: 1/8" = 1'-0"

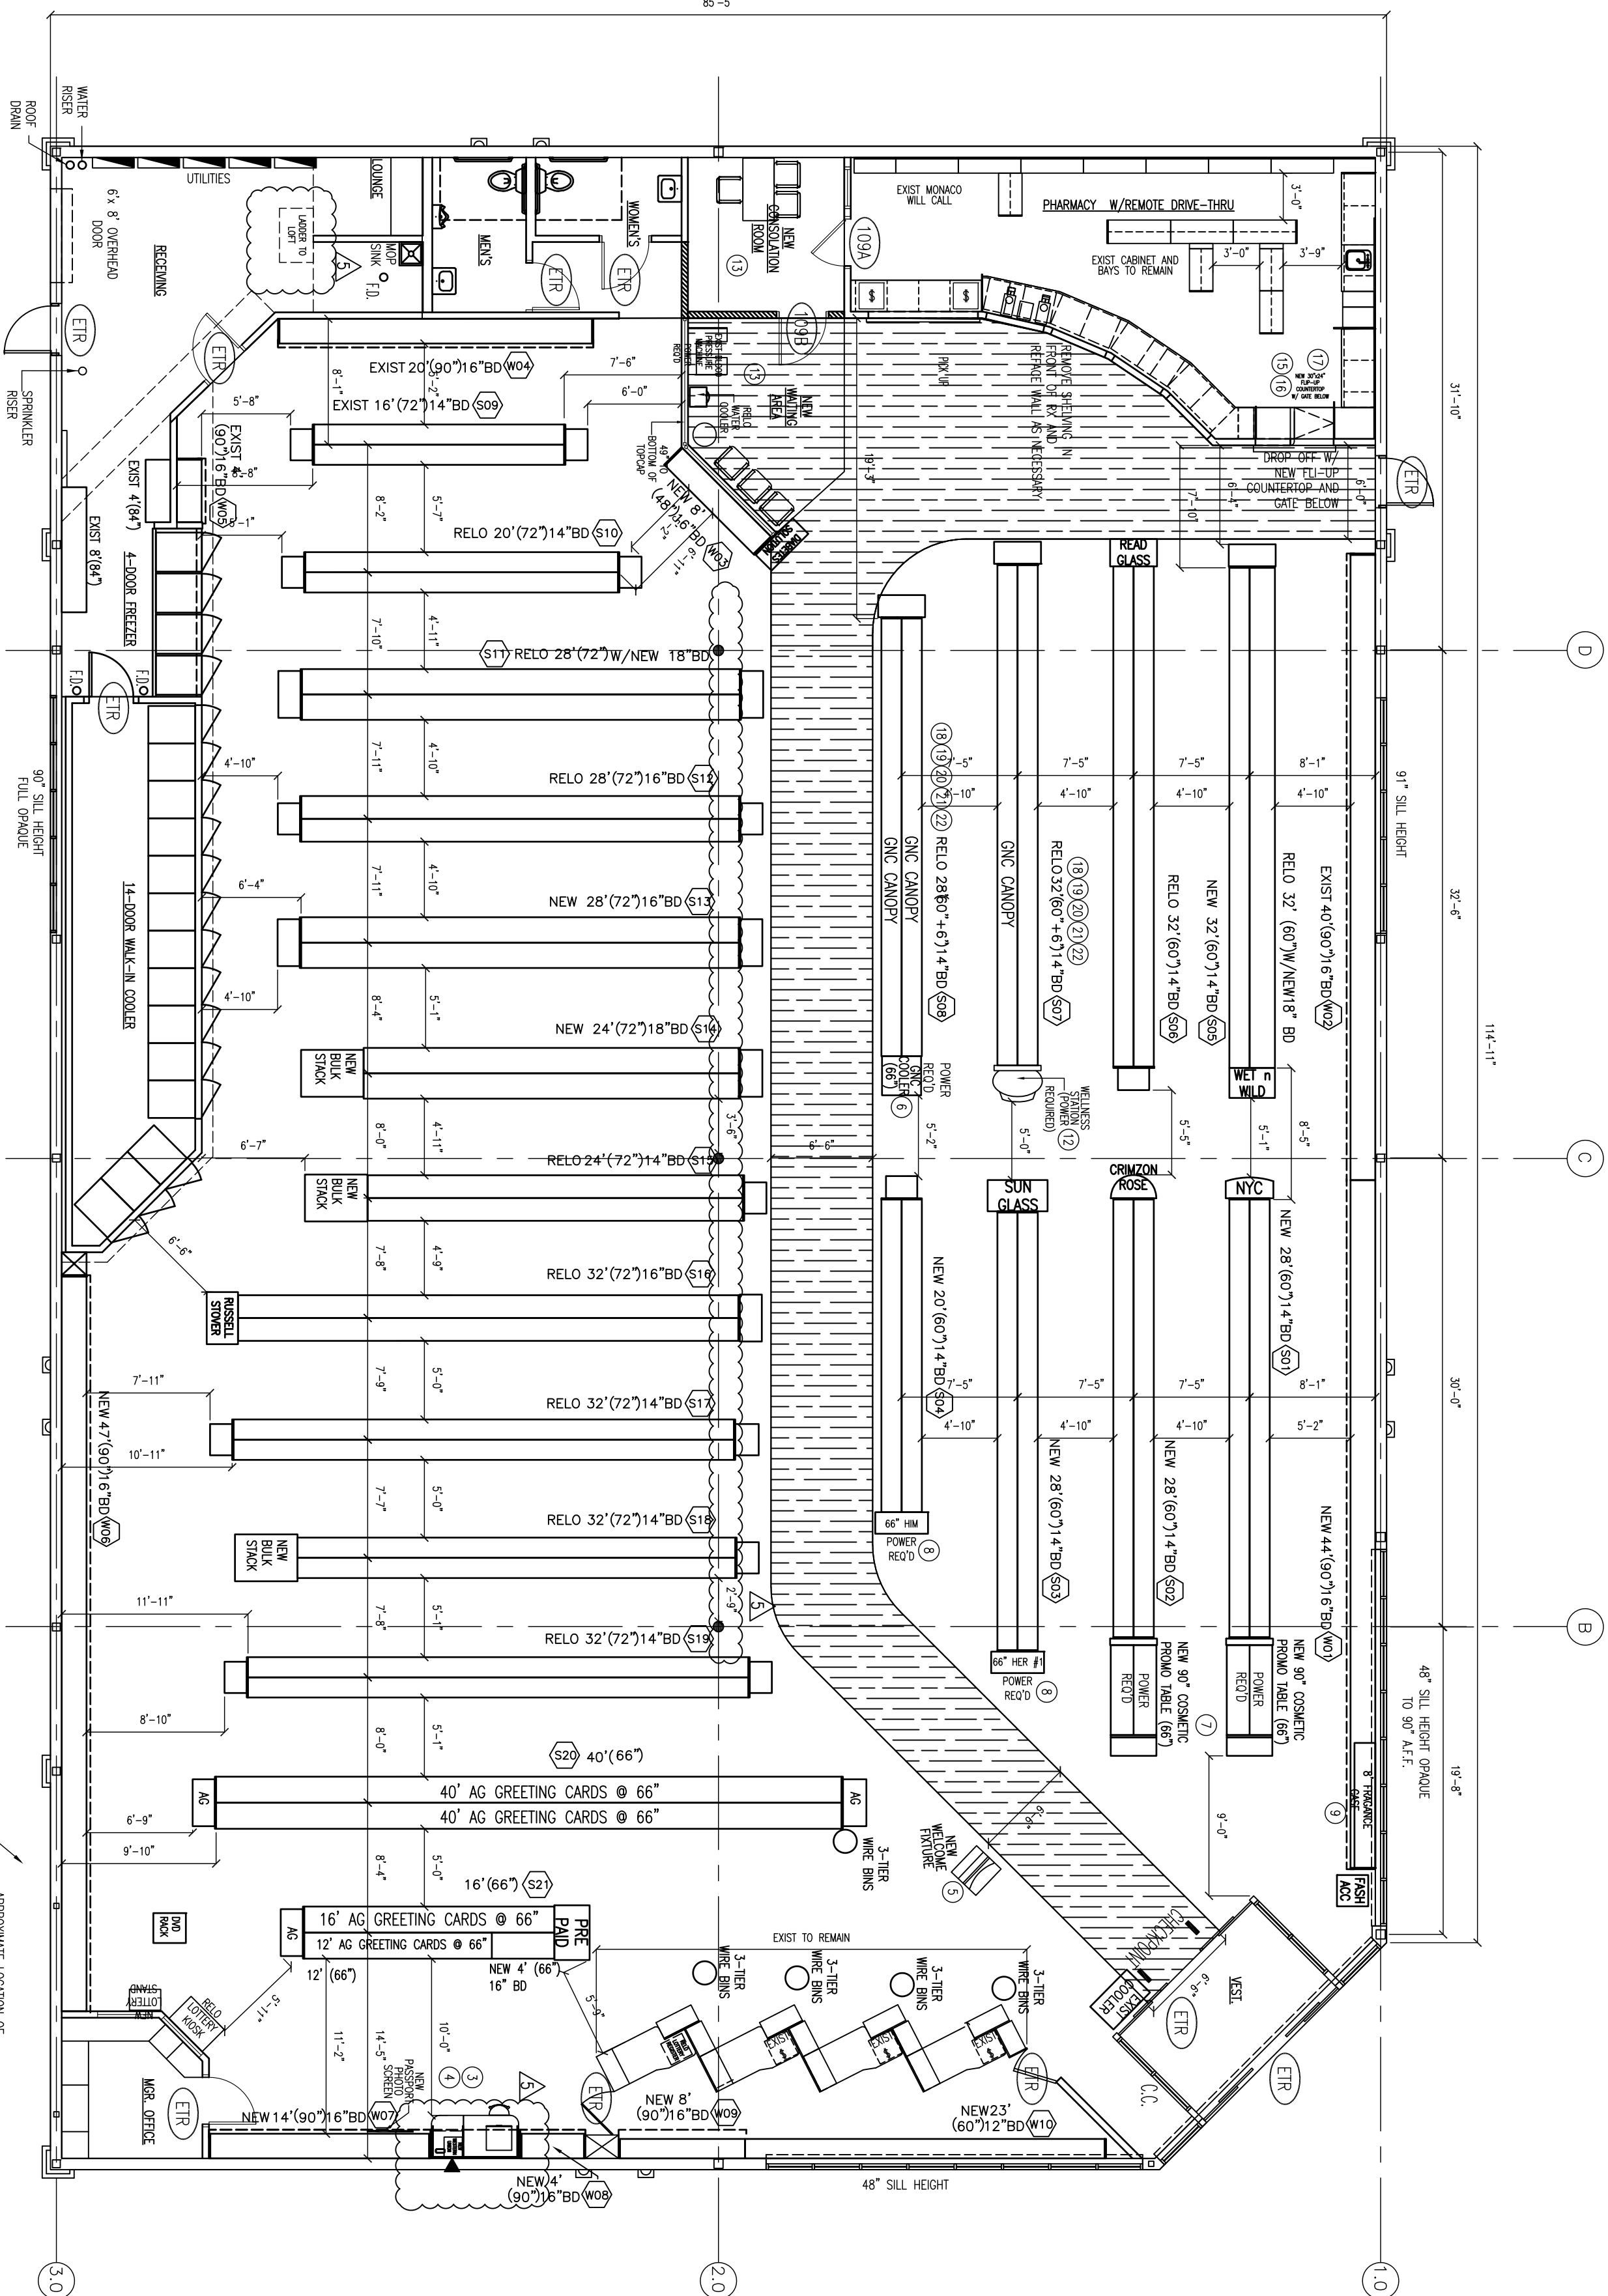

FIXTURE PLAN
SCALE: 1/8" = 1'-0"