

arctimension

Tel: 202-220-8087
Email: info@arctimension.com
www.arctimension.com

Project Address
1300 Good Hope Rd SE, Washington, DC 20020

Arctimension ID
157967

Survey Date
4/26/2023


Surveyed by
SS

Project Architect
GB

Date
5/1/2023

Sheet Number
A102


Notes
No further notes applicable.

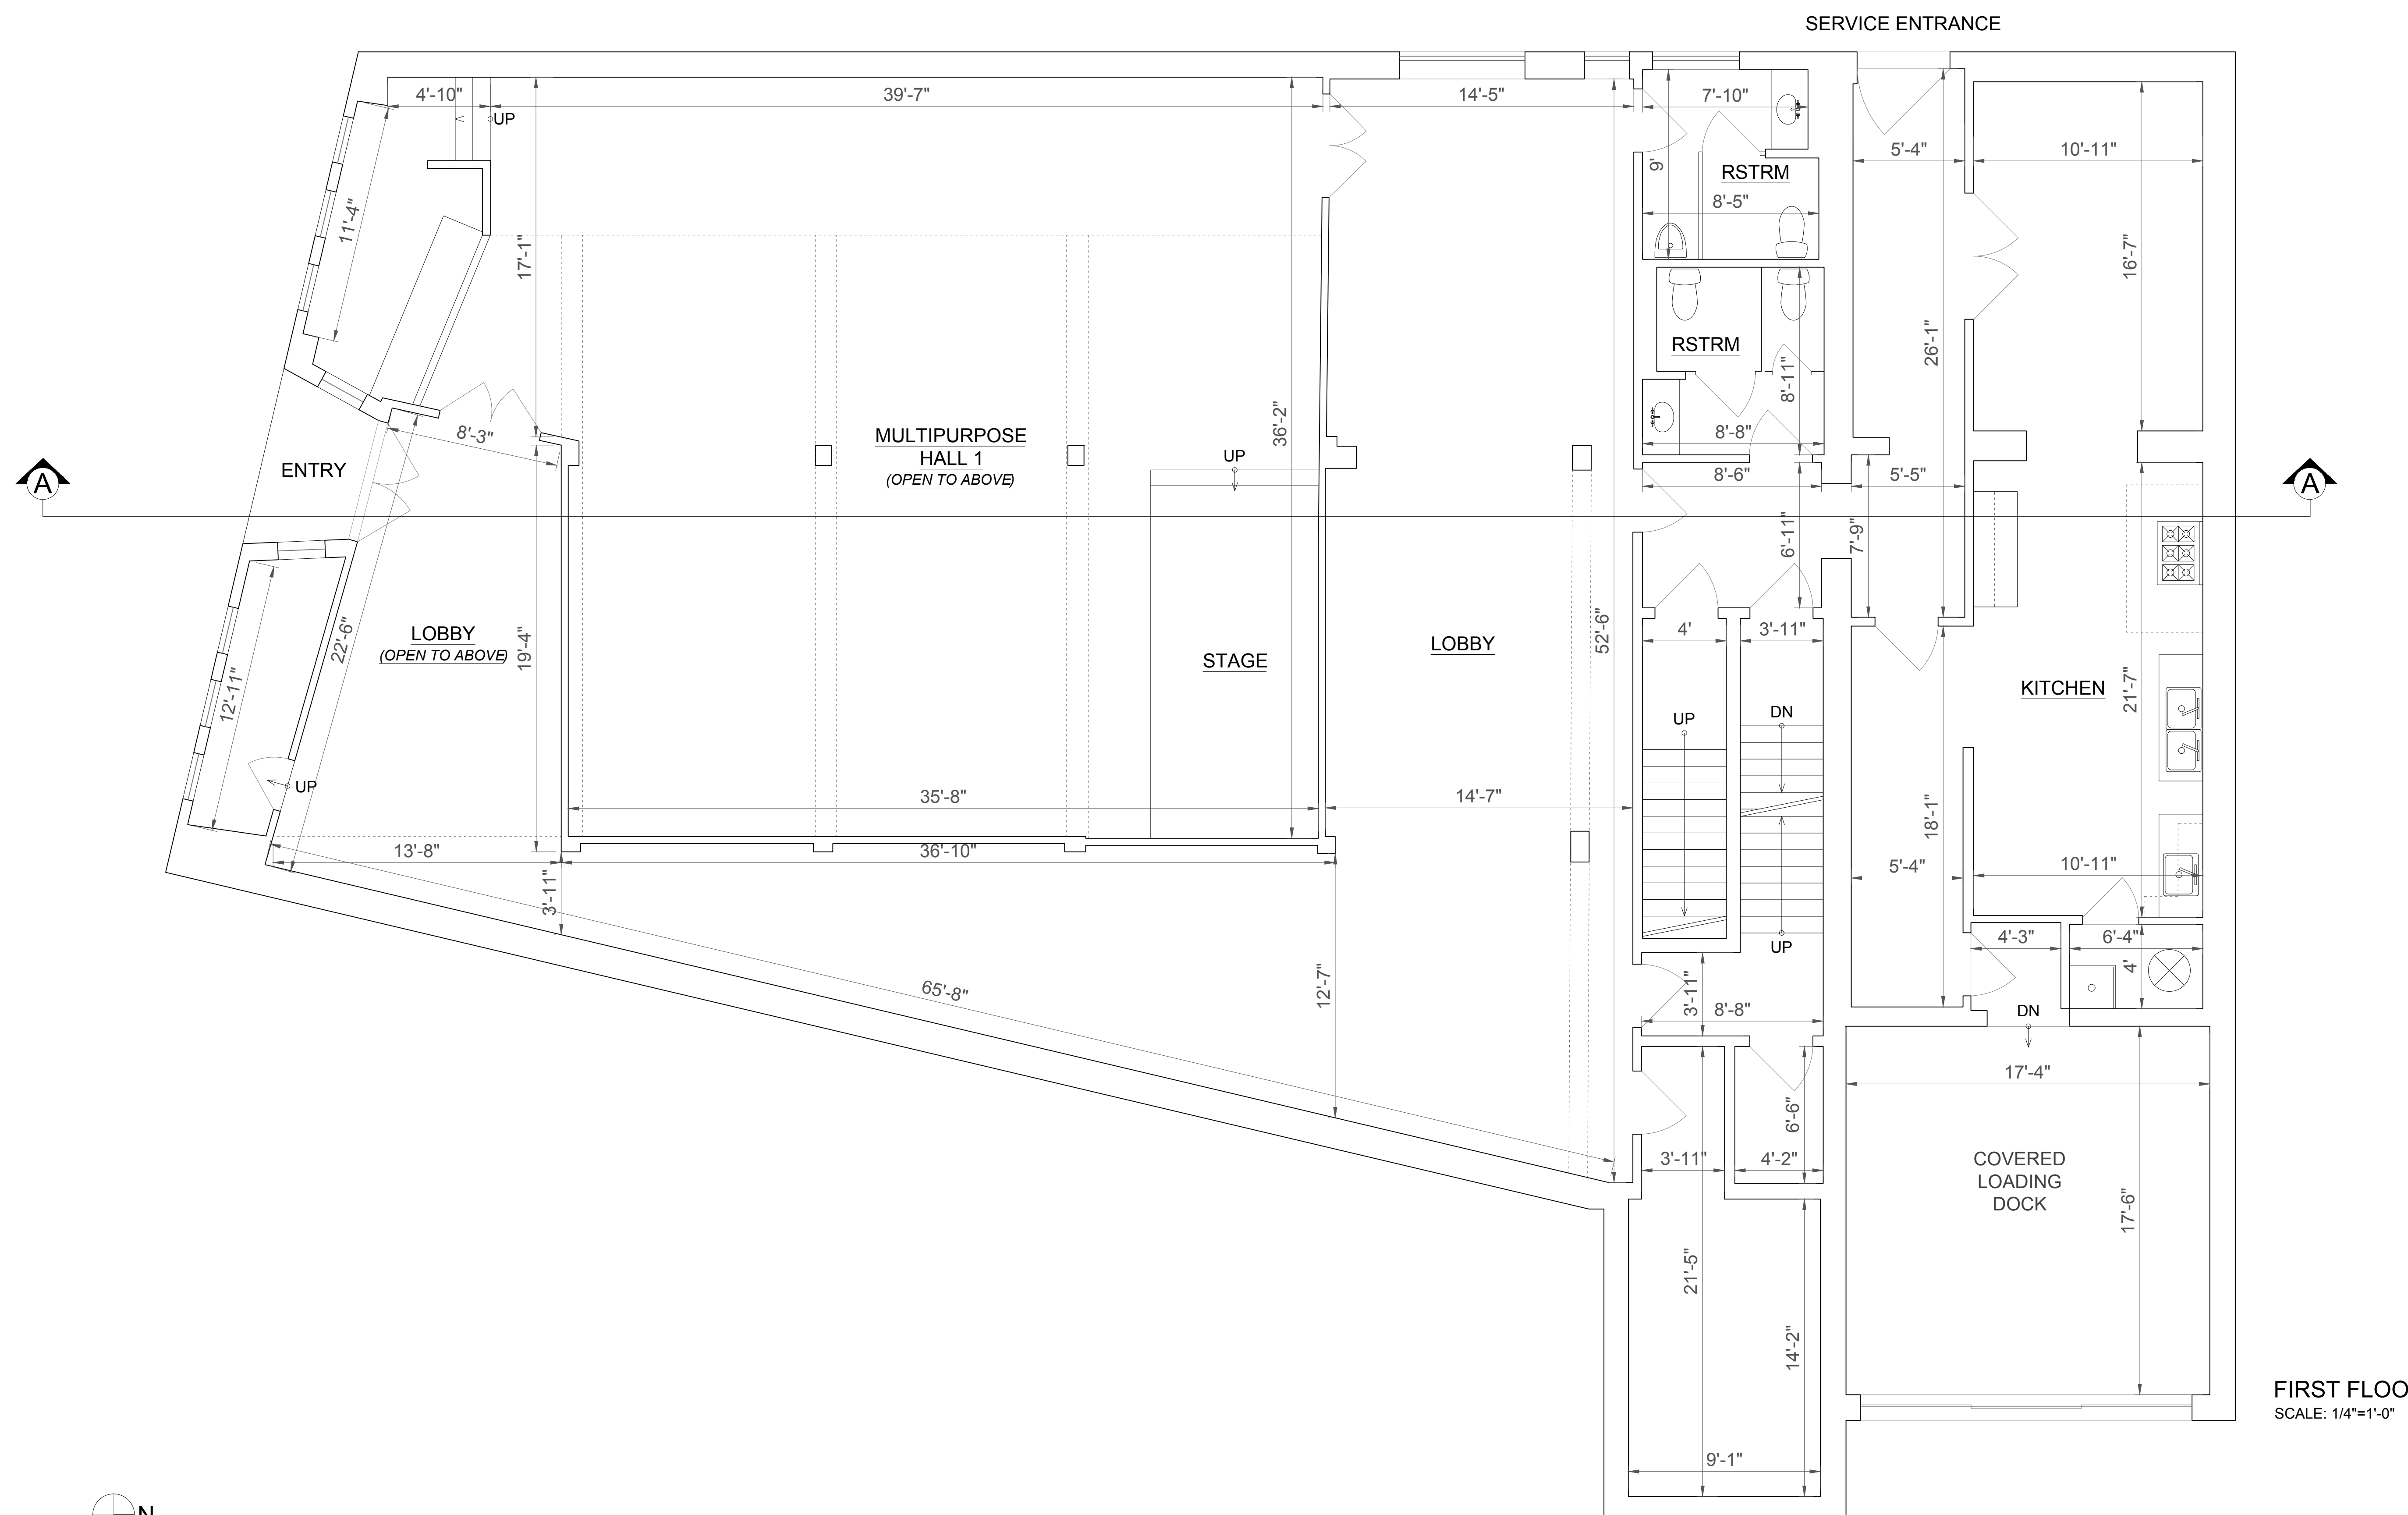

FIRST FLOOR
SCALE: 1/4"=1'-0"



While deemed reliable, no information on these as-built drawings should be relied upon without independent verification. These drawings are the property of Arctimension. Use by a third-party without written authorization is prohibited.

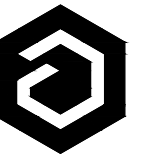

arcdimension

Tel: 202-220-8087
Email: info@arcdimension.com
www.arcdimension.com

Project Address
**1300 Good Hope
Rd SE,
Washington, DC
20020**

Arcdimension ID
157967

Survey Date
4/26/2023

Surveyed by
SS


Project Architect
GB

Date
5/1/2023

Sheet Number
A103


Notes
No further notes applicable.

While deemed reliable, no information on these as-built drawings should be relied upon without independent verification. These drawings are the property of Arcdimension. Use by a third-party without written authorization is prohibited.

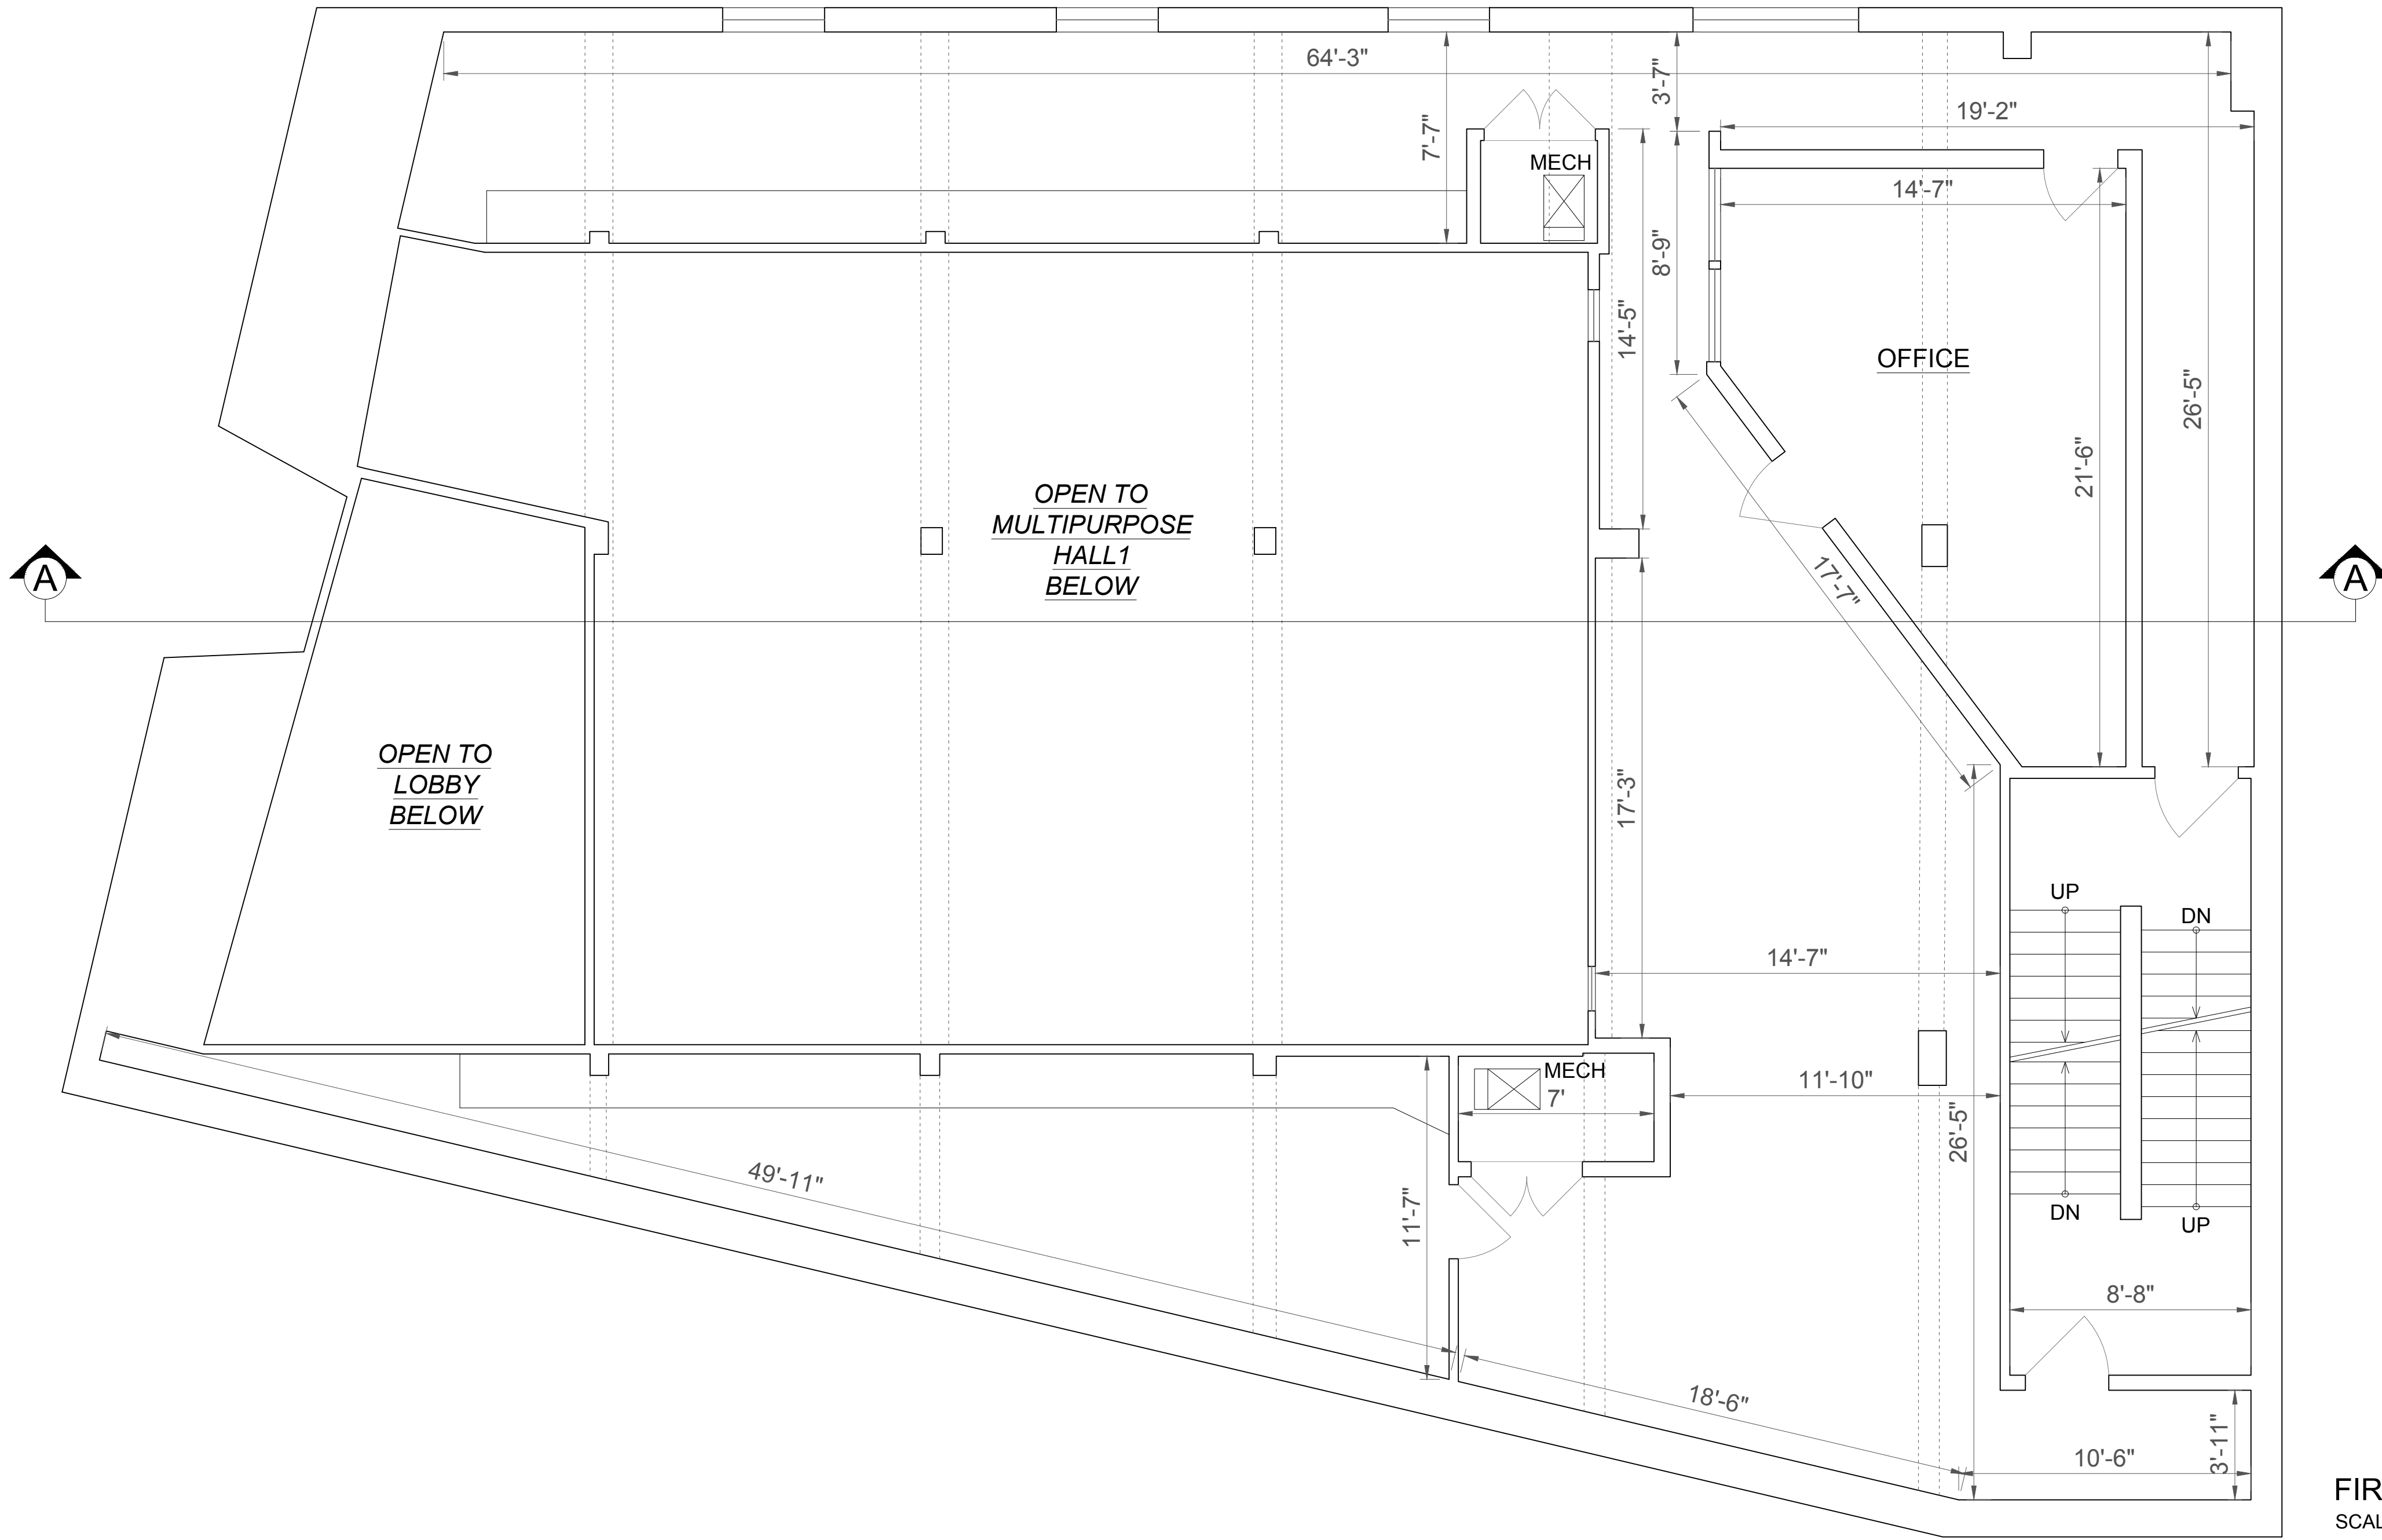

FIRST FLOOR MEZZANINE
SCALE: 1/4"=1'-0"



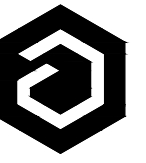

arctimension

Tel: 202-220-8087
Email: info@arctimension.com
www.arctimension.com

Project Address
**1300 Good Hope
Rd SE,
Washington, DC
20020**

Arctimension ID
157967

Survey Date
4/26/2023


Surveyed by
SS

Project Architect
GB

Date
5/1/2023

Sheet Number
A104


Notes
No further notes applicable.

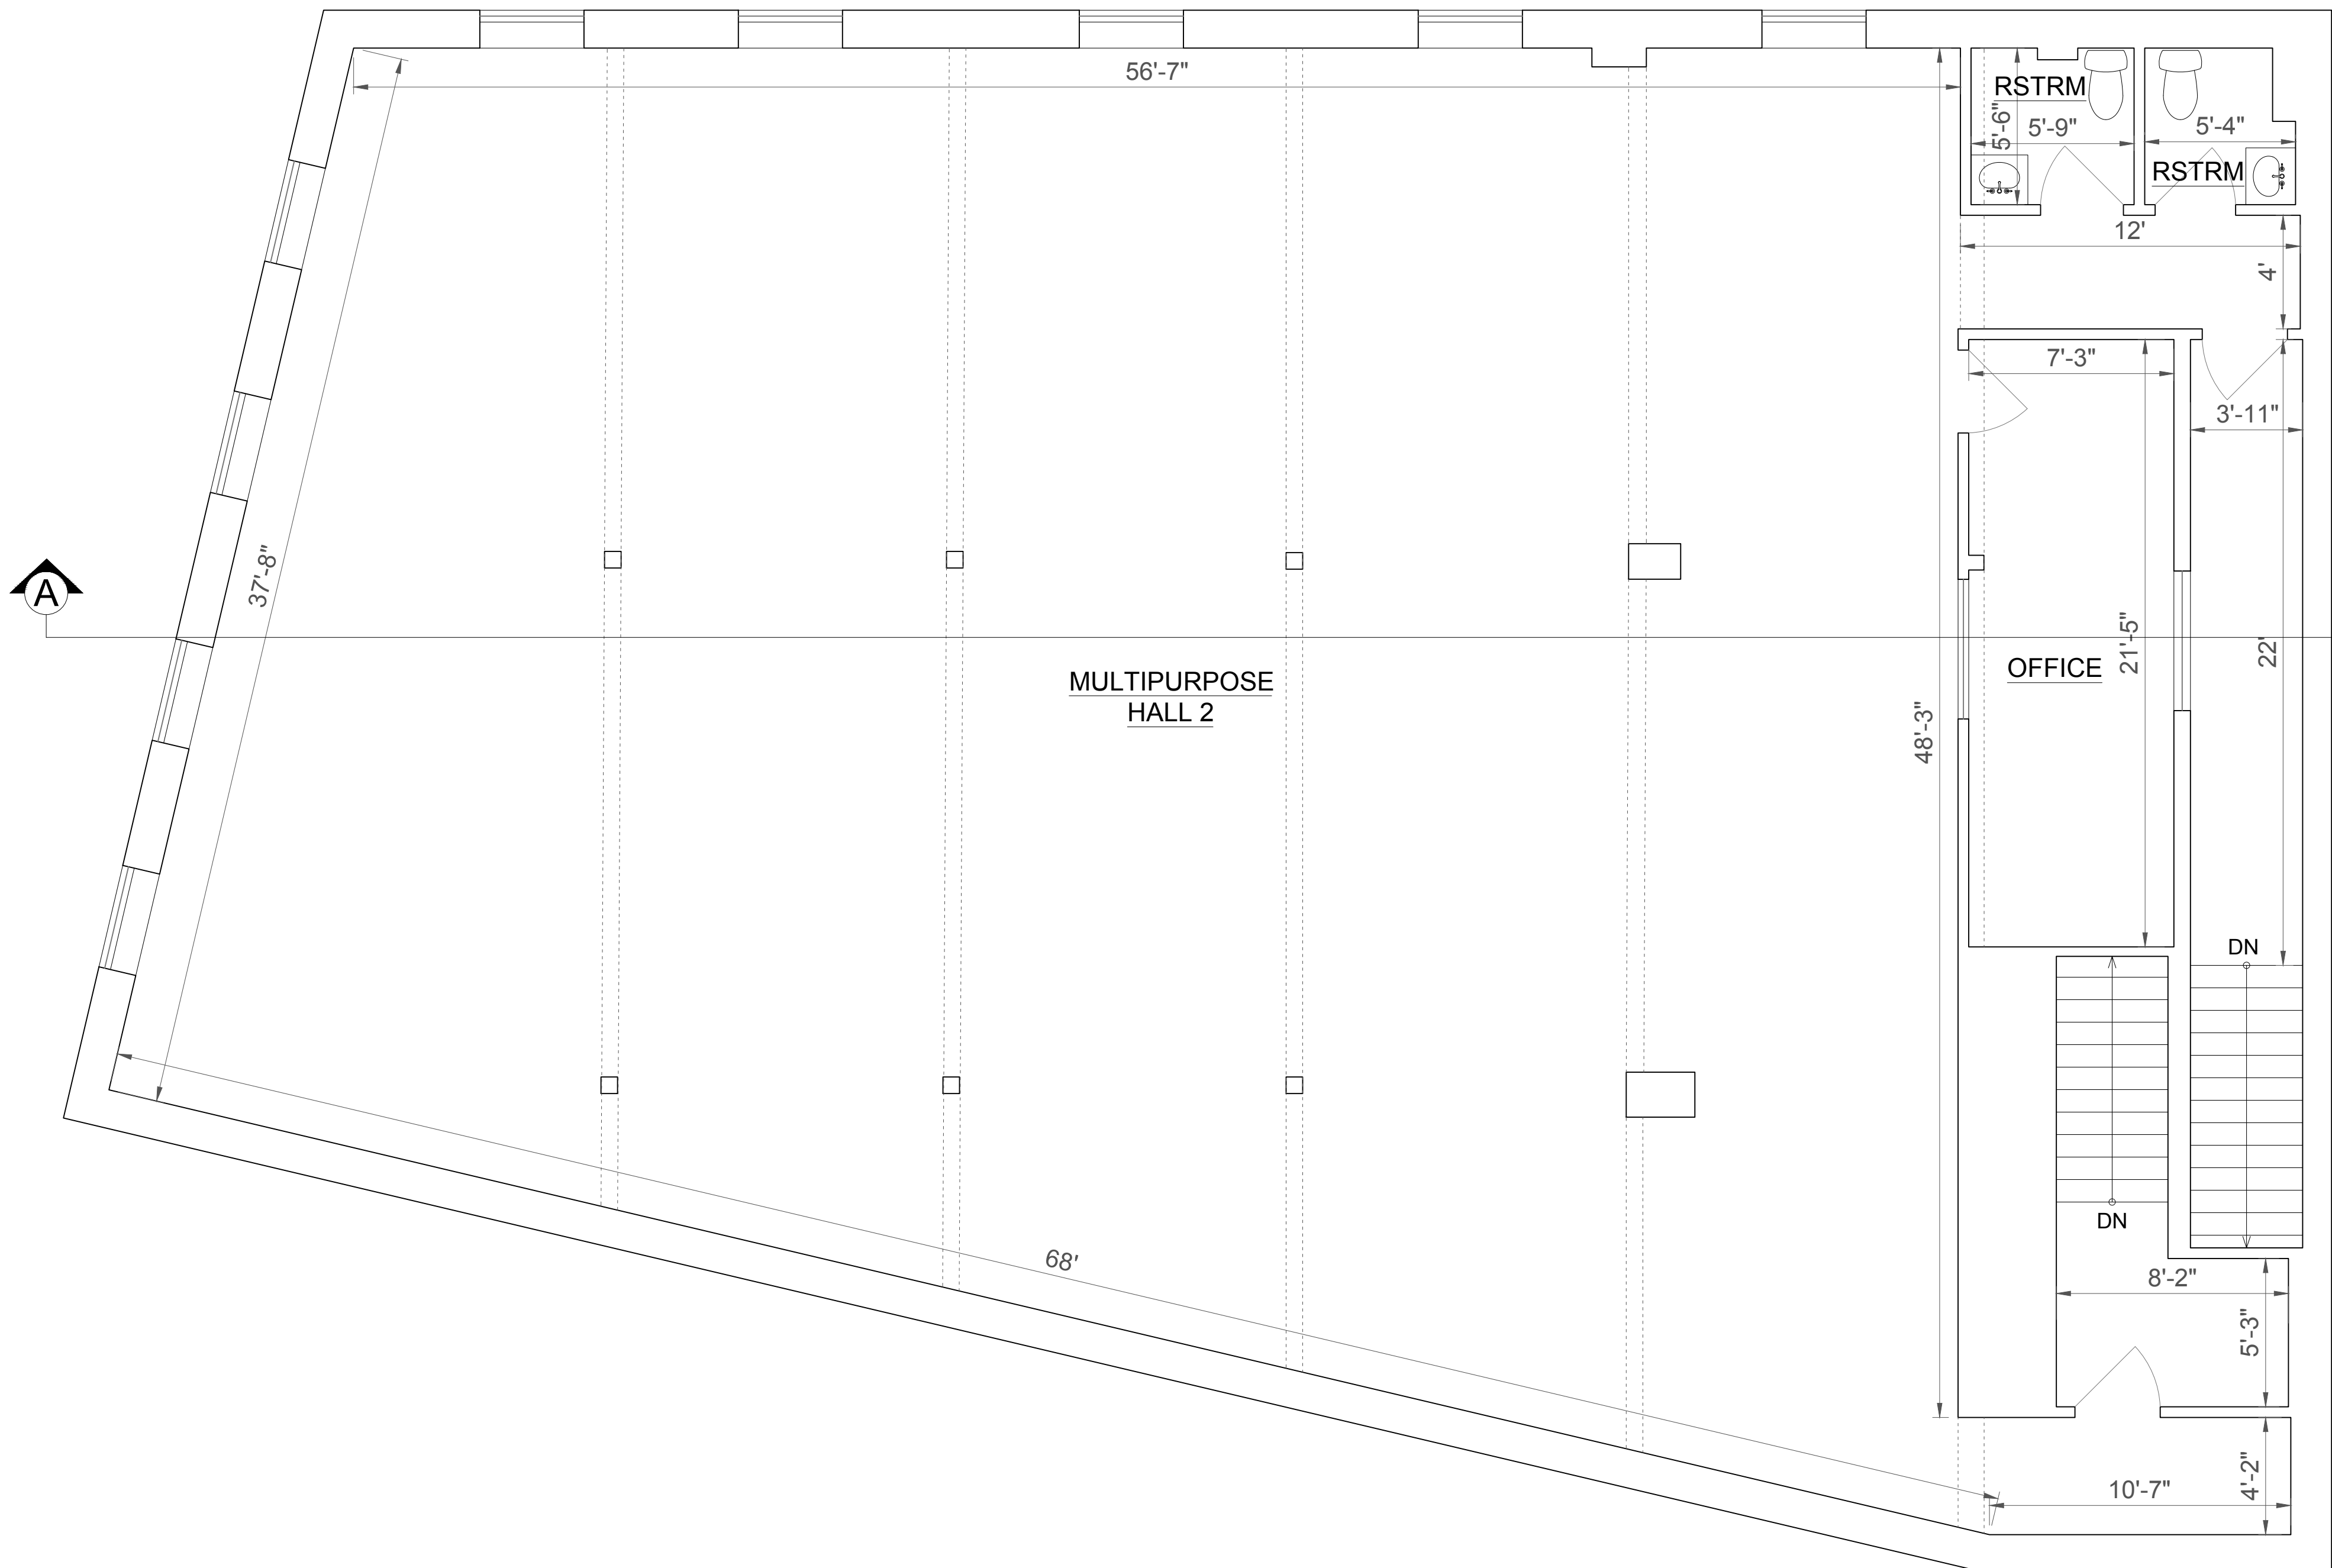

SECOND FLOOR
SCALE: 1/4"=1'-0"



While deemed reliable, no information on these as-built drawings should be relied upon without independent verification. These drawings are the property of Arctimension. Use by a third-party without written authorization is prohibited.

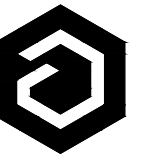

arcdimension

Tel: 202-220-8087
Email: info@arcdimension.com
www.arcdimension.com

Project Address
1300 Good Hope Rd SE, Washington, DC 20020

Arcdimension ID
157967

Survey Date
4/26/2023


Surveyed by
SS

Project Architect
GB

Date
5/1/2023

Sheet Number
A101

Notes
No further notes applicable.

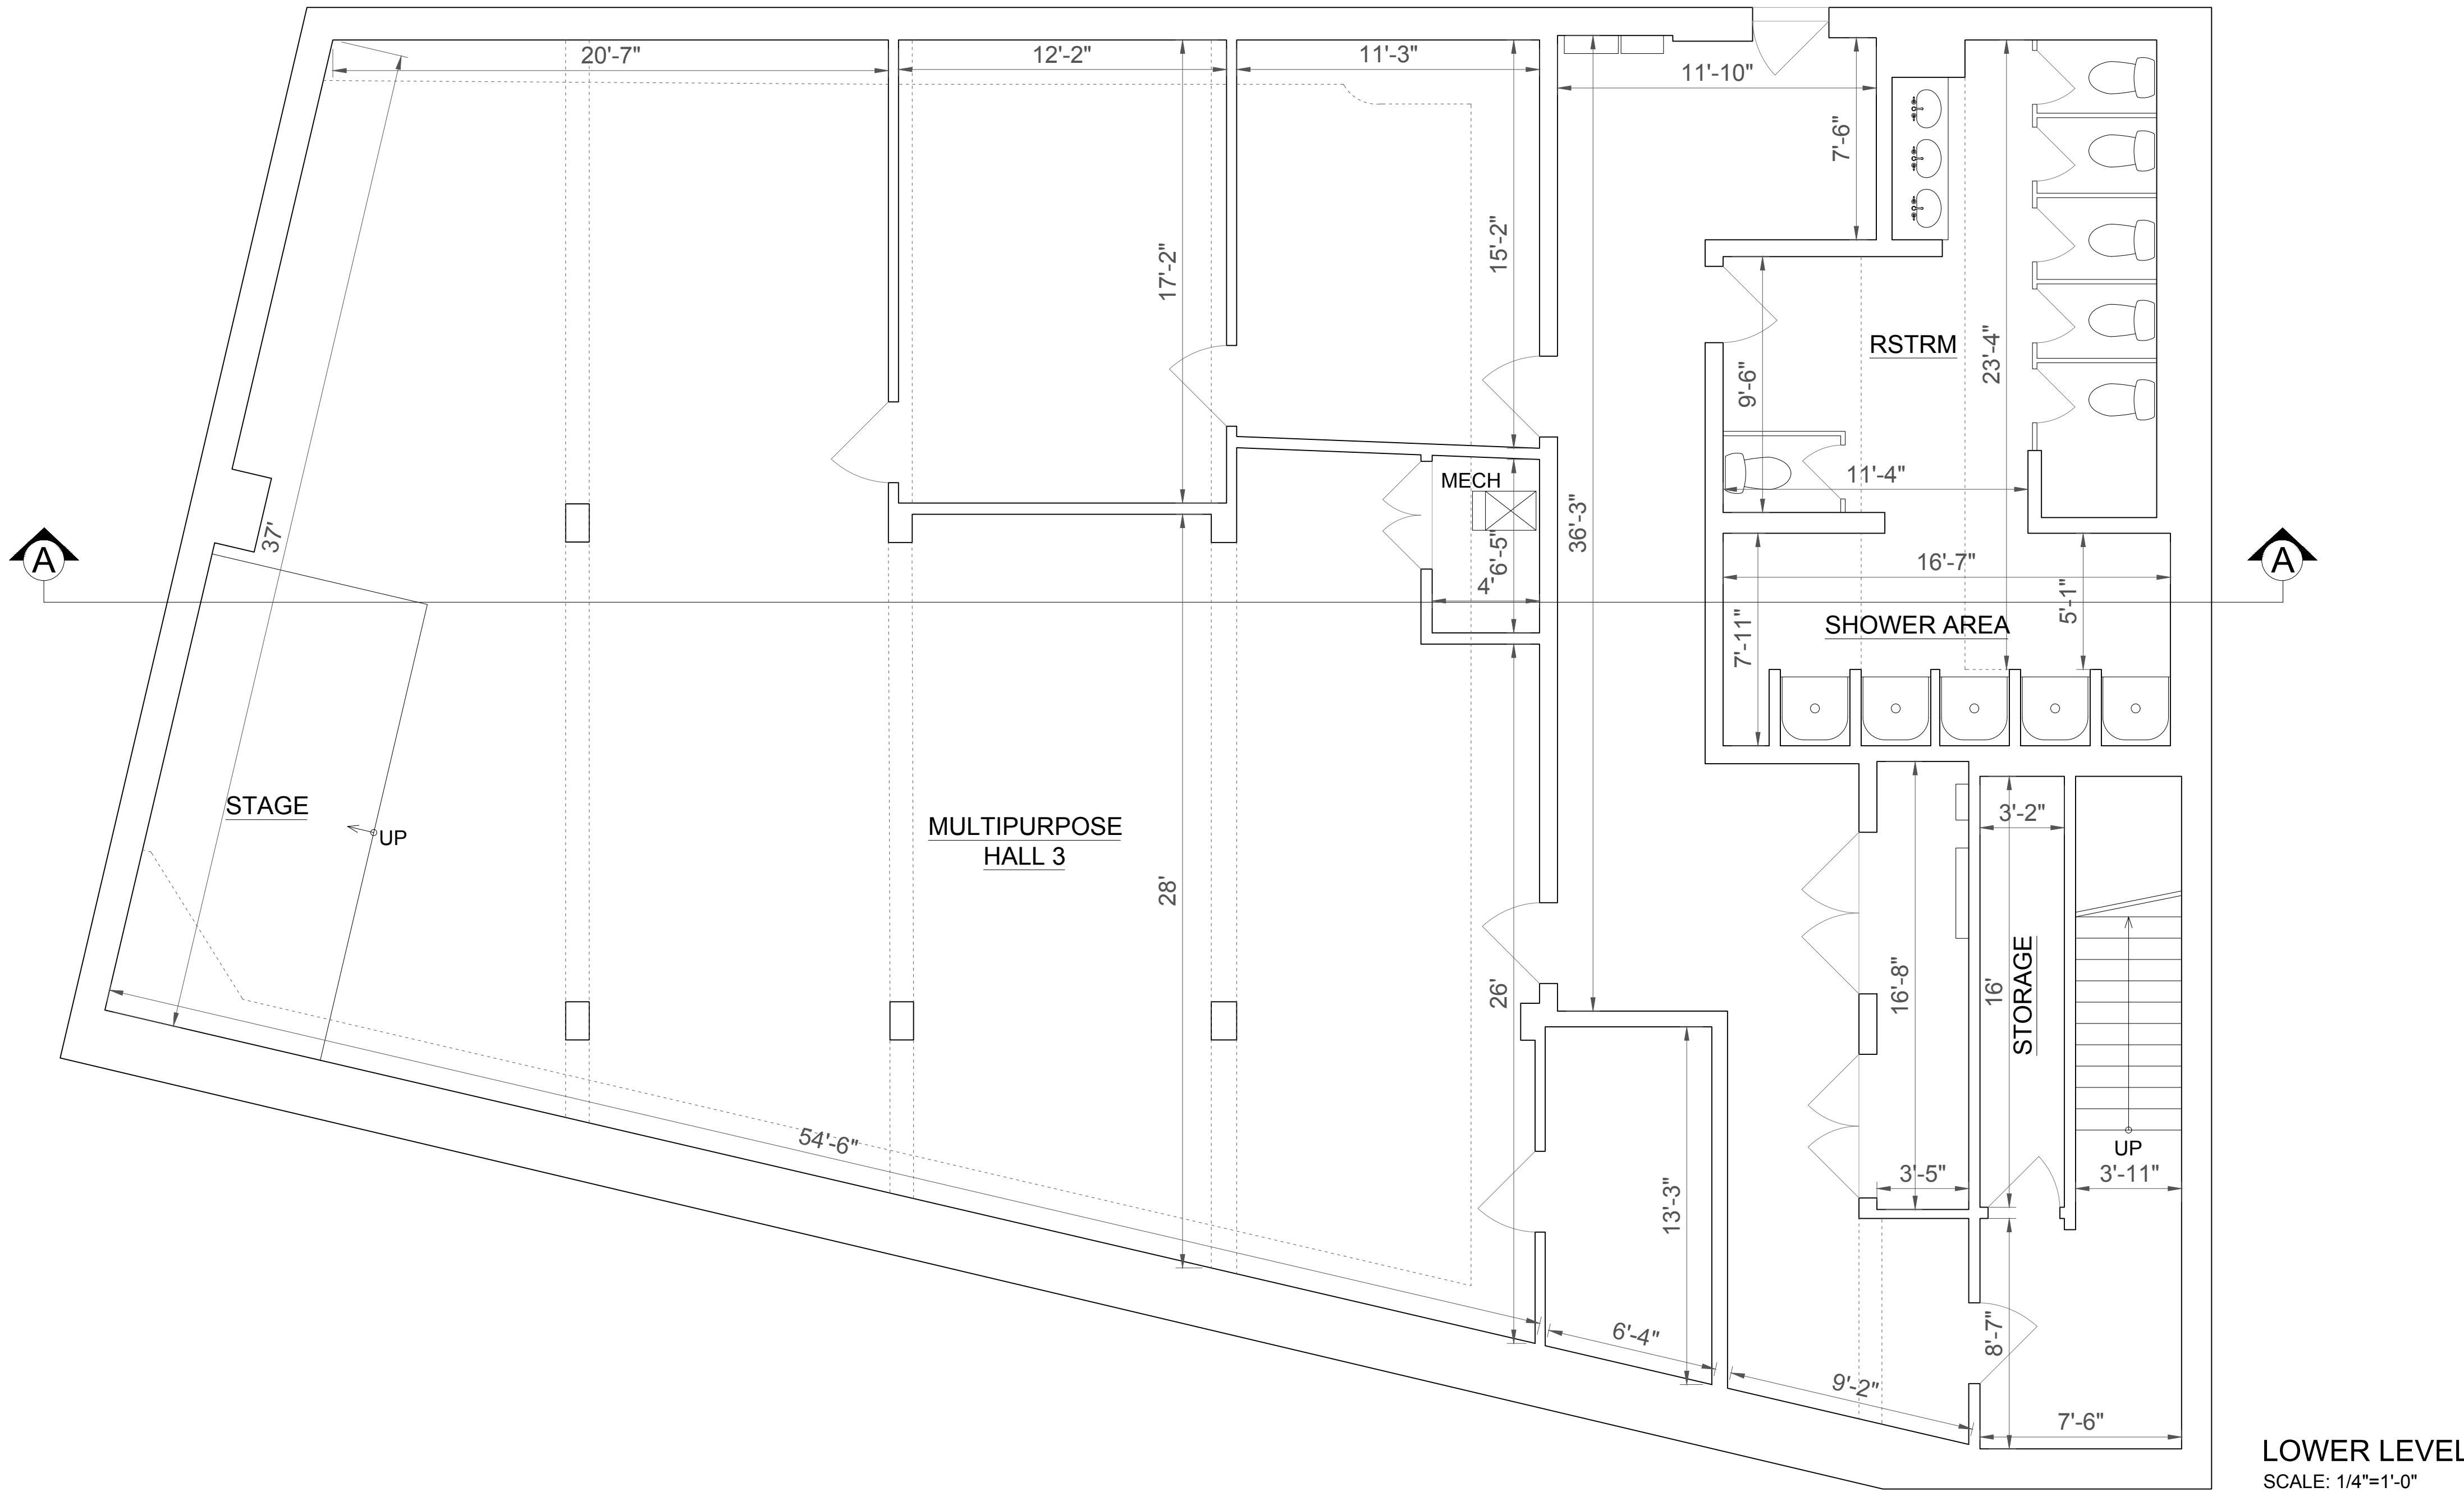

LOWER LEVEL
SCALE: 1/4"=1'-0"



While deemed reliable, no information on these as-built drawings should be relied upon without independent verification. These drawings are the property of Arcdimension. Use by a third-party without written authorization is prohibited.