

Plan A Services Inc.
 70 Gilbert St
 Monroe NY 10950
 718.219.4749
 info@planaservices.com
 planaservices.com

Project


17 Bannard St,
 Freehold, NJ 07728,
 United States

Drawing

 **As-built Floor Plan**

A - 002.00

Area	5700 SF
Scale	3/8" = 1'-0"
Date	04/16/2022
Drawn By	O. P.
Notes	

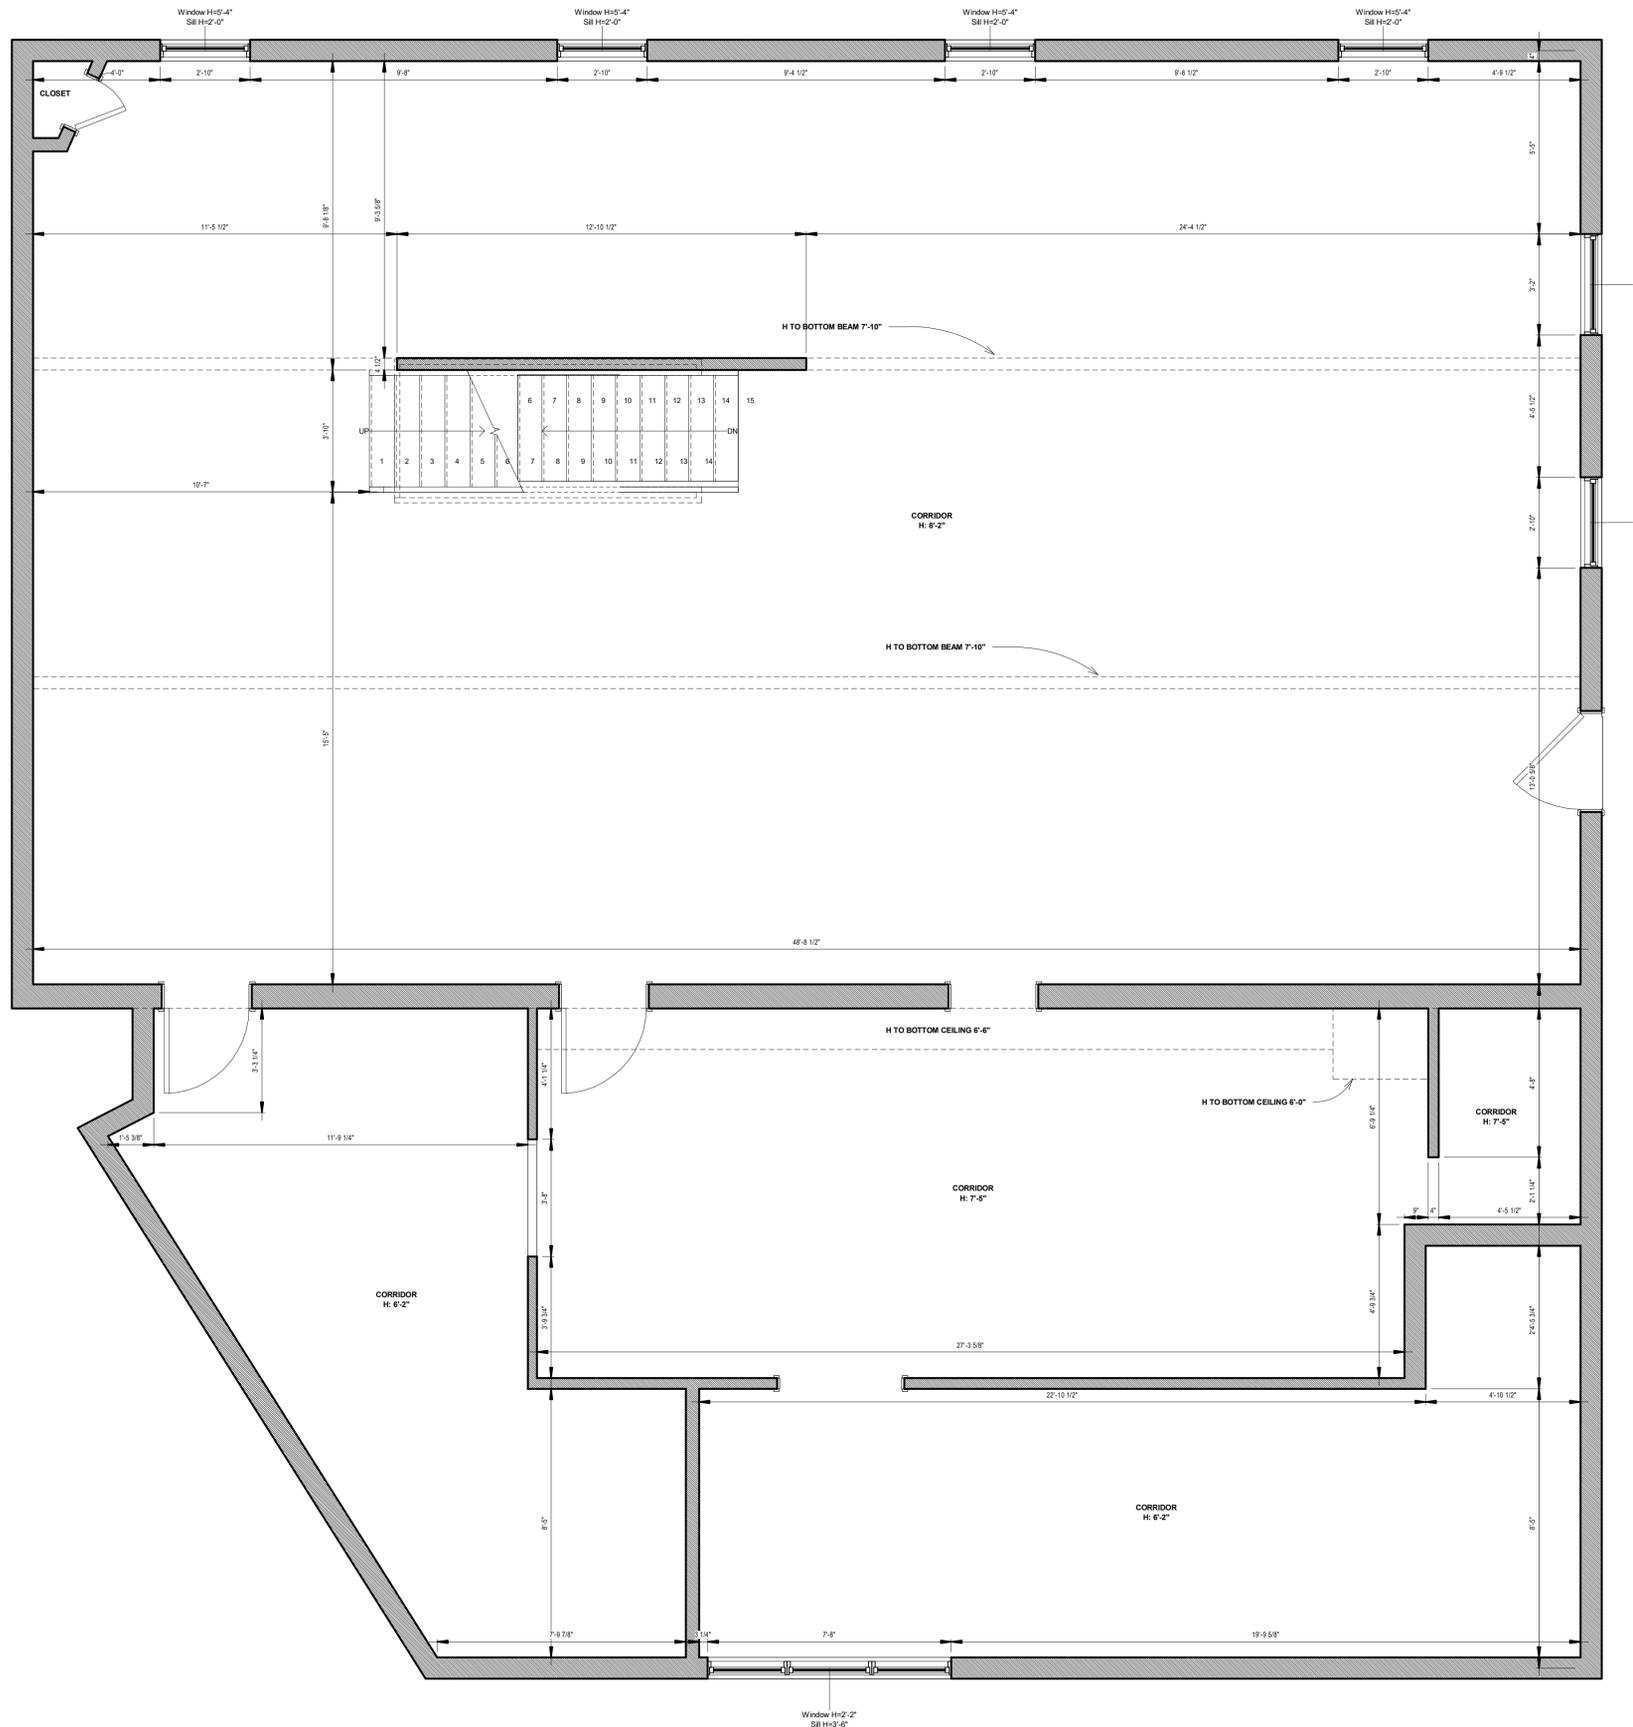

① As-built 2nd Floor
 3/8" = 1'-0"

AREA - 2450 SF
 Building #7