


## Property Key

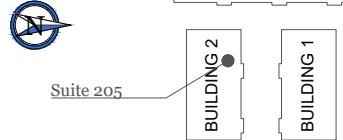

## Monroe Business Park

10031 Monroe Drive  
Suite 205  
Dallas, Texas 75229

Sheet **A3**  
Of 5 Sheet(s)

Scale: Not to Scale  
Sheet Size: 11" x 8.5"  
Not For Construction

**BAY  
SPACE**


© 2025 HosScans, LLC.  
All rights reserved.  
These drawings and any associated  
documents are protected under U.S.  
copyright law. No part of this work may  
be produced, distributed, or used in any  
form, by any method, for any purpose,  
without the prior written consent of  
HosScans, LLC. Unauthorized use is  
subject to legal action.

## Usable Square Foot Analysis

	SQFT	BUILDING PERCENTAGE
OFFICE AREA:	849	36%
WAREHOUSE AREA:	1,457	64%
TOTAL AREA:	2,306	

## Building Information

Deck Height:	20'0"
Clear Height:	18'0"
Ceiling Height:	8'10"
Sprinklered:	No
Mechanical Area:	N/A

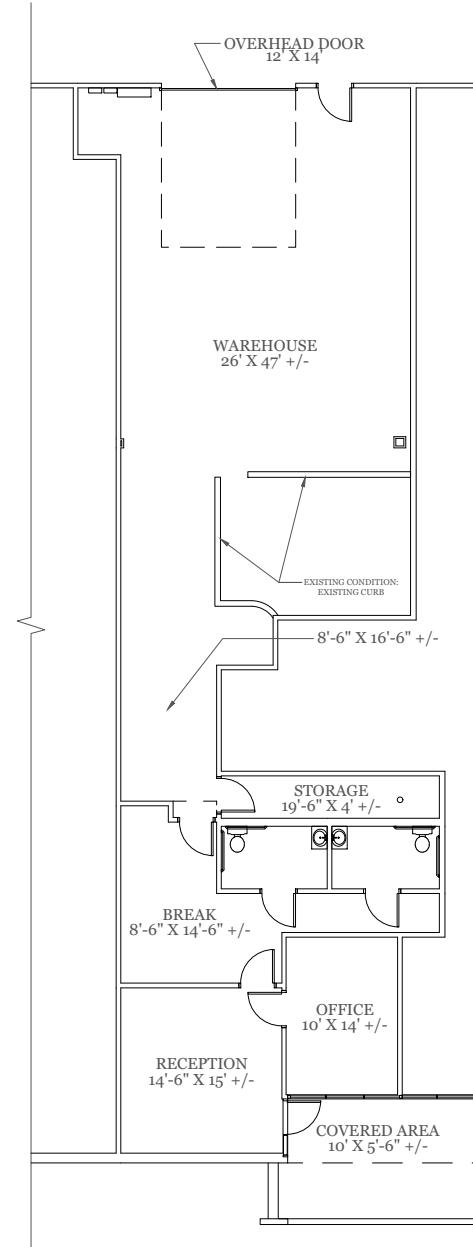

As Built Floor Plan for Marketing

