
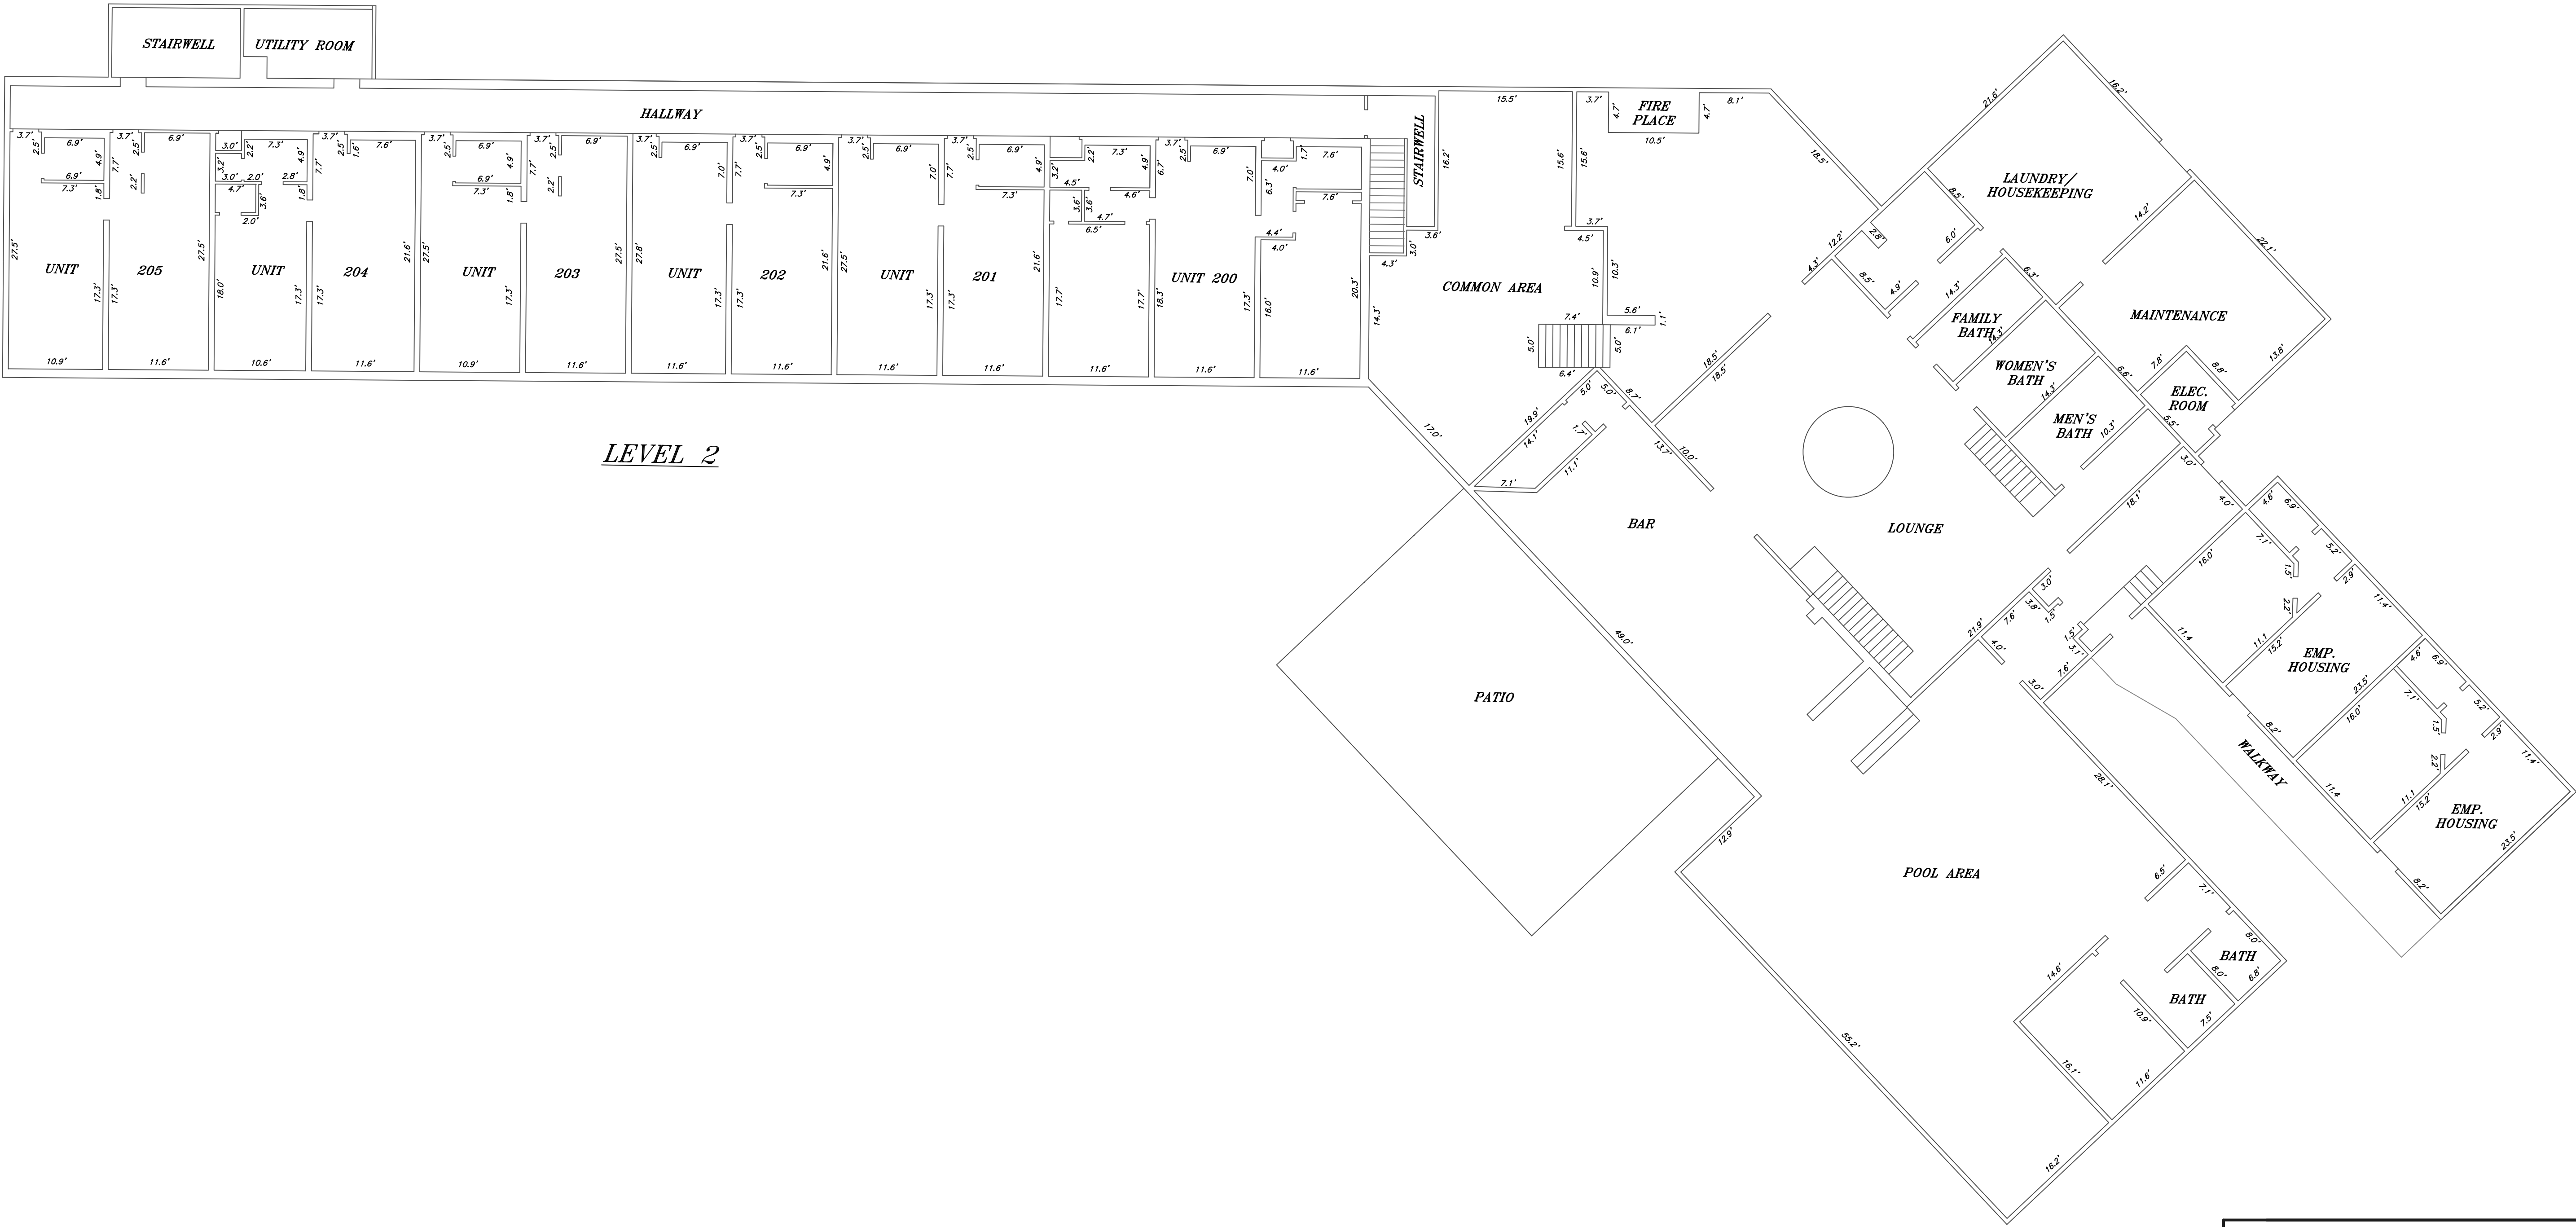


LODGE BY THE BLUE
UNIT ASBUILTS
SUMMIT COUNTY, COLORADO

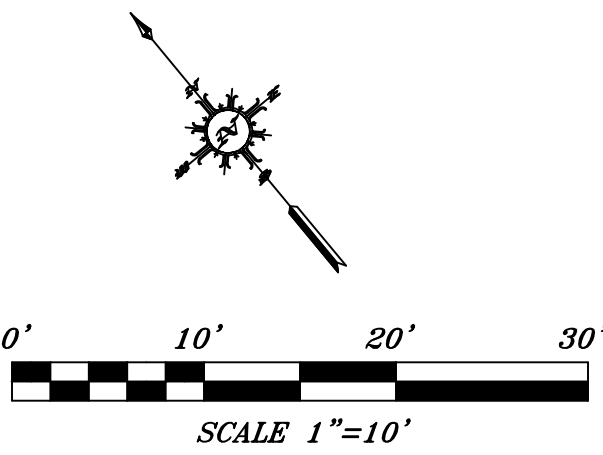

LEVEL 2

Baseline Surveys LLC			
LODGE BY THE BLUE UNIT ASBUILTS SUMMIT COUNTY, COLORADO			
Date		Revisions	
		Date: 7/3/2024	Scale Horiz: 1" = 10'
		Drawn By: R.D.G.	Checked By: N.P.O.
		DWG File: 4675 asb	Job File: 4675