


PUBLIC CORRIDOR




18.5x34

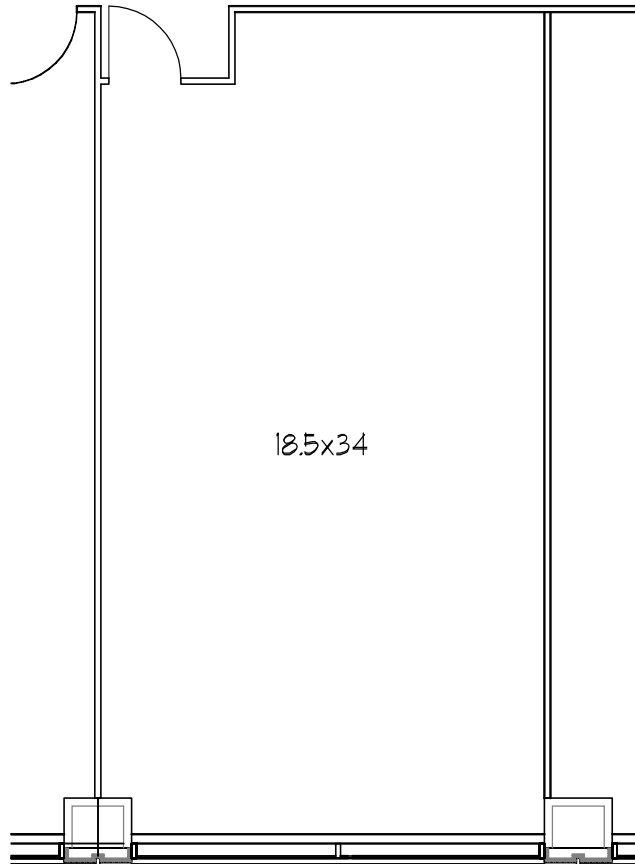

VARADY
ASSOCIATES
INC.
INTERIOR DESIGN

30400 TELEGRAPH · SUITE 120
BINGHAM FARMS, · MI · 48025
248 · 644 · 3990 FAX: 248 · 644 · 3952

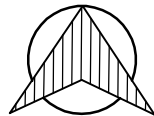

NORTH

AS-BUILT PLAN

OAKLAND COMMONS II - SUITE 330

20750 CIVIC CENTER DRIVE

SOUTHFIELD, MICHIGAN 48076

DATE: 6-12-12

SCALE: 1" = 20'-0"

750 RENTABLE SQ. FT.

Farbman
Group
FULL SERVICE REAL ESTATE SOLUTIONS

NAI Farbman
COMMERCIAL REAL ESTATE SERVICES, WORLDWIDE

CONTACT: LESLEY GUTMAN
(248) 351-4383 LGUTMAN@FARBMAN.COM