


1001 COLORADO AVENUE  
SANTA MONICA, CA 90401

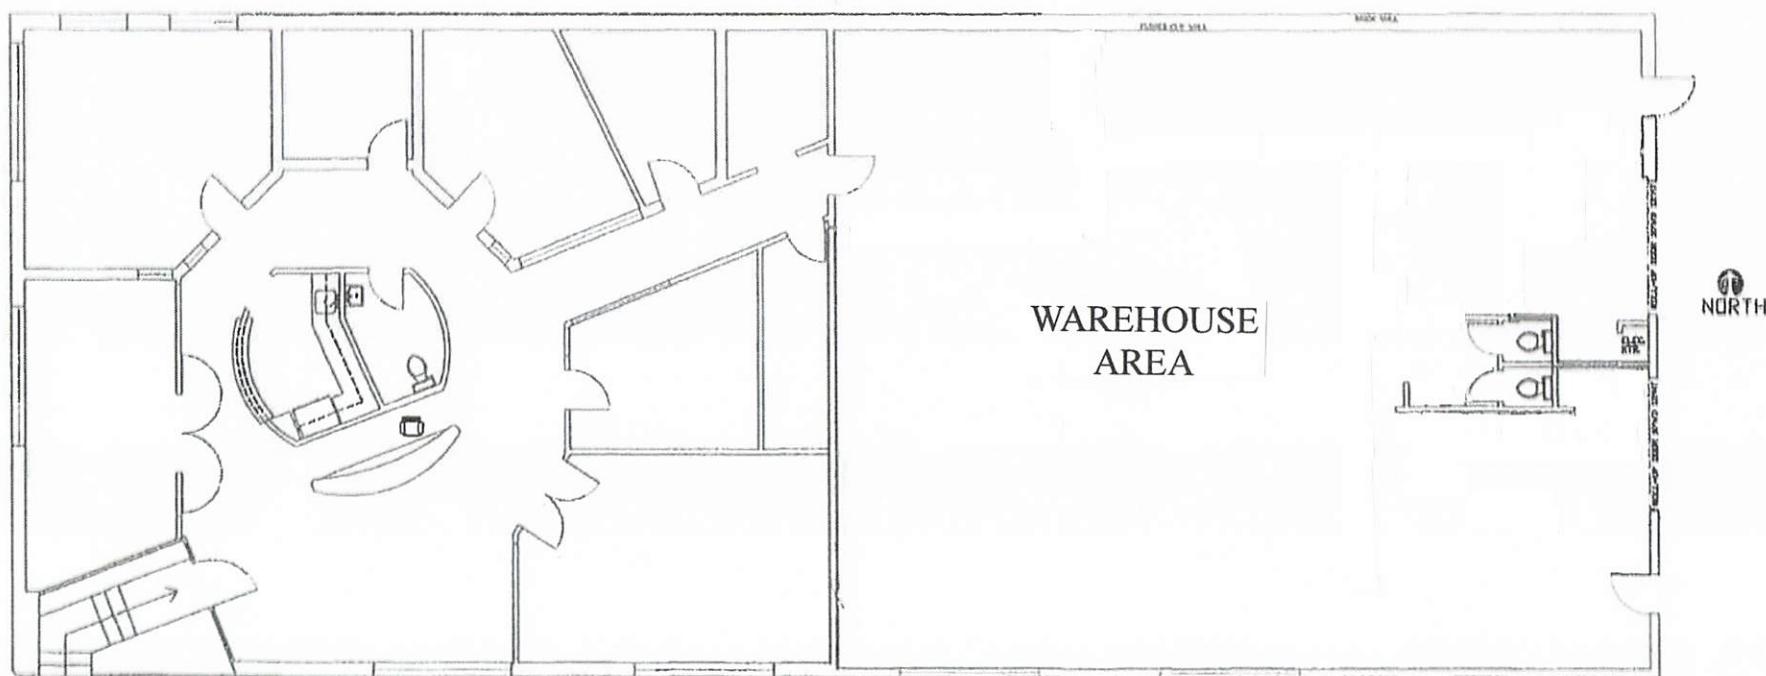

1001 COLORADO  
SANTA MONICA CA

NO SCALE

AS BUILT DRAWING

APPROX. 6,200 SQ. FT.

DARK LINES = DEMISING WALLS

THIS DRAWING IS FOR MARKETING PURPOSES ONLY, AND WHILE ACCURATE FOR THE PURPOSE INTENDED, IT IS NOT PERFECT.  
USERS WITH CRITICAL DIMENSIONAL REQUIREMENTS MUST VERIFY INDEPENDENTLY.

THE ALTEMUS COMPANY

Commercial Real Estate

Since 1946

(310) 478-7727

Fax (310) 479-5181

1537 Pontius Avenue, Los Angeles, California 90025