


3921 East Baseline Road

Gilbert . Arizona
Suite 100 - 3,070 RSF

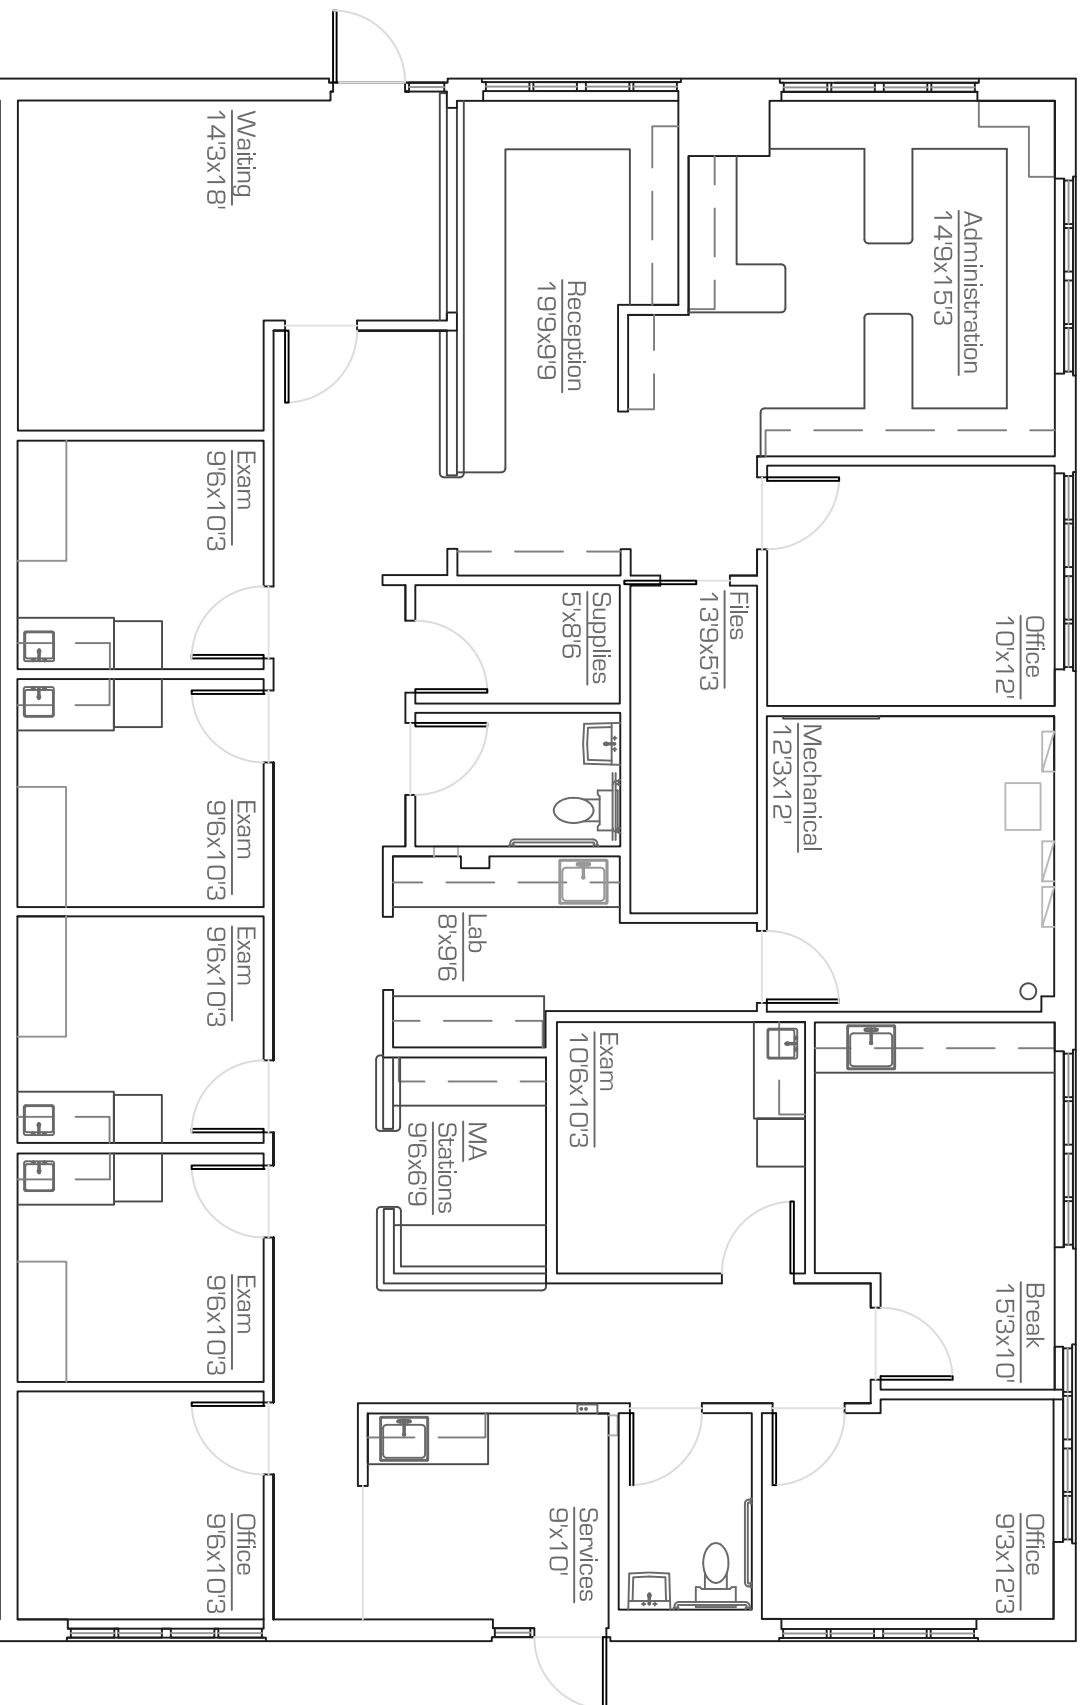


as-built

scale: 1/8" = 1'-0"

29.December.2019

* All dimensions are approximate at ± 3"
* All information is of general nature

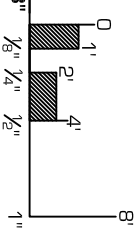

precision DIMENSIONS

as-built & design
602. 790. 6412

