


177 HUNTINGTON AVE

FLOOR PLAN

19TH FLOOR | 4,267 SF
AS BUILT

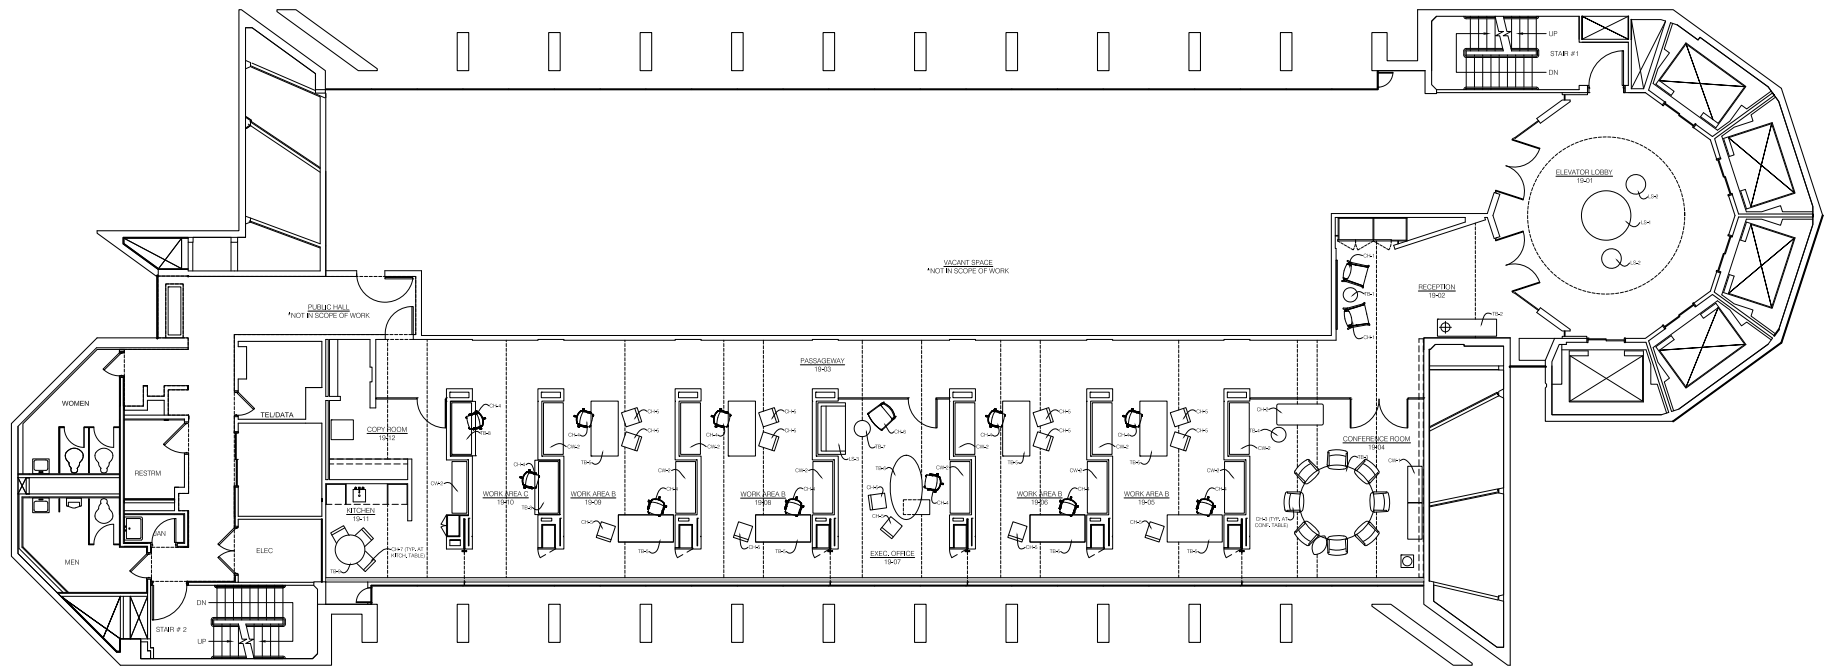

WILLIAM H. CATLIN, JR.
Managing Director & Sr Partner
617.850.9606
wcatlin@bradvisors.com

ROBERT F. LECLAIR
Managing Director & Partner
617.850.9614
rleclair@bradvisors.com

BONNY L. DOORAKIAN
Managing Director & Partner
617.850.9655
bdoorakian@bradvisors.com

JUSTIN D. HARLOW
Senior Associate
617.850.9613
jharlow@bradvisors.com



745 Boylston Street | Boston, MA 02116 | (T) 617.375.7900 | (F) 617.536.9566 | BRAdvisors.com

© Copyright Boston Realty Advisors. All rights reserved. The information contained here has been obtained through sources deemed reliable but cannot be guaranteed as to its accuracy. Any information of special interest should be obtained through independent verification.