

New Price

cresa



Sale or Lease

3155 Northwoods Place


Peachtree Corners, GA 30071

Overview

Building:	3155 Northwoods Place Peachtree Corners, GA 30071
Premises:	13,727 SF
Property Size:	1.36 Acres
Sale Price:	\$2,200,000
Rental Rate:	\$15/ PSF NNN
Building Class:	Class C Office
Parking:	2.20/1,000 SF
Zoning:	AA030
Parcel No.:	6-271-026

Building Features

- Loading Dock
- Generator
- Excess HVAC
- Lab Space

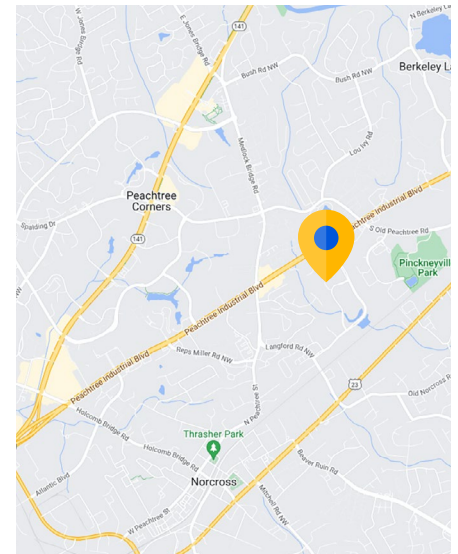

For more information:



Brooks Morris

424.400.9554 mobile
bmorris@cresa.com



Tom Tindall

678.576.4509 mobile
ttindall@cresa.com



Peter York

404.938.5299 mobile
pyork@cresa.com




Brady Tindall

404.797.0262 mobile
btindall@cresa.com

3155 Northwoods Place

Peachtree Corners, GA 3071

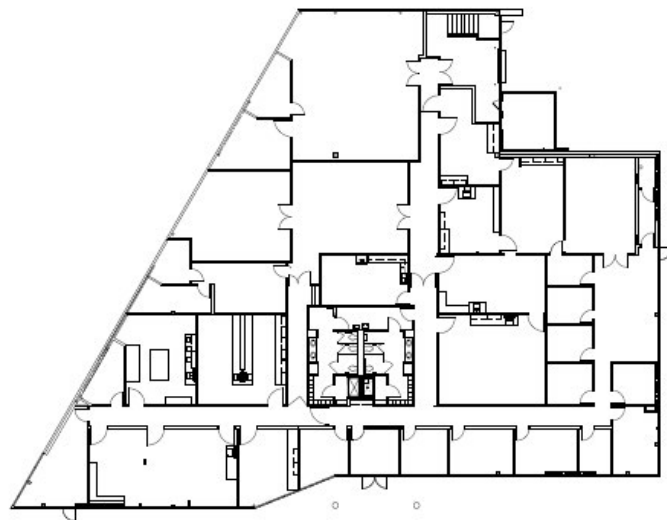

PROJECT

**3155 Northwoods Place
Peachtree Corners, GEORGIA**

DATE: NOVEMBER 18, 2024

JOB NUMBER: _____

SHEET TITLE: AS BUILT

DRAWING SCALE: NTS

SQUARE FOOTAGE: _____


Market Overview

Peachtree Corners, GA 3071


5 Year Population Growth Rate	4.61%
Labor Force	626,626
Total Unemployment	26,716
Unemployment Rate	4.29%
Average Commute Time	35 Min
Cost of Living Index	95.9
Average Home Price	\$532,174
Average Monthly Rental - 1 Bedroom	\$1,334

Traffic Count

Peachtree Industrial Blvd / Corners North Ct SW

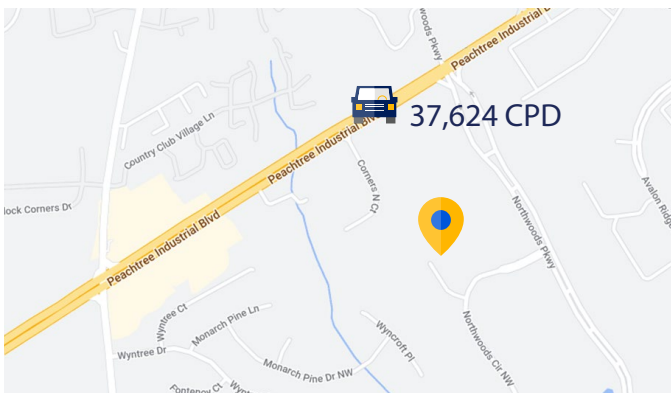

Educational Attainment

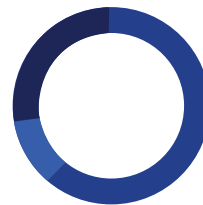

Bachelors/Grad	61.31%
Some College	11.22%
High School	27.46%

Market Age Distribution

Aging Labor Ratio 1.18

Median Age 37.13

