


3921 East Baseline Road

Gilbert . Arizona

- Suite 100 - 3,070 RSF
- Suite 102 - 8,643 RSF
- Suite 103 - 1,213 RSF
- Suite 104 - 650 RSF
- Suite 105/107 - 3,867 RSF
- Suite 108 - 2,000 RSF
- Suite 110 - 2,327 RSF
- Suite 111 - 2,571 RSF
- Suite 112 - 3,409 RSF

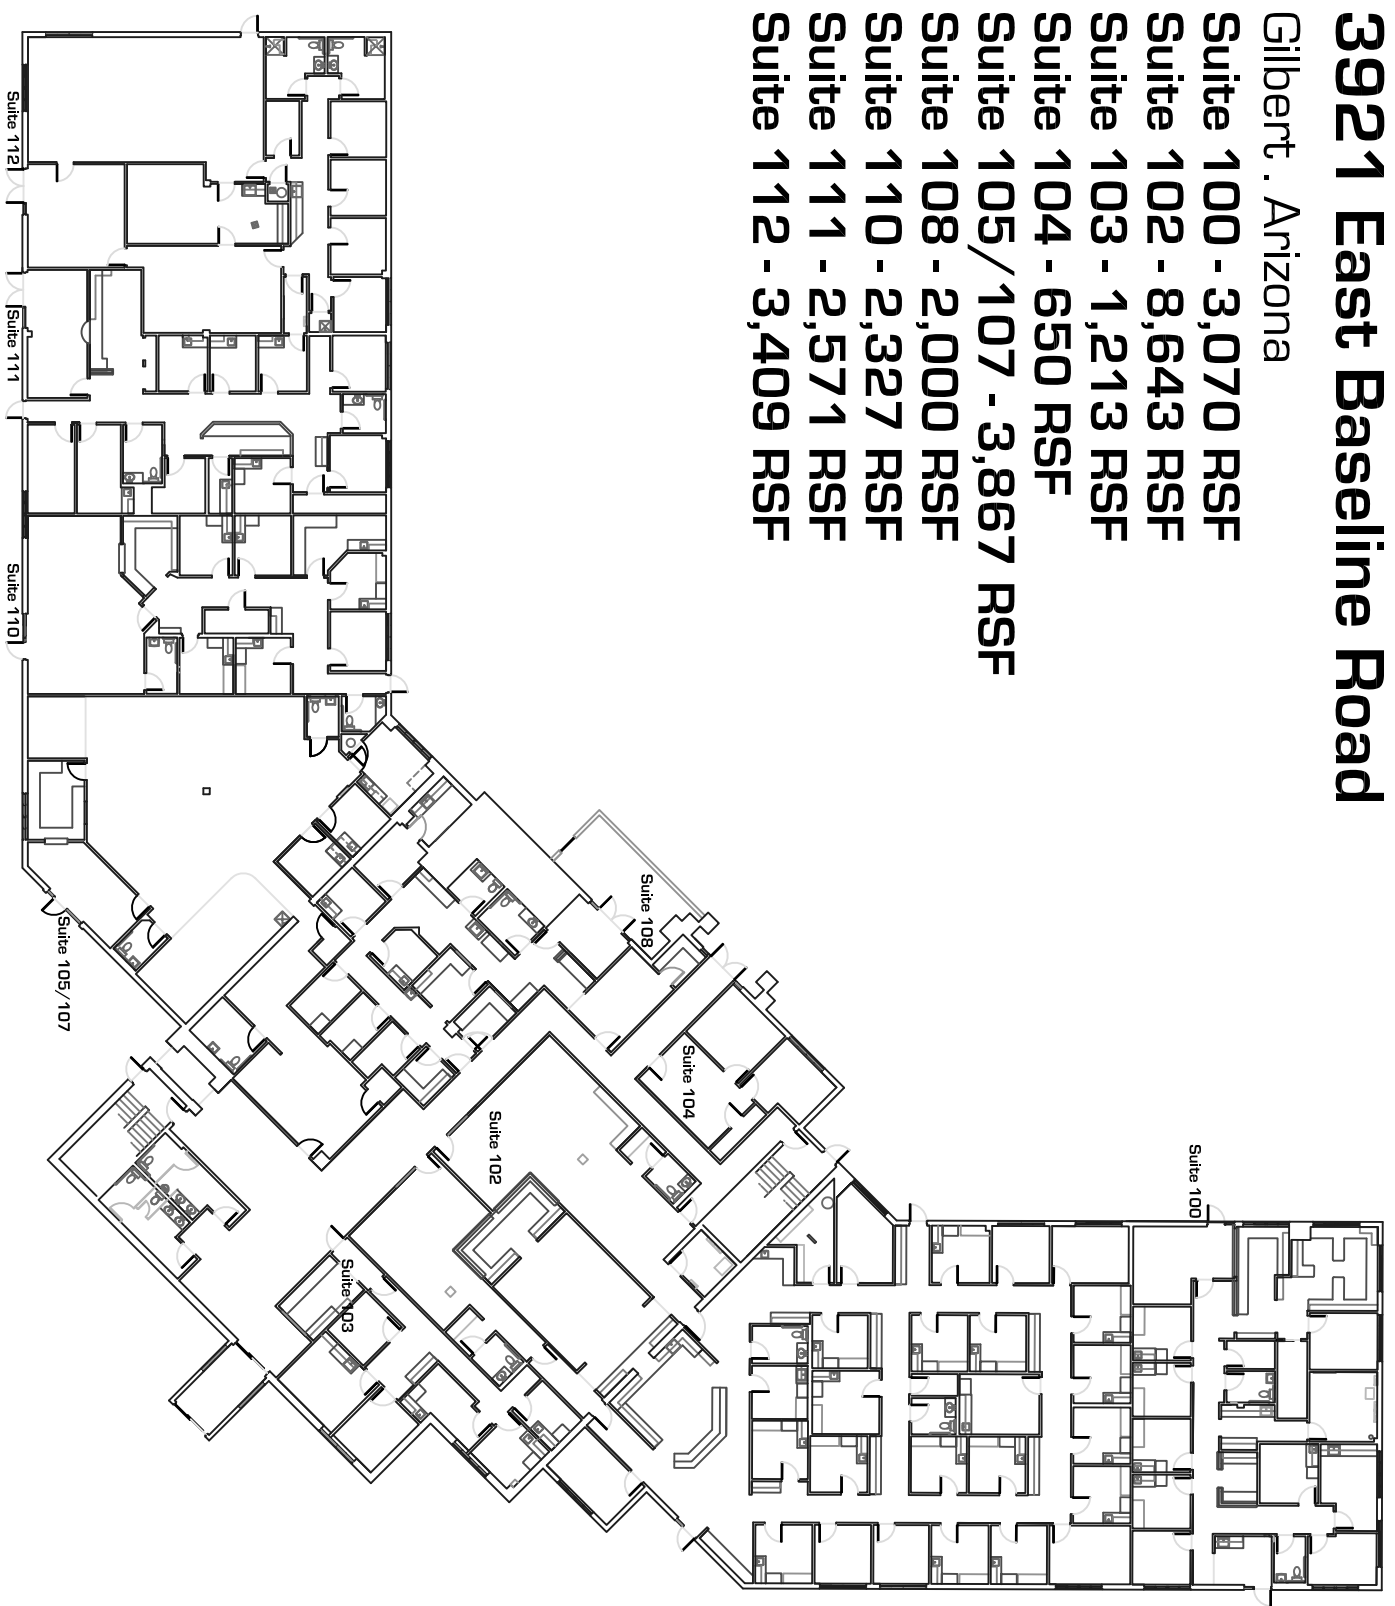

as-built

scale: nts

January, 2020

* All dimensions are approximate at ± 3"

* All information is of general nature

precision **DIMENSIONS**

as-built & design
602. 790. 6412

