


354 MERRIMACK STREET 3RD FLOOR, SUITE 329

AS BUILT PLAN

5,919 SF

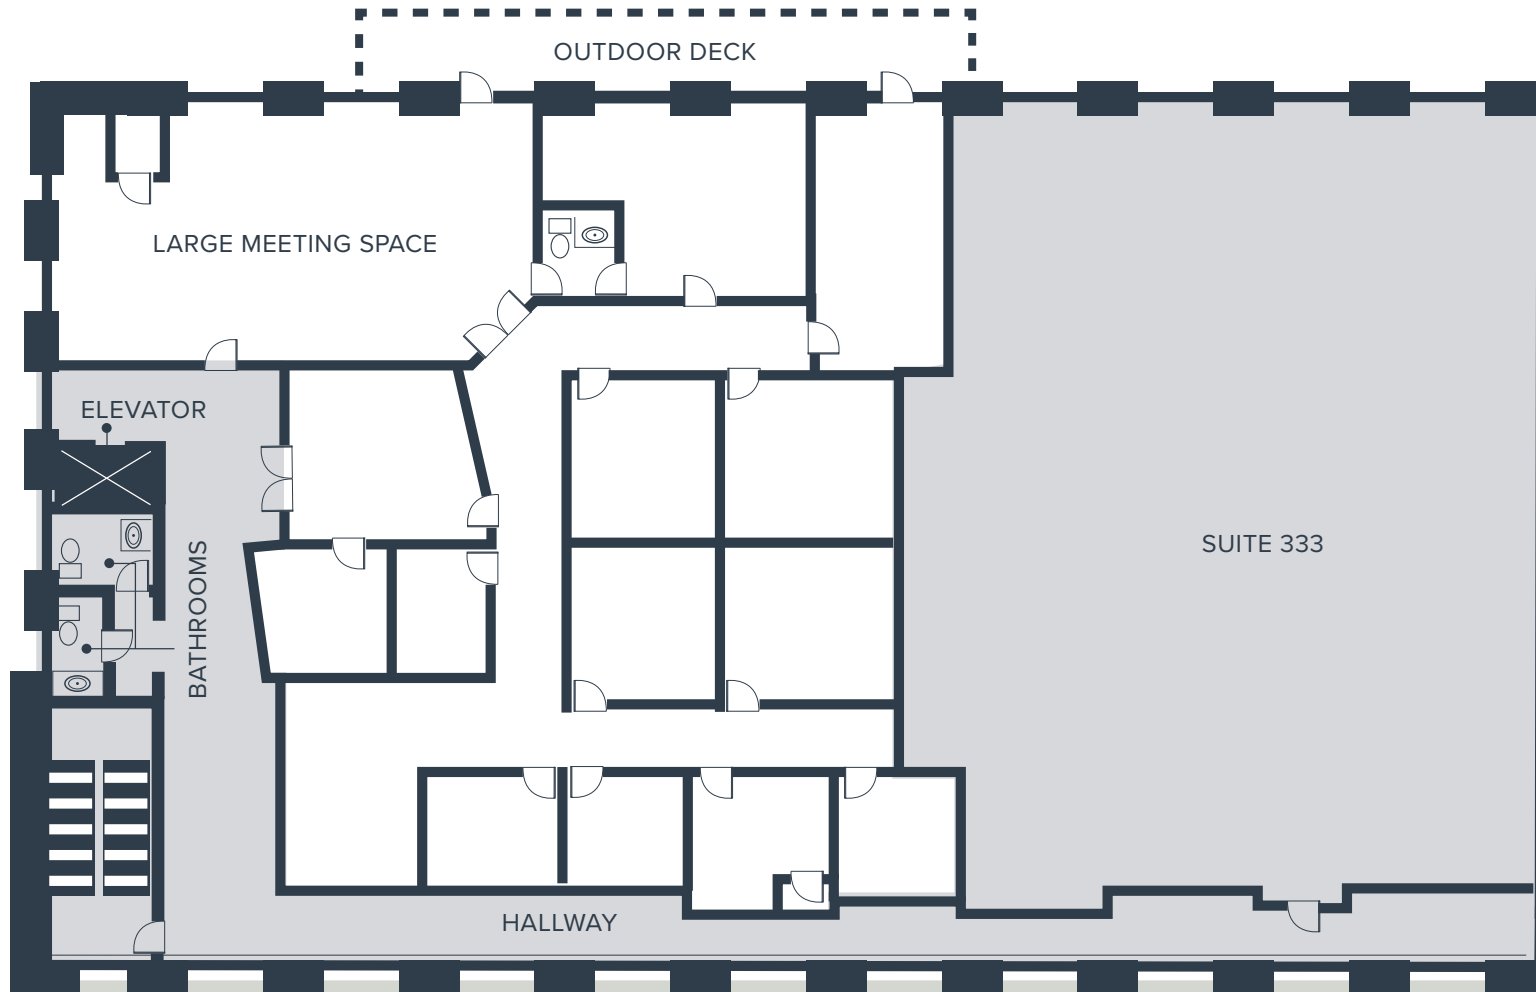

RIVERWALKINNOVATION.COM

978.681.7777

Not to scale. For marketing purposes only.



RIVERWALK
INNOVATION DISTRICT