



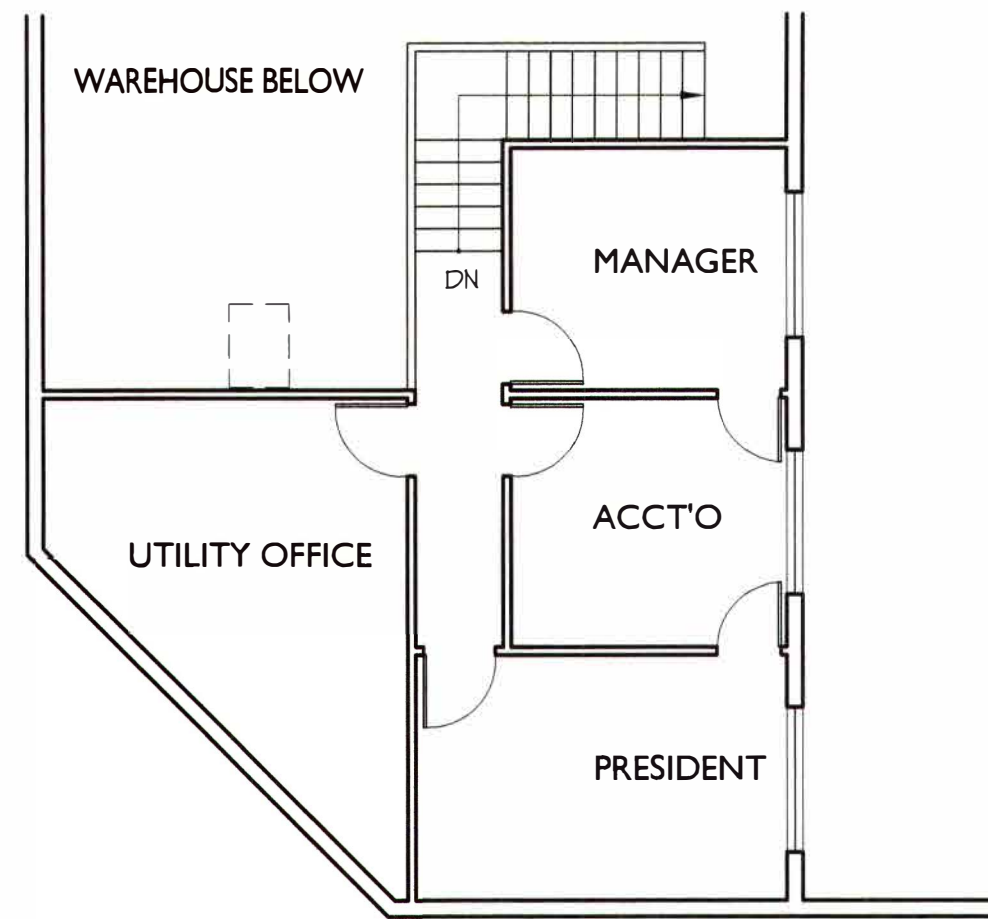


2 MEZZANINE PLAN
SCALE: 1/8"=1'-0"

EXIT WIDTH SCHEDULE					
AREA	SF	OCCUPANT LOAD FACTOR	OCCUPANCY	WIDTH FACTOR	WIDTH REQUIRED
SALES	11,260	30	375	0.2	75
WAREHOUSE	2,190	500	4	0.2	1
OFFICES	612	100	6	0.2	1
TOTALS			385		77
EXISTING EXIT WIDTH				(A)(B)(C)	170"
PROVIDED EXIT WIDTH				(A)(B)(C)(D)	174"

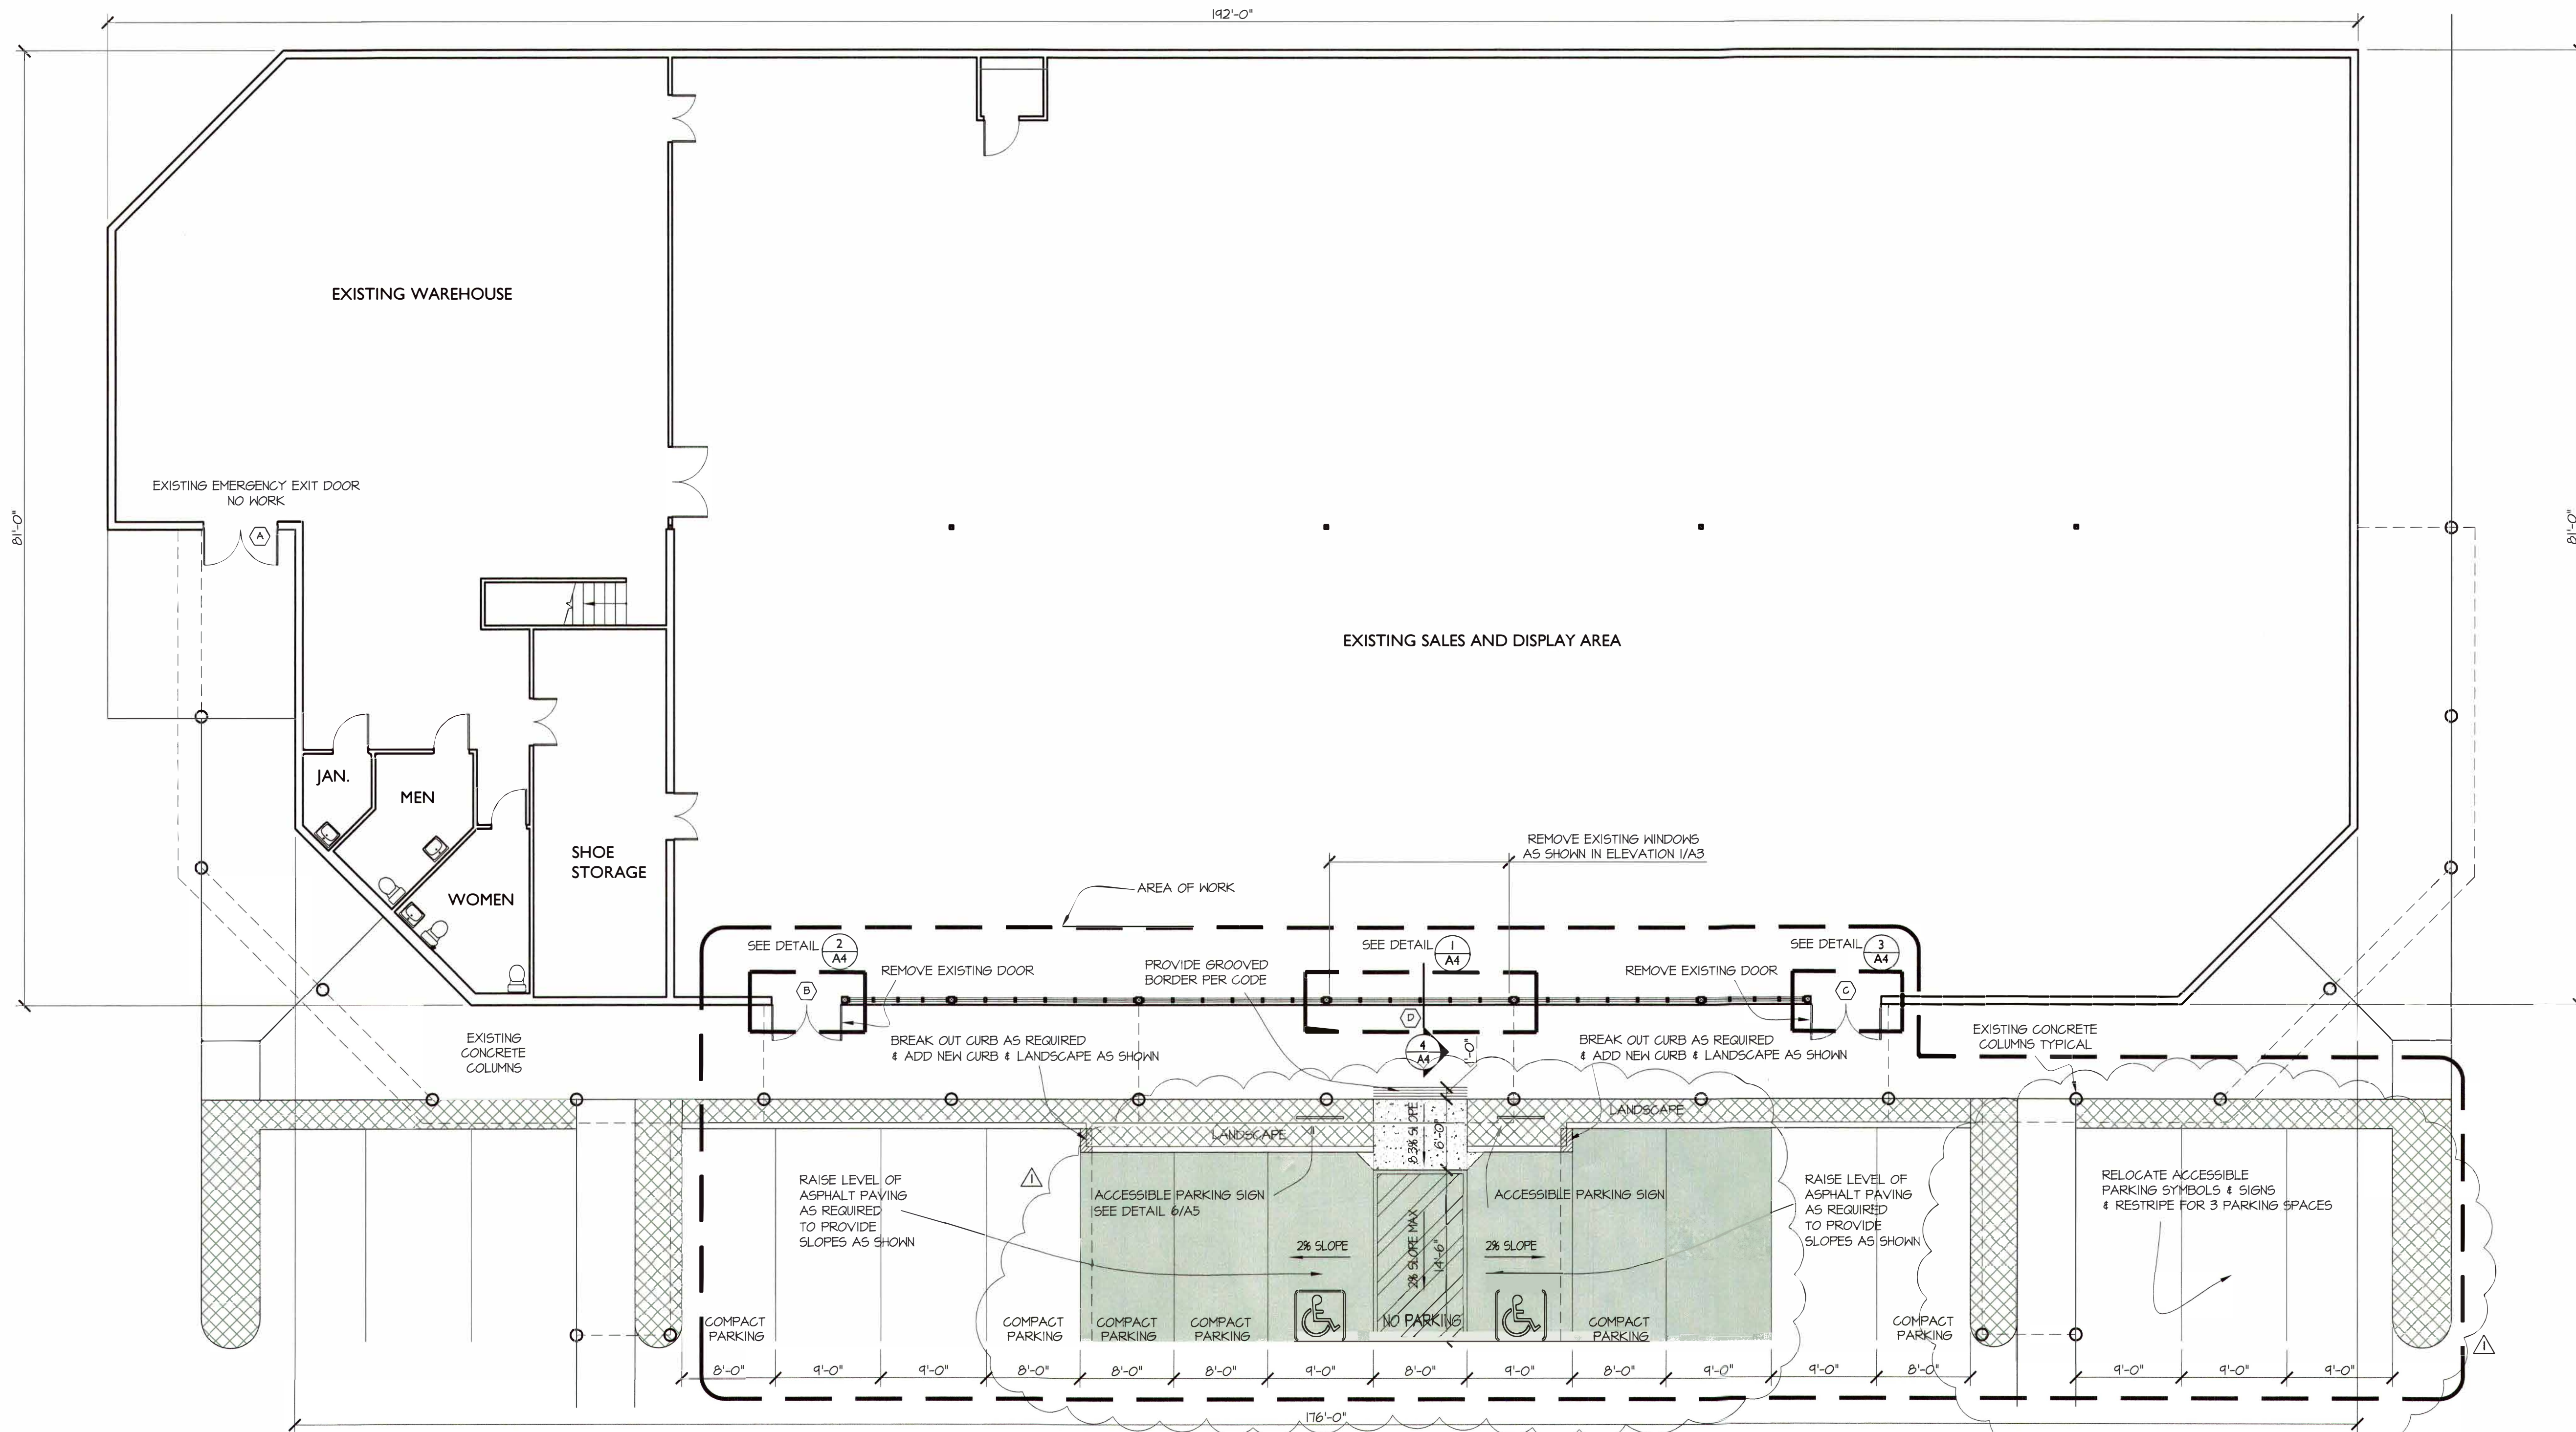

1 FIRST FLOOR PLAN - EXISTING & DEMOLITION
SCALE: 1/8"=1'-0"

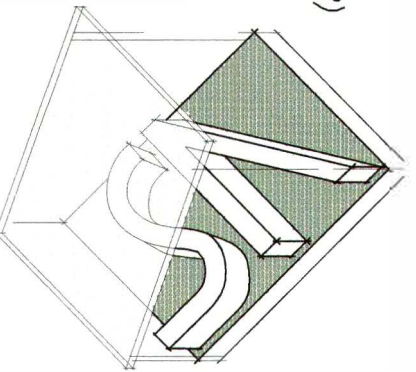

DRAWING DATE:	OCTOBER 12, 2004
CLIENT NAME:	OUTDOOR WORLD
PROJECT NAME:	REMODEL03

REVISIONS		
No.	DESCRIPTION	DATE
1	PLAN CHECK	11/16/04
2	DOOR CHANGE	8/20/07



DISCLAIMER
THE DATA SET FORTH ON THIS SHEET IS THE PROPERTY OF SESSIONS ARCHITECTURE. IT IS AN INSTRUMENT OF SERVICE AND MAY NOT BE ALTERED, REPRODUCED, OR USED WITHOUT THE CONSENT OF THE ARCHITECT. THE PROPER ELECTRONIC TRANSFER OF DATA SHALL BE THE USER'S RESPONSIBILITY WITHOUT LIABILITY TO THE ARCHITECT. UNAUTHORIZED USE IS PROHIBITED.