




kinslow, keith & todd, inc.
 architecture | interiors
 tel 918.744.4270
 fax 918.744.7849
 2021 south lewis suite 150
 tulsa, oklahoma 74104
 www.ktarchitects.com
 info@ktarchitects.com

**2ND
 FLOOR**

**RICHMOND
 PLAZA**

**CASE
 & ASSOCIATES**

SCALE	N.T.S.
FILE NAME	RPO2AS
MANAGER	ELS
DRAWN BY	ELS
08.14.12	

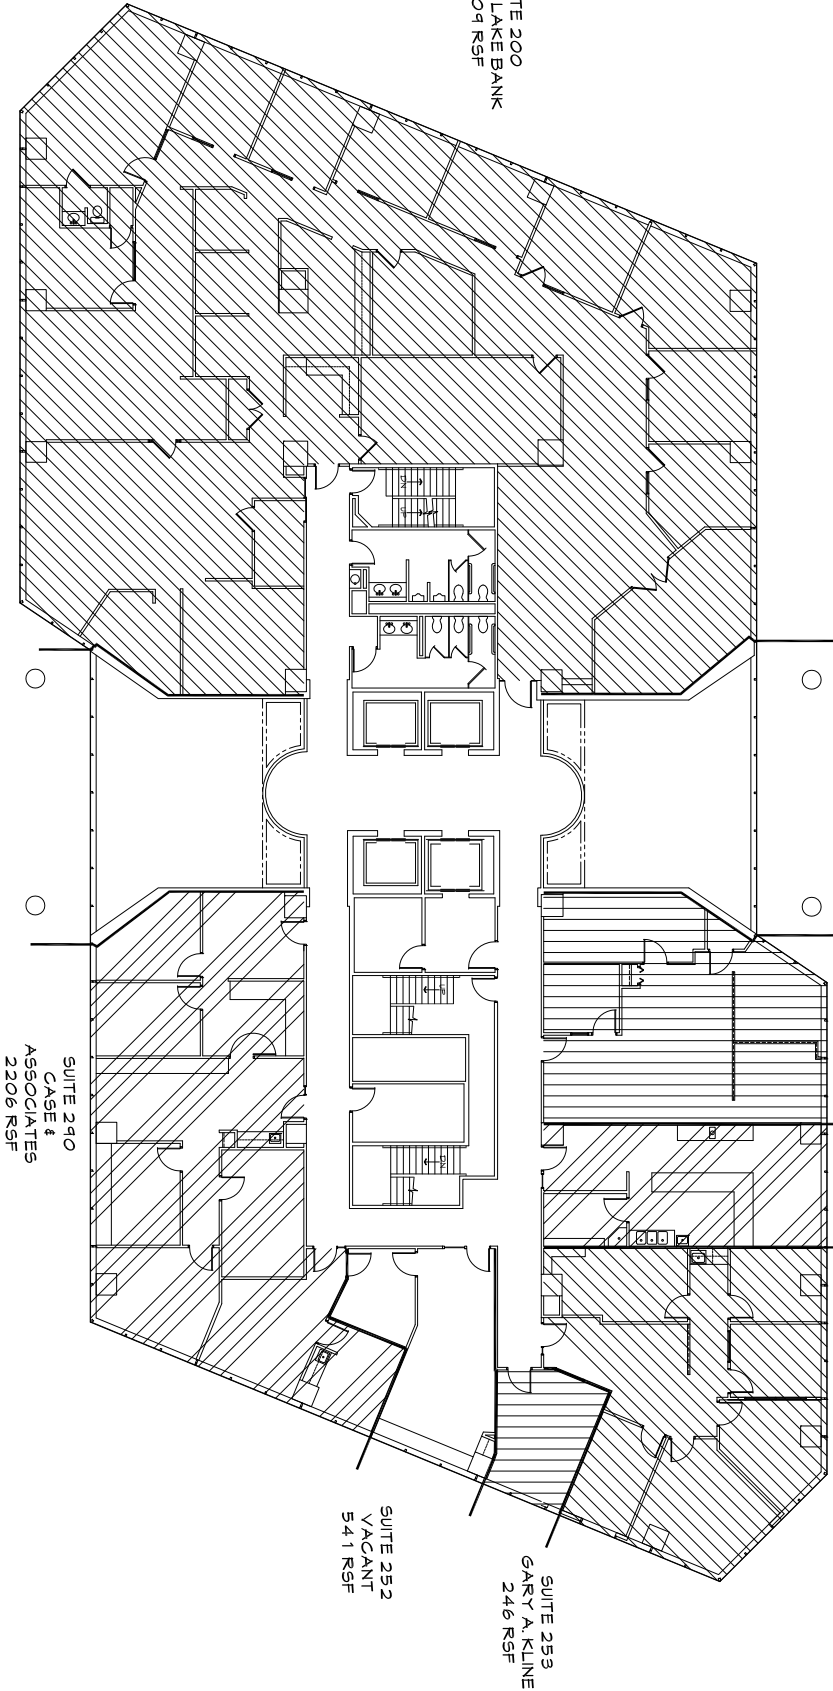

A FLOOR PLAN

SCALE: N.T.S.



NORTH

AS-BUILT
 PLAN
AS-2