

# 36700 Woodward Avenue

## Second Floor

### BIRMINGHAM, MICHIGAN



2075 West Big Beaver, Suite 100

Troy, Michigan 48084

Telephone 248.341.3999

Facsimile 248.646.3744

[www.dietzpropertygroup.com](http://www.dietzpropertygroup.com)


# FLOOR PLAN

**Oakland Dermatology Associates P.C.**

Suite 203  
2,400 RSF

**Mariner Wealth Advisors**

Suite 201  
2,406 RSF  
2,187 USF

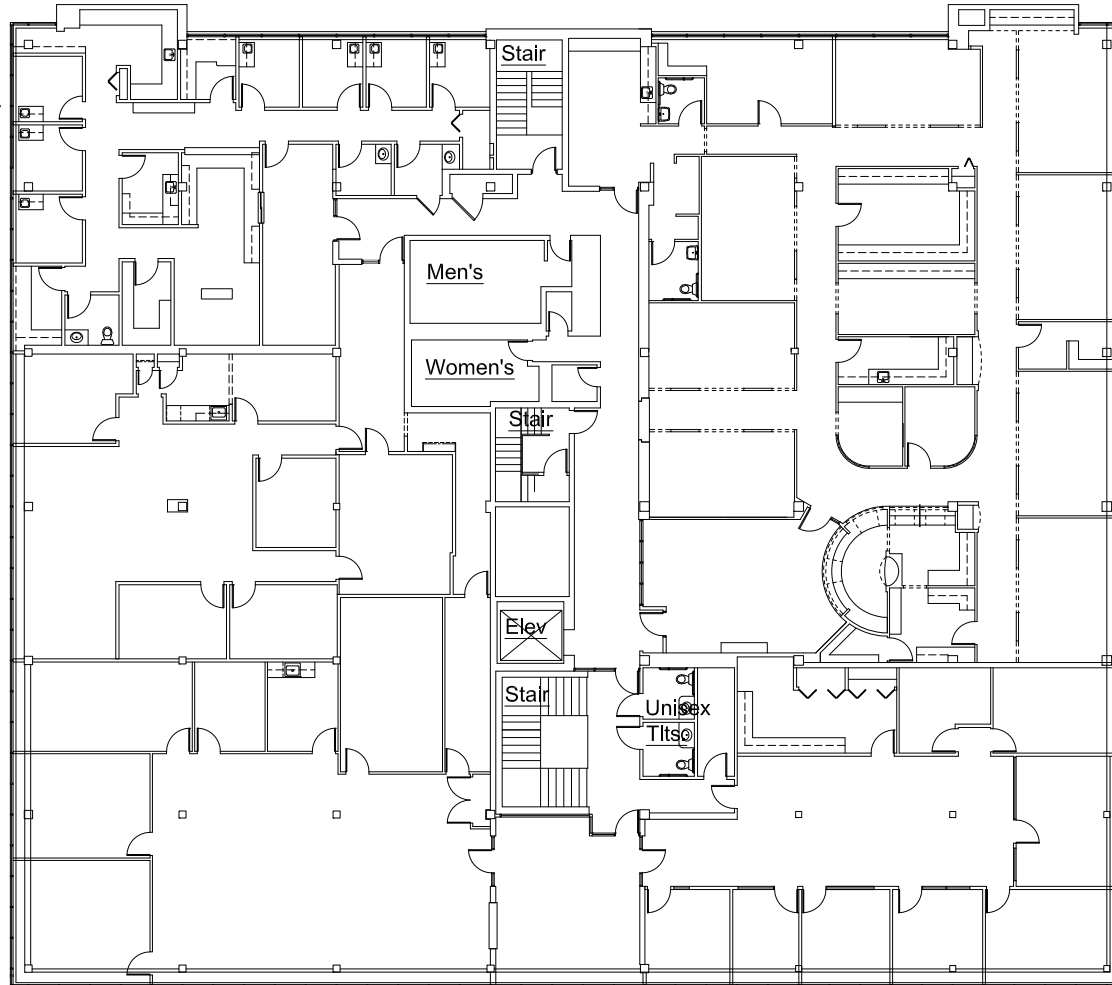

**Dr. Nafso**

Suite 200  
5,783 RSF  
5,257 USF

**Kotz Sangster Wysocki, P.C.**

Suite 202  
6,130 RSF  
5,572 USF



AS-BUILT FLOOR PLAN

0 8' 16' 32'



GRAPHIC SCALE

FOR LEASING INFORMATION,  
CONTACT: BRIAN SALLIOTTE  
(248) 341-3320

22-590

11/17/22