



Room Schedule			
Label	Room Name	Area	Type
FLOOR AREA			
Lower Level	1. HEATED/LOWER	1,445.02	Commercial Heated
Lower Level	2. PORCH	101.61	External / Covered
Main Level	1. HEATED/MAIN	3,027.29	Commercial Heated
Main Level	2. SUN DECK	109.32	External / Covered
		4,683.24 ft²	

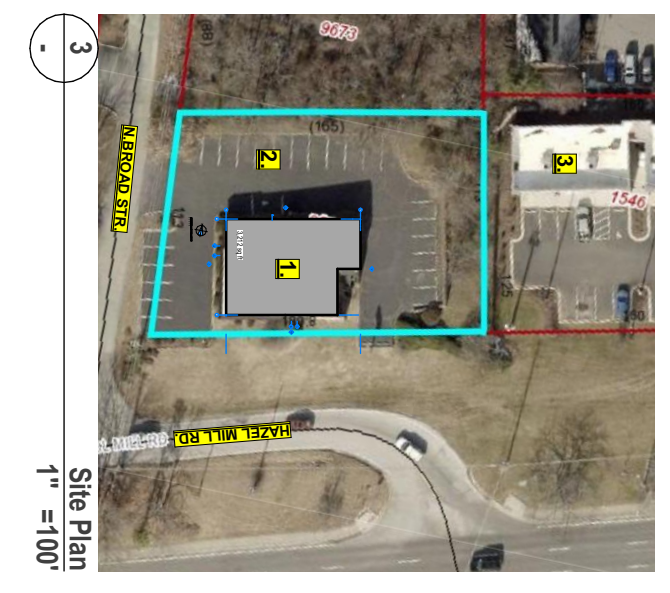

SITE PLAN
 1. Building
 2. Parking
 3. Neighbouring Build.

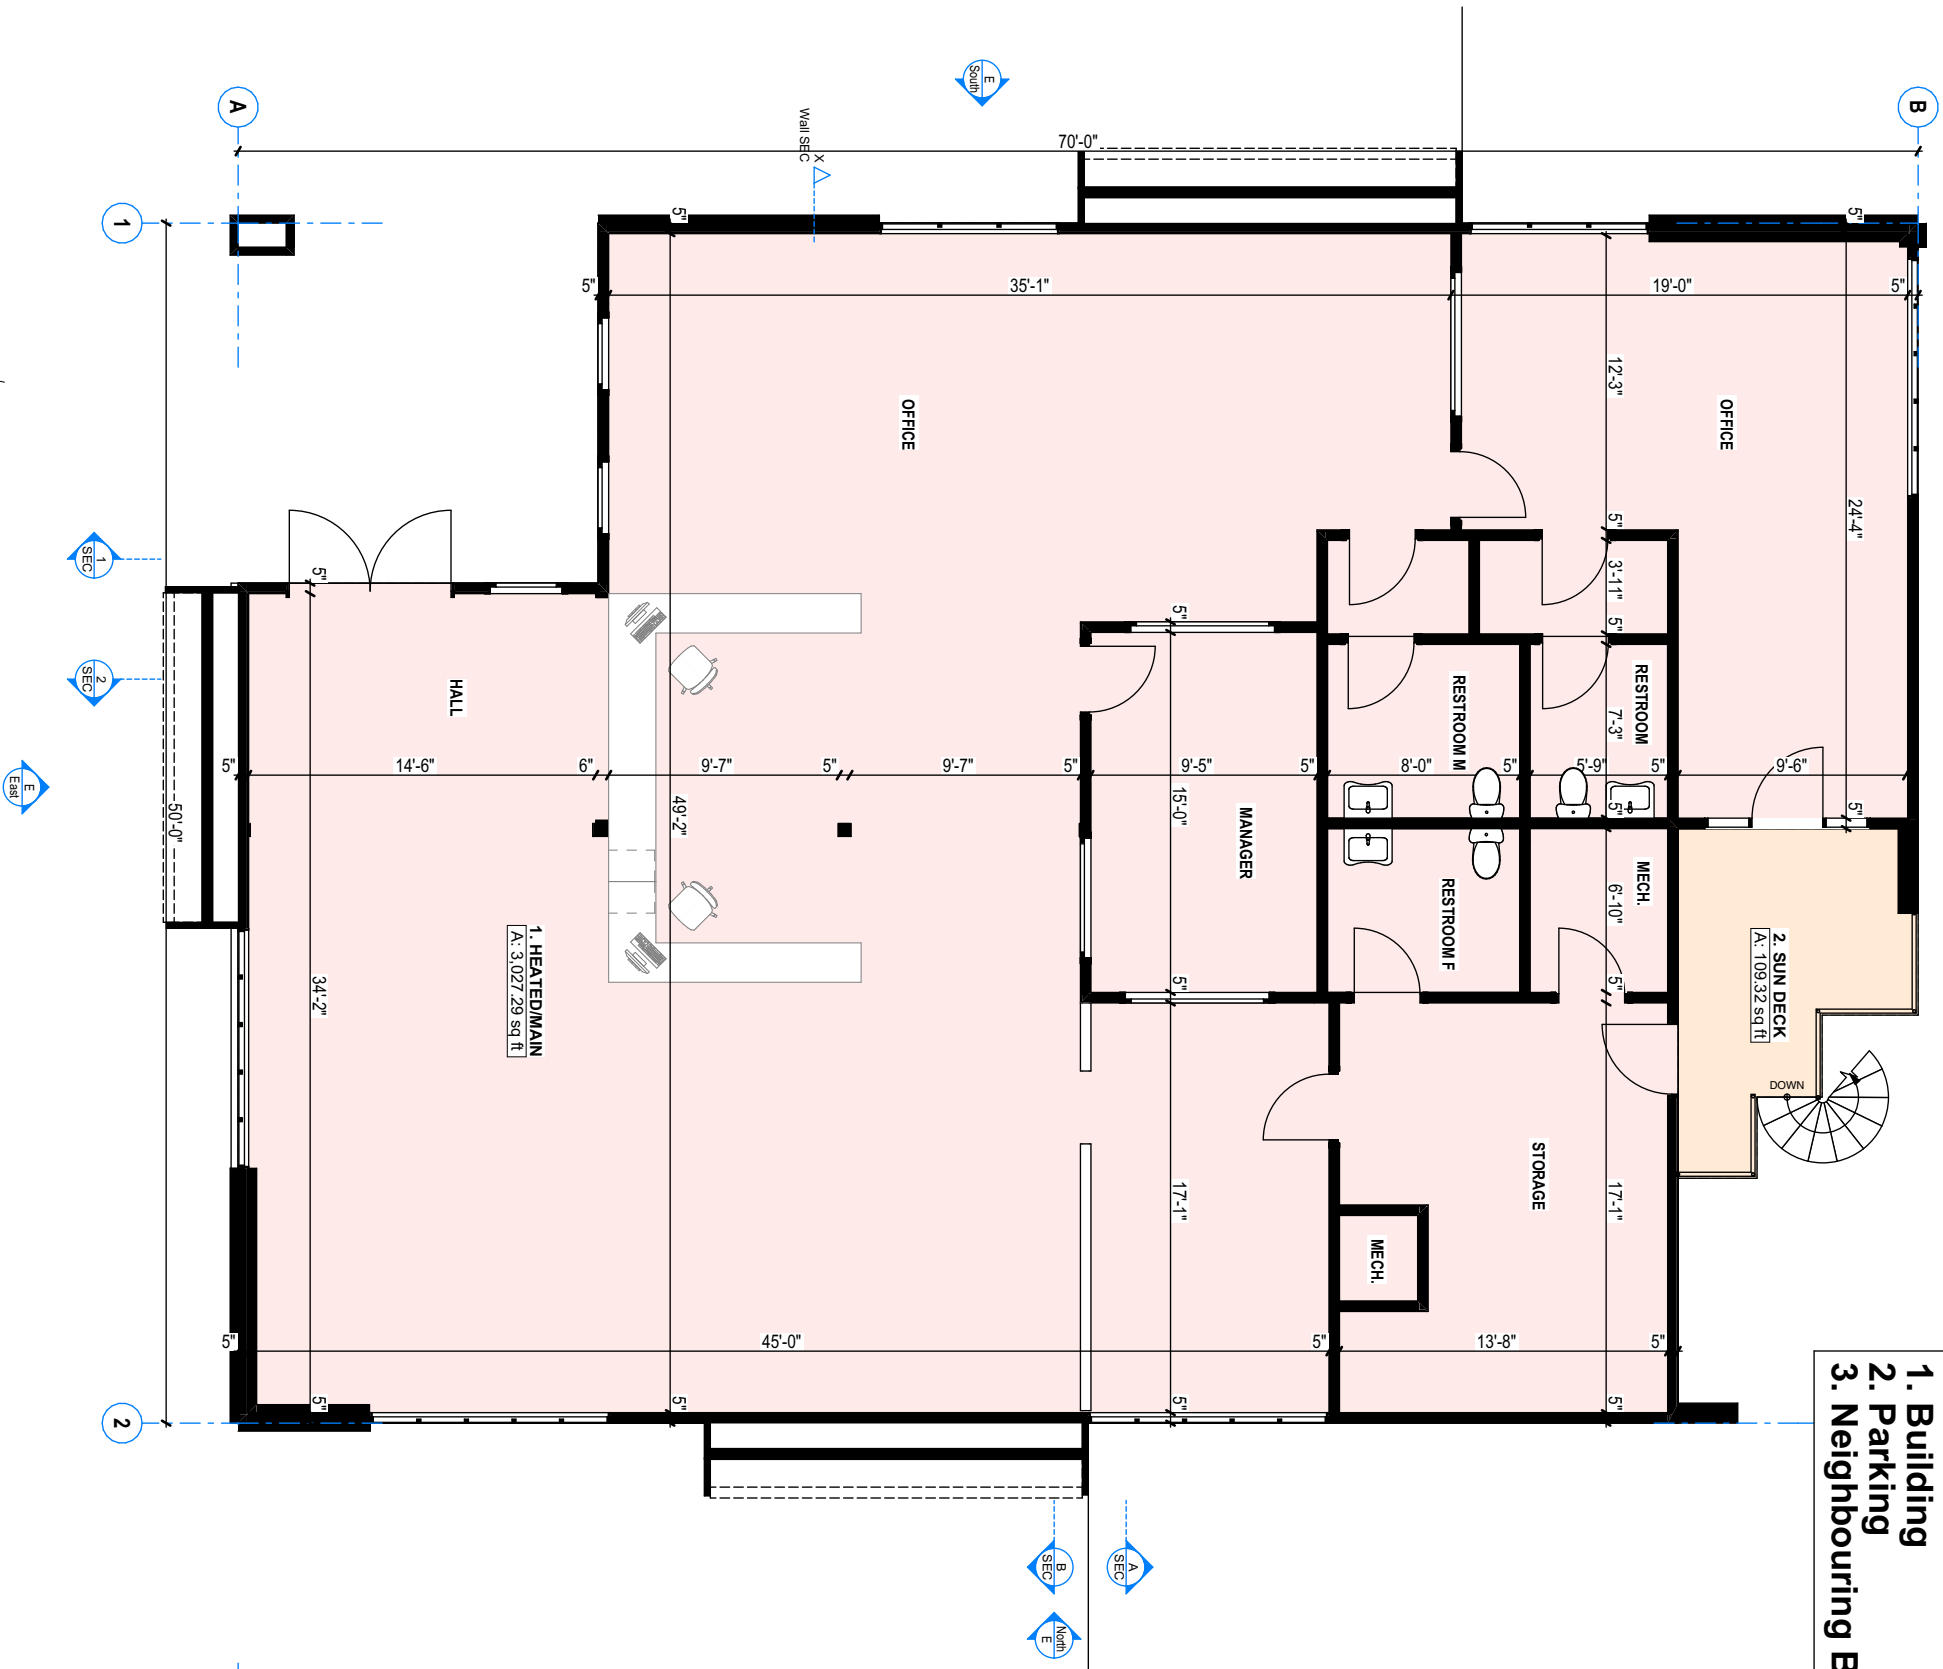

Sheet Index		
AS Built		
.1	Main Floor Plan	
.2	Lower Floor Plan	
.3	Generic Perspectives	

Contract Name	MR 1884
Contract No.	18024
Contract Date	11/13/2018
Contract Value	\$1,000,000.00
Contract Address	1 HANSEL AVE, ASHEVILLE, NC 28806
Contract Owner	MEASURE RITE LLC
Contract Manager	ANDREW ZALYS
Contract Designer	ANDREW ZALYS
Contract Checker	ANDREW ZALYS
Contract Approver	ANDREW ZALYS
Contract ID	1

Measure Rite LLC
 103 Poplar Spring Trail, Hendersonville
 #Cortland County, NC 28759

1 HANSEL AVE, ASHEVILLE, NC 28806

Company Name: **Measure Rite LLC**
 Company Title: **103 Poplar Spring Trail, Hendersonville #Cortland County, NC 28759**

Project Name: **Main Level, Room Schedule, Site Plan, Sheet Index**

Company Name: **Measure Rite LLC**
 Company Title: **103 Poplar Spring Trail, Hendersonville #Cortland County, NC 28759**

1

3

Site Plan
 1" = 100'





GENERAL NOTES: A. ALL PERMITS WITHOUT MR, LLC PERMISSION. B. HEATED DIMENSIONS WERE NOT USED 2. ALL DIMENSIONS ARE TO FACE UNLESS OTHERWISE NOTED. 3. SIZE OF HEATED AND NOT HEATED AREAS AND OTHER DIMENSIONS GIVEN ARE AS SHOWN ON EXTERNAL WALLS. 4. EXISTING DIMENSIONS AND/OR FINISHES ARE AS SHOWN ON EXISTING DRAWINGS AND 2D/3D POINT CLOUD DATA. 5. ALL DIMENSIONS ARE TO FACE UNLESS OTHERWISE NOTED. 6. ALL DIMENSIONS ARE TO FACE UNLESS OTHERWISE NOTED. 7. ALL DIMENSIONS ARE TO FACE UNLESS OTHERWISE NOTED. 8. ALL DIMENSIONS ARE TO FACE UNLESS OTHERWISE NOTED. 9. ALL DIMENSIONS ARE TO FACE UNLESS OTHERWISE NOTED. 10. ALL DIMENSIONS ARE TO FACE UNLESS OTHERWISE NOTED.

Legend:
 HEATED RESIDENT FINISHED
 HEATED COMMERC FINISHED
 NOT HEATED/NOT FINISHED
 OPEN DECK
 COVERED PORCH

1/8" = 1'-0"

Room Schedule			
Label	Room Name	Area	Type
FLOOR AREA			
Lower Level	1. HEATED/LOWER	1,445.02	Commercial Heated
Lower Level	2. PORCH	101.61	External / Covered
Main Level	1. HEATED/MAIN	3,027.29	Commercial Heated
Main Level	2. SUN DECK	109.32	External / Covered
		4,683.24 ft²	

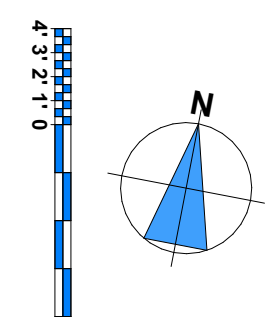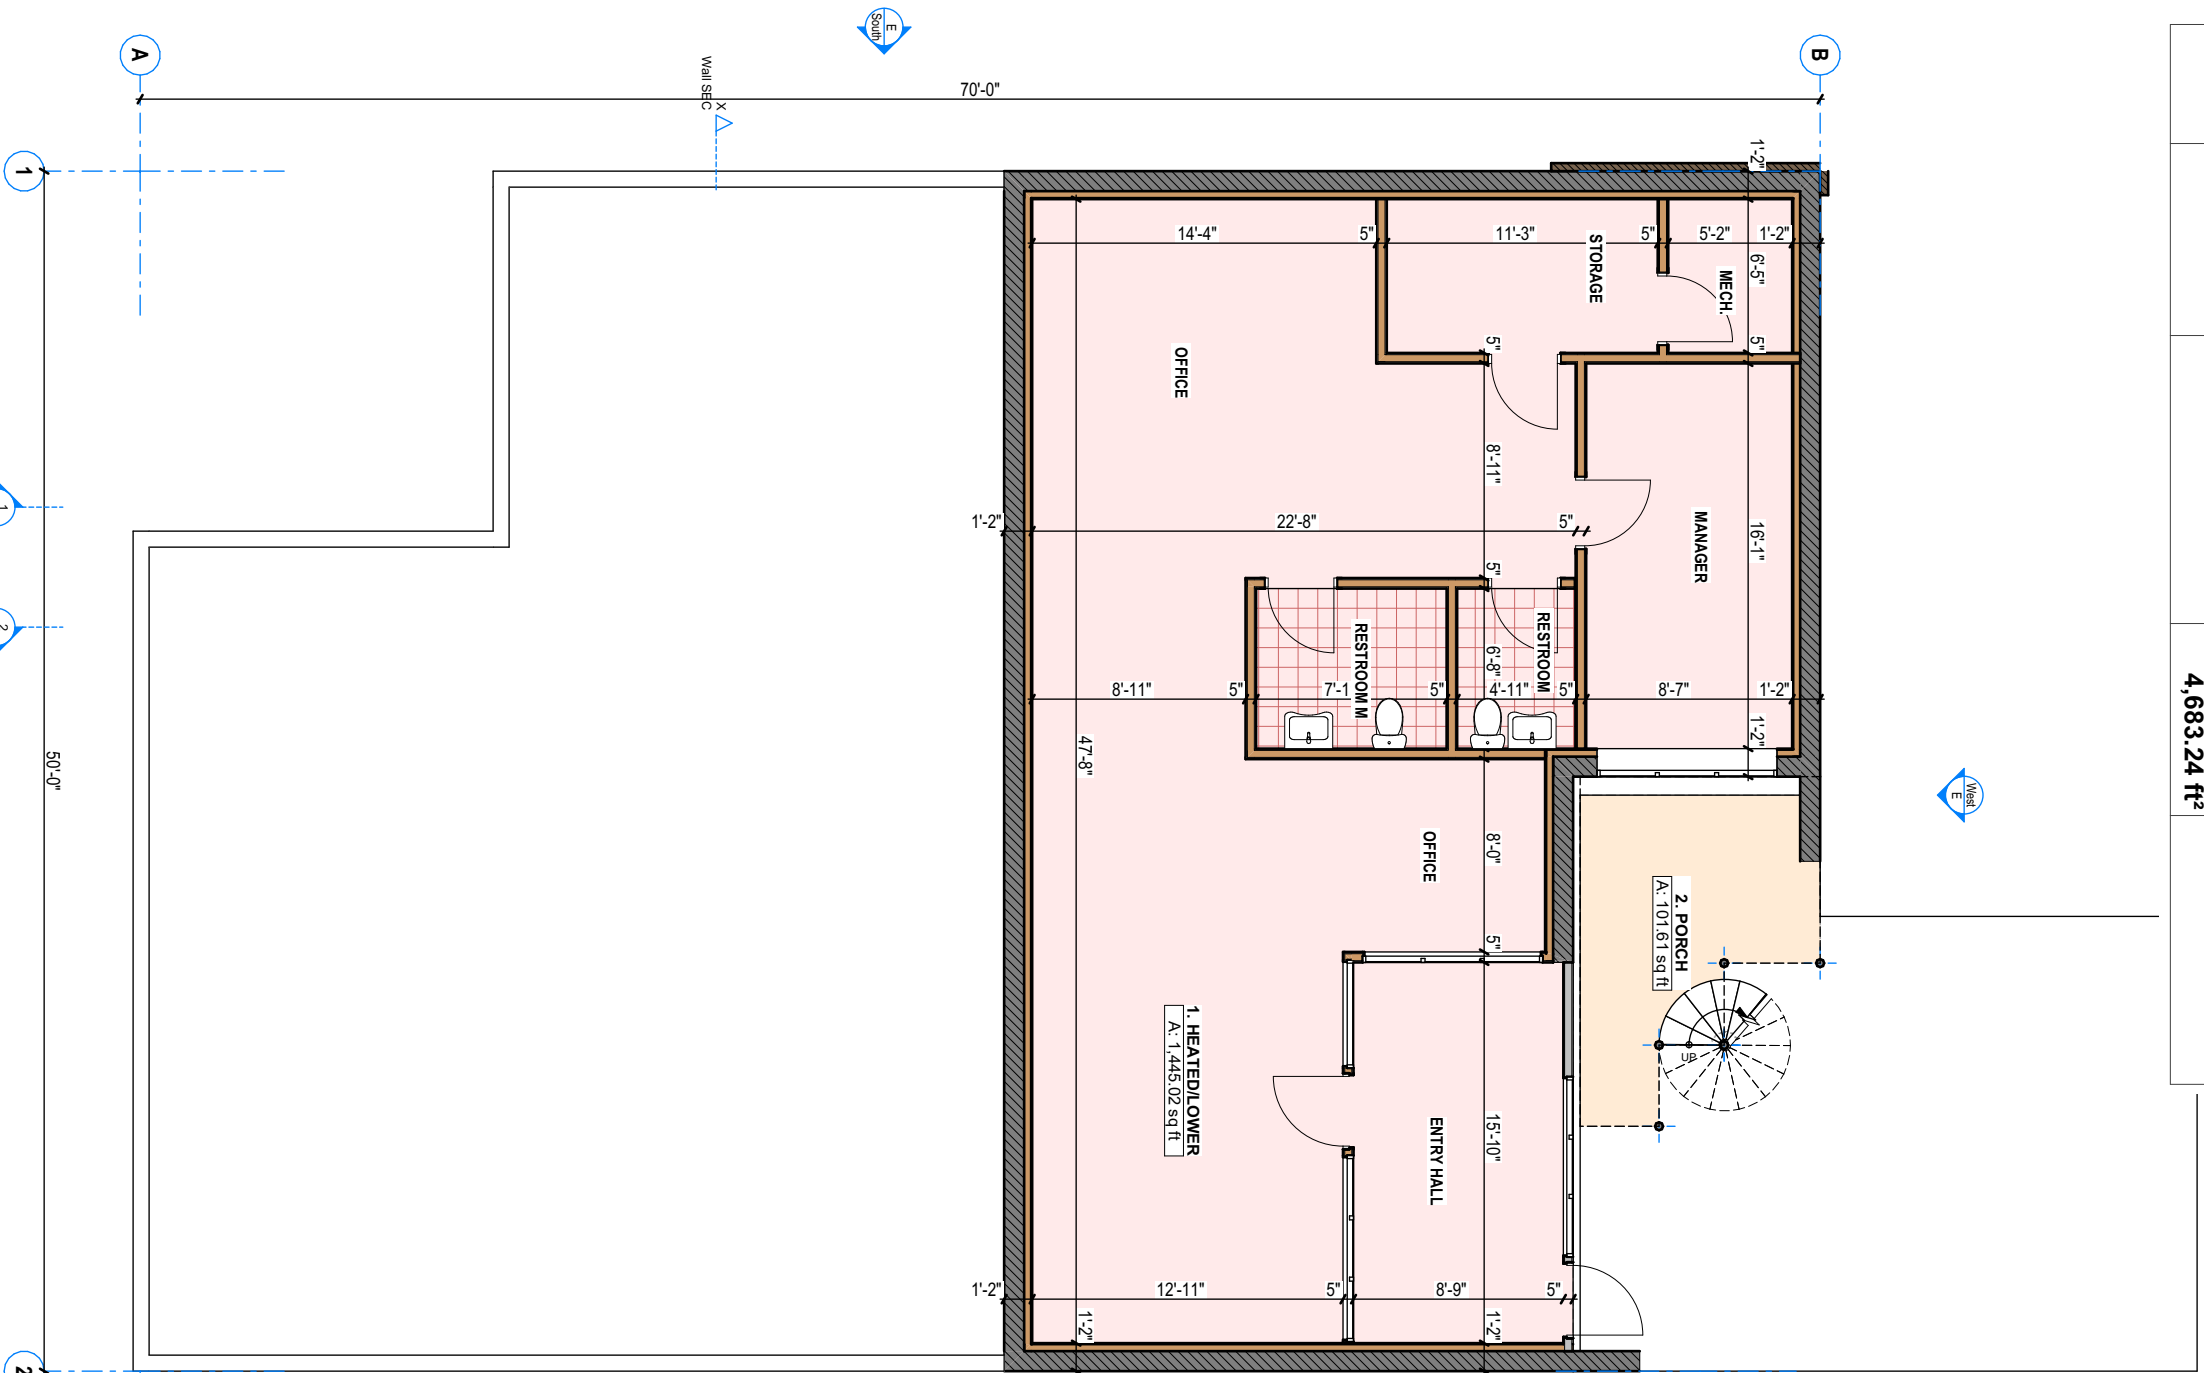

Sheet Index	
AS Built	
.1	Main Floor Plan
.2	Lower Floor Plan
.3	Generic Perspectives



GENERAL NOTES:
 1. ALL DIMENSIONS ARE TO FACE UNLESS NOTED OTHERWISE.
 2. ALL DIMENSIONS ARE TO FACE UNLESS NOTED OTHERWISE.
 3. SIZE OF HEATED AND NOT HEATED AREAS AND OTHER DIMENSIONS GIVEN ARE TO FACE UNLESS NOTED OTHERWISE.
 4. ALL DIMENSIONS ARE TO FACE UNLESS NOTED OTHERWISE.
 5. ALL DIMENSIONS ARE TO FACE UNLESS NOTED OTHERWISE.
 6. ALL DIMENSIONS ARE TO FACE UNLESS NOTED OTHERWISE.
 7. ALL DIMENSIONS ARE TO FACE UNLESS NOTED OTHERWISE.
 8. ALL DIMENSIONS ARE TO FACE UNLESS NOTED OTHERWISE.
 9. ALL DIMENSIONS ARE TO FACE UNLESS NOTED OTHERWISE.
 10. ALL DIMENSIONS ARE TO FACE UNLESS NOTED OTHERWISE.

Sheet	e-mail address	phone number

Revision	By	Date	Description

LEGEND MAP:
 HEATED RESIDENT FINISHED
 HEATED COMMERCIAL FINISHED
 NOT HEATED / NOT FINISHED
 OPEN DECK
 COVERED PORCH


MEASURE RITE LLC
 103 Poplar Spring Trail, Hendersonville, NC 28759
 1 Hansel Ave, Asheville, NC 28806

MEASURE RITE LLC
 103 Poplar Spring Trail, Hendersonville, NC 28759
 1 Hansel Ave, Asheville, NC 28806

MEASURE RITE LLC
 103 Poplar Spring Trail, Hendersonville, NC 28759
 1 Hansel Ave, Asheville, NC 28806

MEASURE RITE LLC
 103 Poplar Spring Trail, Hendersonville, NC 28759
 1 Hansel Ave, Asheville, NC 28806

Lower Level
 1/8" = 1'-0"

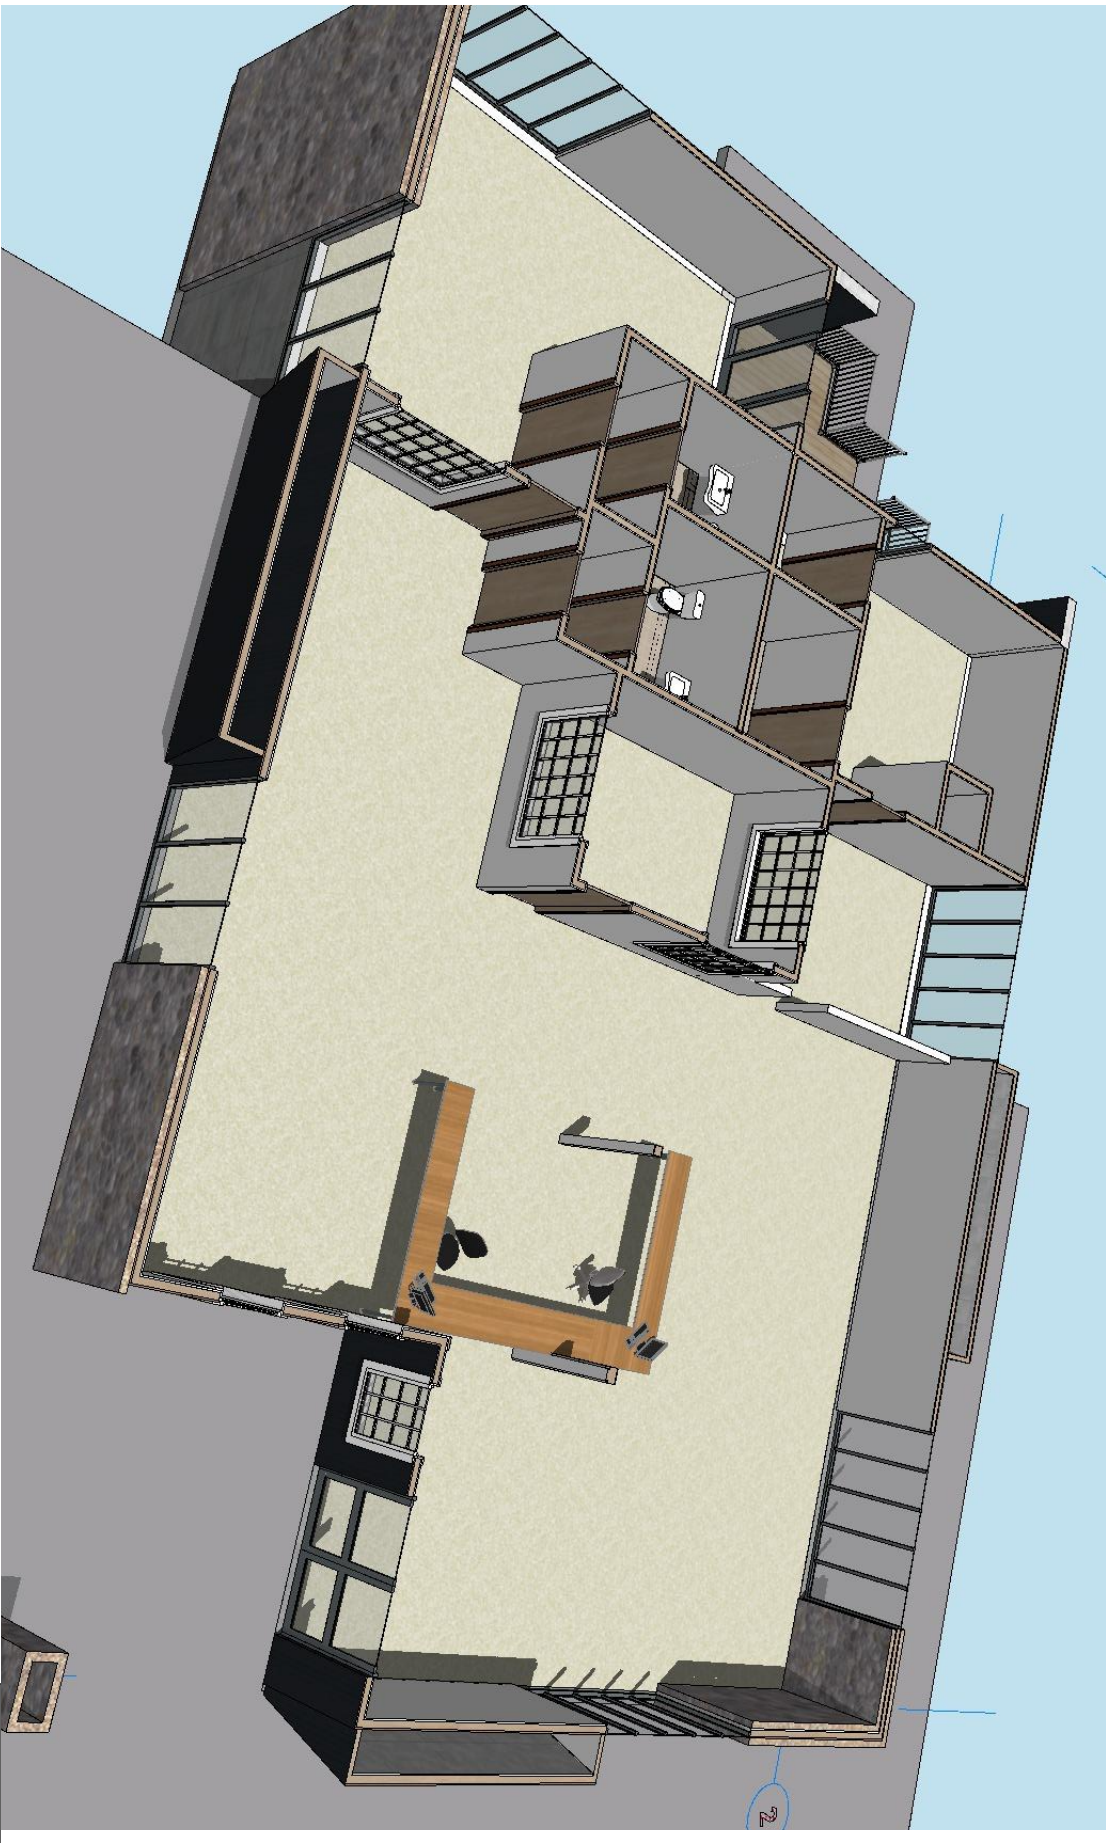

1

Generic Perspective / MAIN
1" = 20'

PROJECT LOCATION MAP

GENERAL NOTES: A ALLUREMENTS WITHOUT MR.LLC PERMISSION. THE DESIGN DIMENSIONS WERE NOT USED 2. PLEASE NOTE: THE SOURCE CODES ARE NOT USED 3. SIZE OF HEATED AND NOT HEATED AREAS AND OTHER COMMISSION GIVEN. NESI (FOR EXTERNAL WALLS, DEPT. CONCOMMANS) 4. ALL DIMENSIONS AND VOLUME BRACKETS ARE TO BE PAID. SECTIONAL DRAWINGS ALSO SHOWS. PLEASE CONTACT ARIED ZALYS FOR MORE INFORMATION. EMAIL: ARIED.ZALYS@MR.LLC.COM

Sheet:
 e-mail address
 phone number

- HEATED RESIDENT FINISHED
- HEATED COMMERCIAL FINISHED
- NOT HEATED/NOT FINISHED
- OPEN DECK
- COVERED PORCH

Revision History

Rev#	Chg#	Change Name	Date




Company: **Measure Rite LLC**
103 Poplar Spring Trail, Hendersonville
#Contact County, NC 28759

Site Address: **1 Hansel Ave, Asheville, NC 28806**

Drawing Name: **Generic Perspective / MAIN, Camera-White, Generic Perspective / LOWER**

DRAWING STATUS

Contract Name	MR 1884
Contract No.	MR 1884
Contract Date	04/20/24
Drawing Scale	As Shown
Project Code	MR 1884
Project Name	1 Hansel Ave, Asheville, NC
Project ID	MR 1884
Project ID	MR 1884
Revision	3

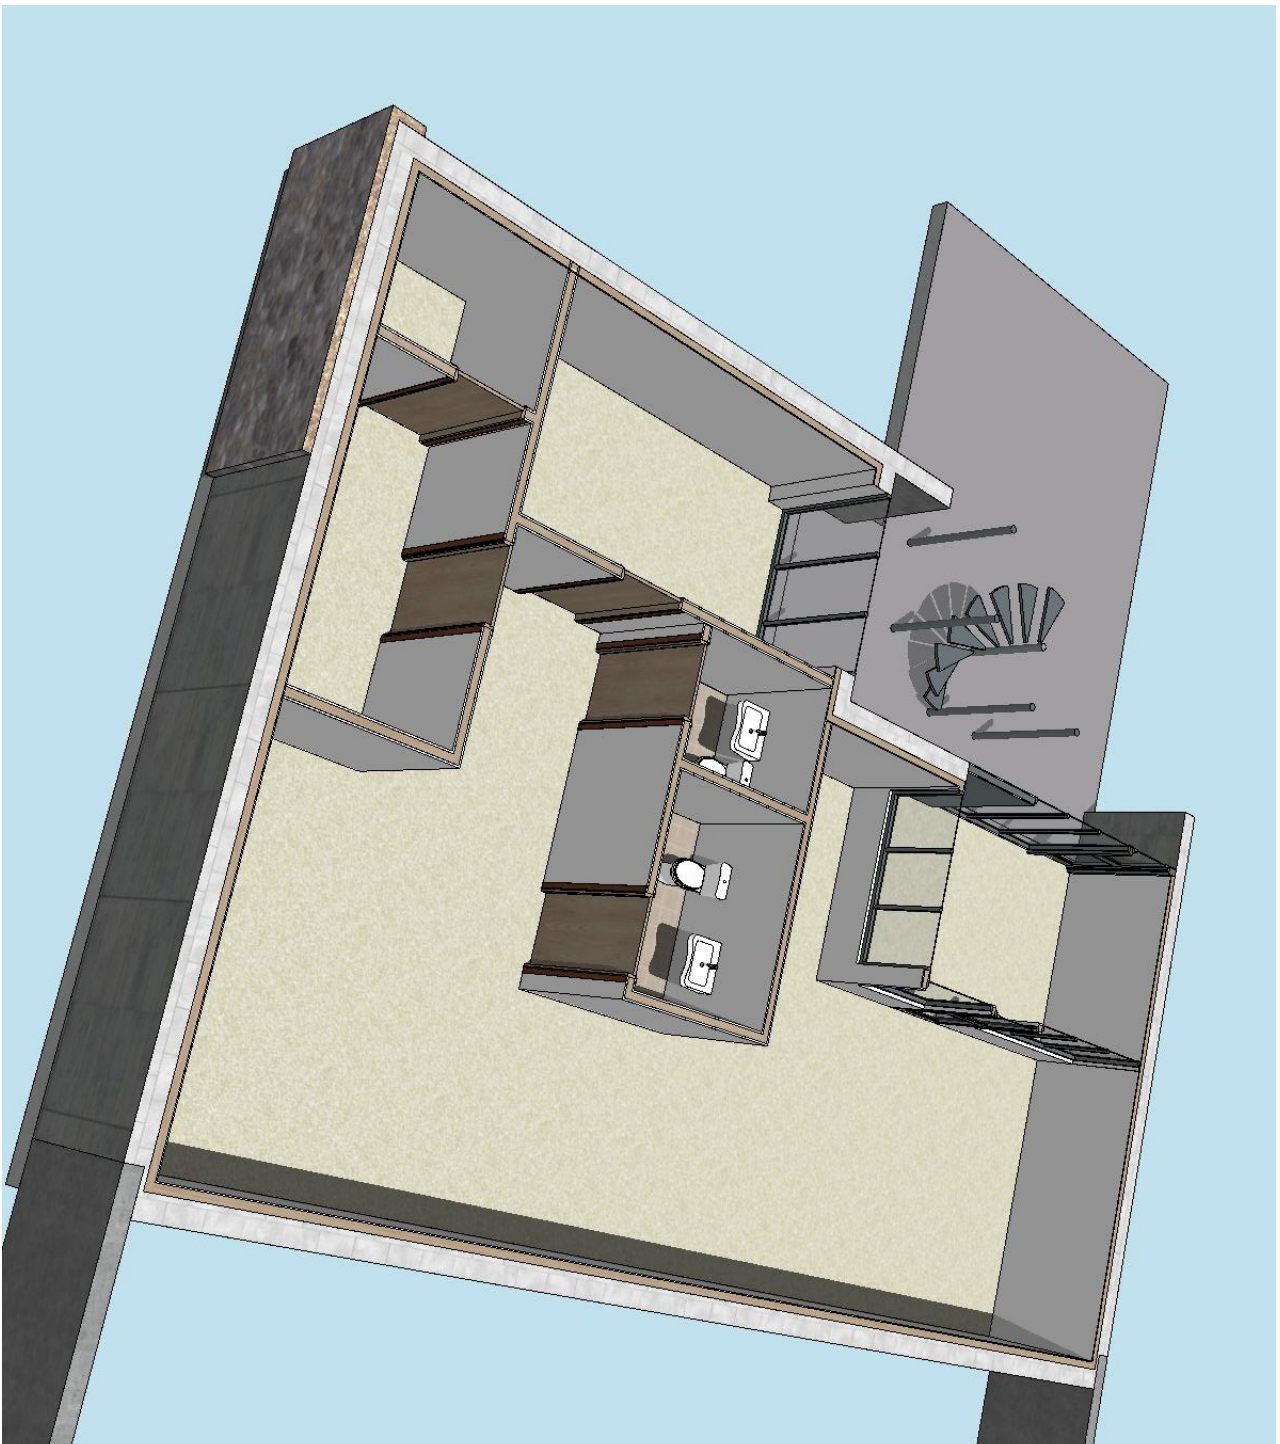

3

Generic Perspective / LOWER
1" = 20'