


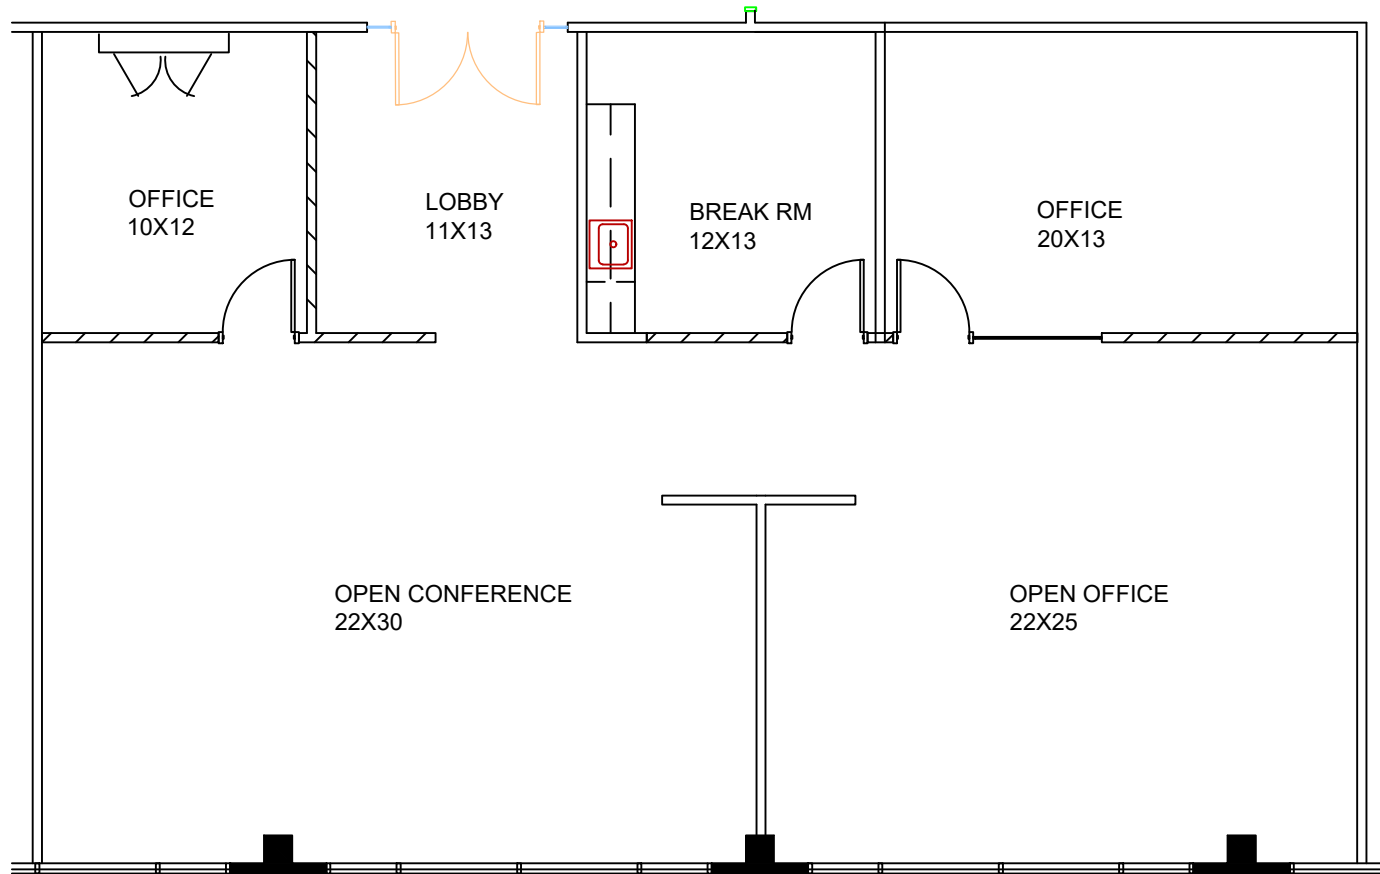

SUITE 380--2,205 RSF

SCALE: N.T.S.

SOUTHPOINTE-----AS-BUILT PLAN

1691 PHOENIX BLVD.
ATLANTA, GA 30349

2.28.24

