


326 S. MARBLE ST.

326 S. MARBLE ST
ROCKMART, GA 30153
AS-BUILTS

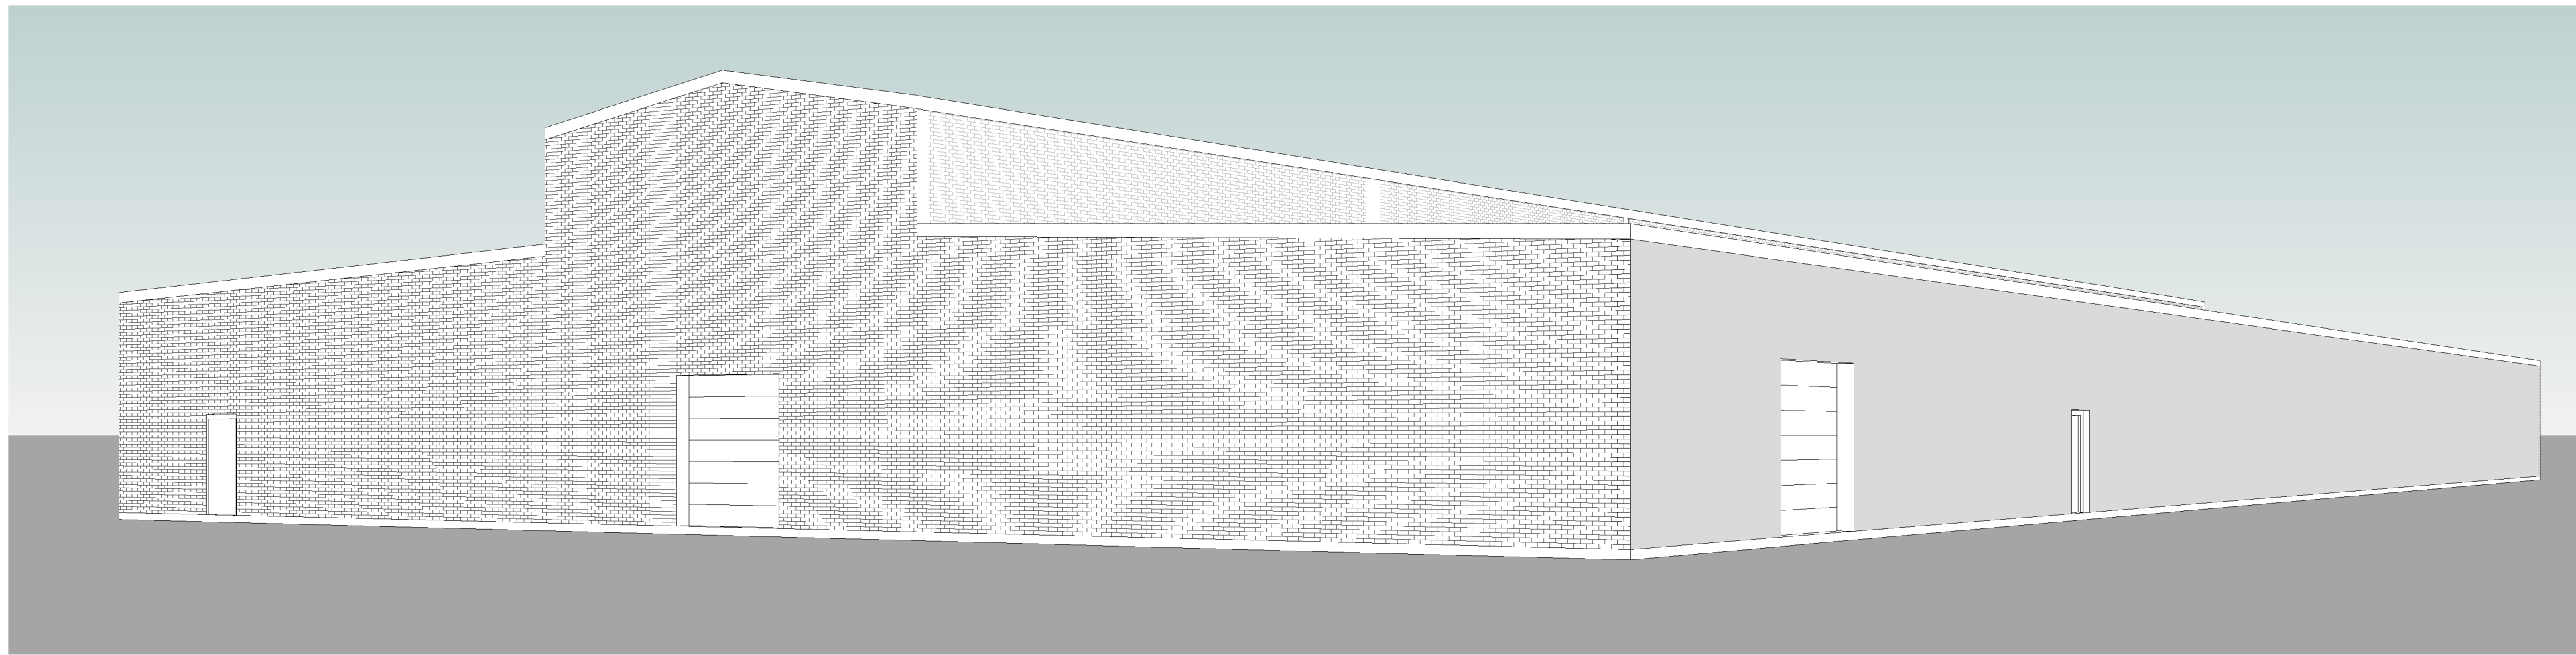


ARCHITECTURAL	
A0-0	COVER
A0-01	AREA PLANS
A1-01	OVERALL FLOOR PLAN
A3-01	ELEVATIONS

BUILDING INFO

AS-BUILT MEASURMENTS TOOK PLACE
ON 11/05/2025

ADDRESS:
326 S. MARBLE ST.
ROCKMART, GA 30153

BUILDING LOCATION

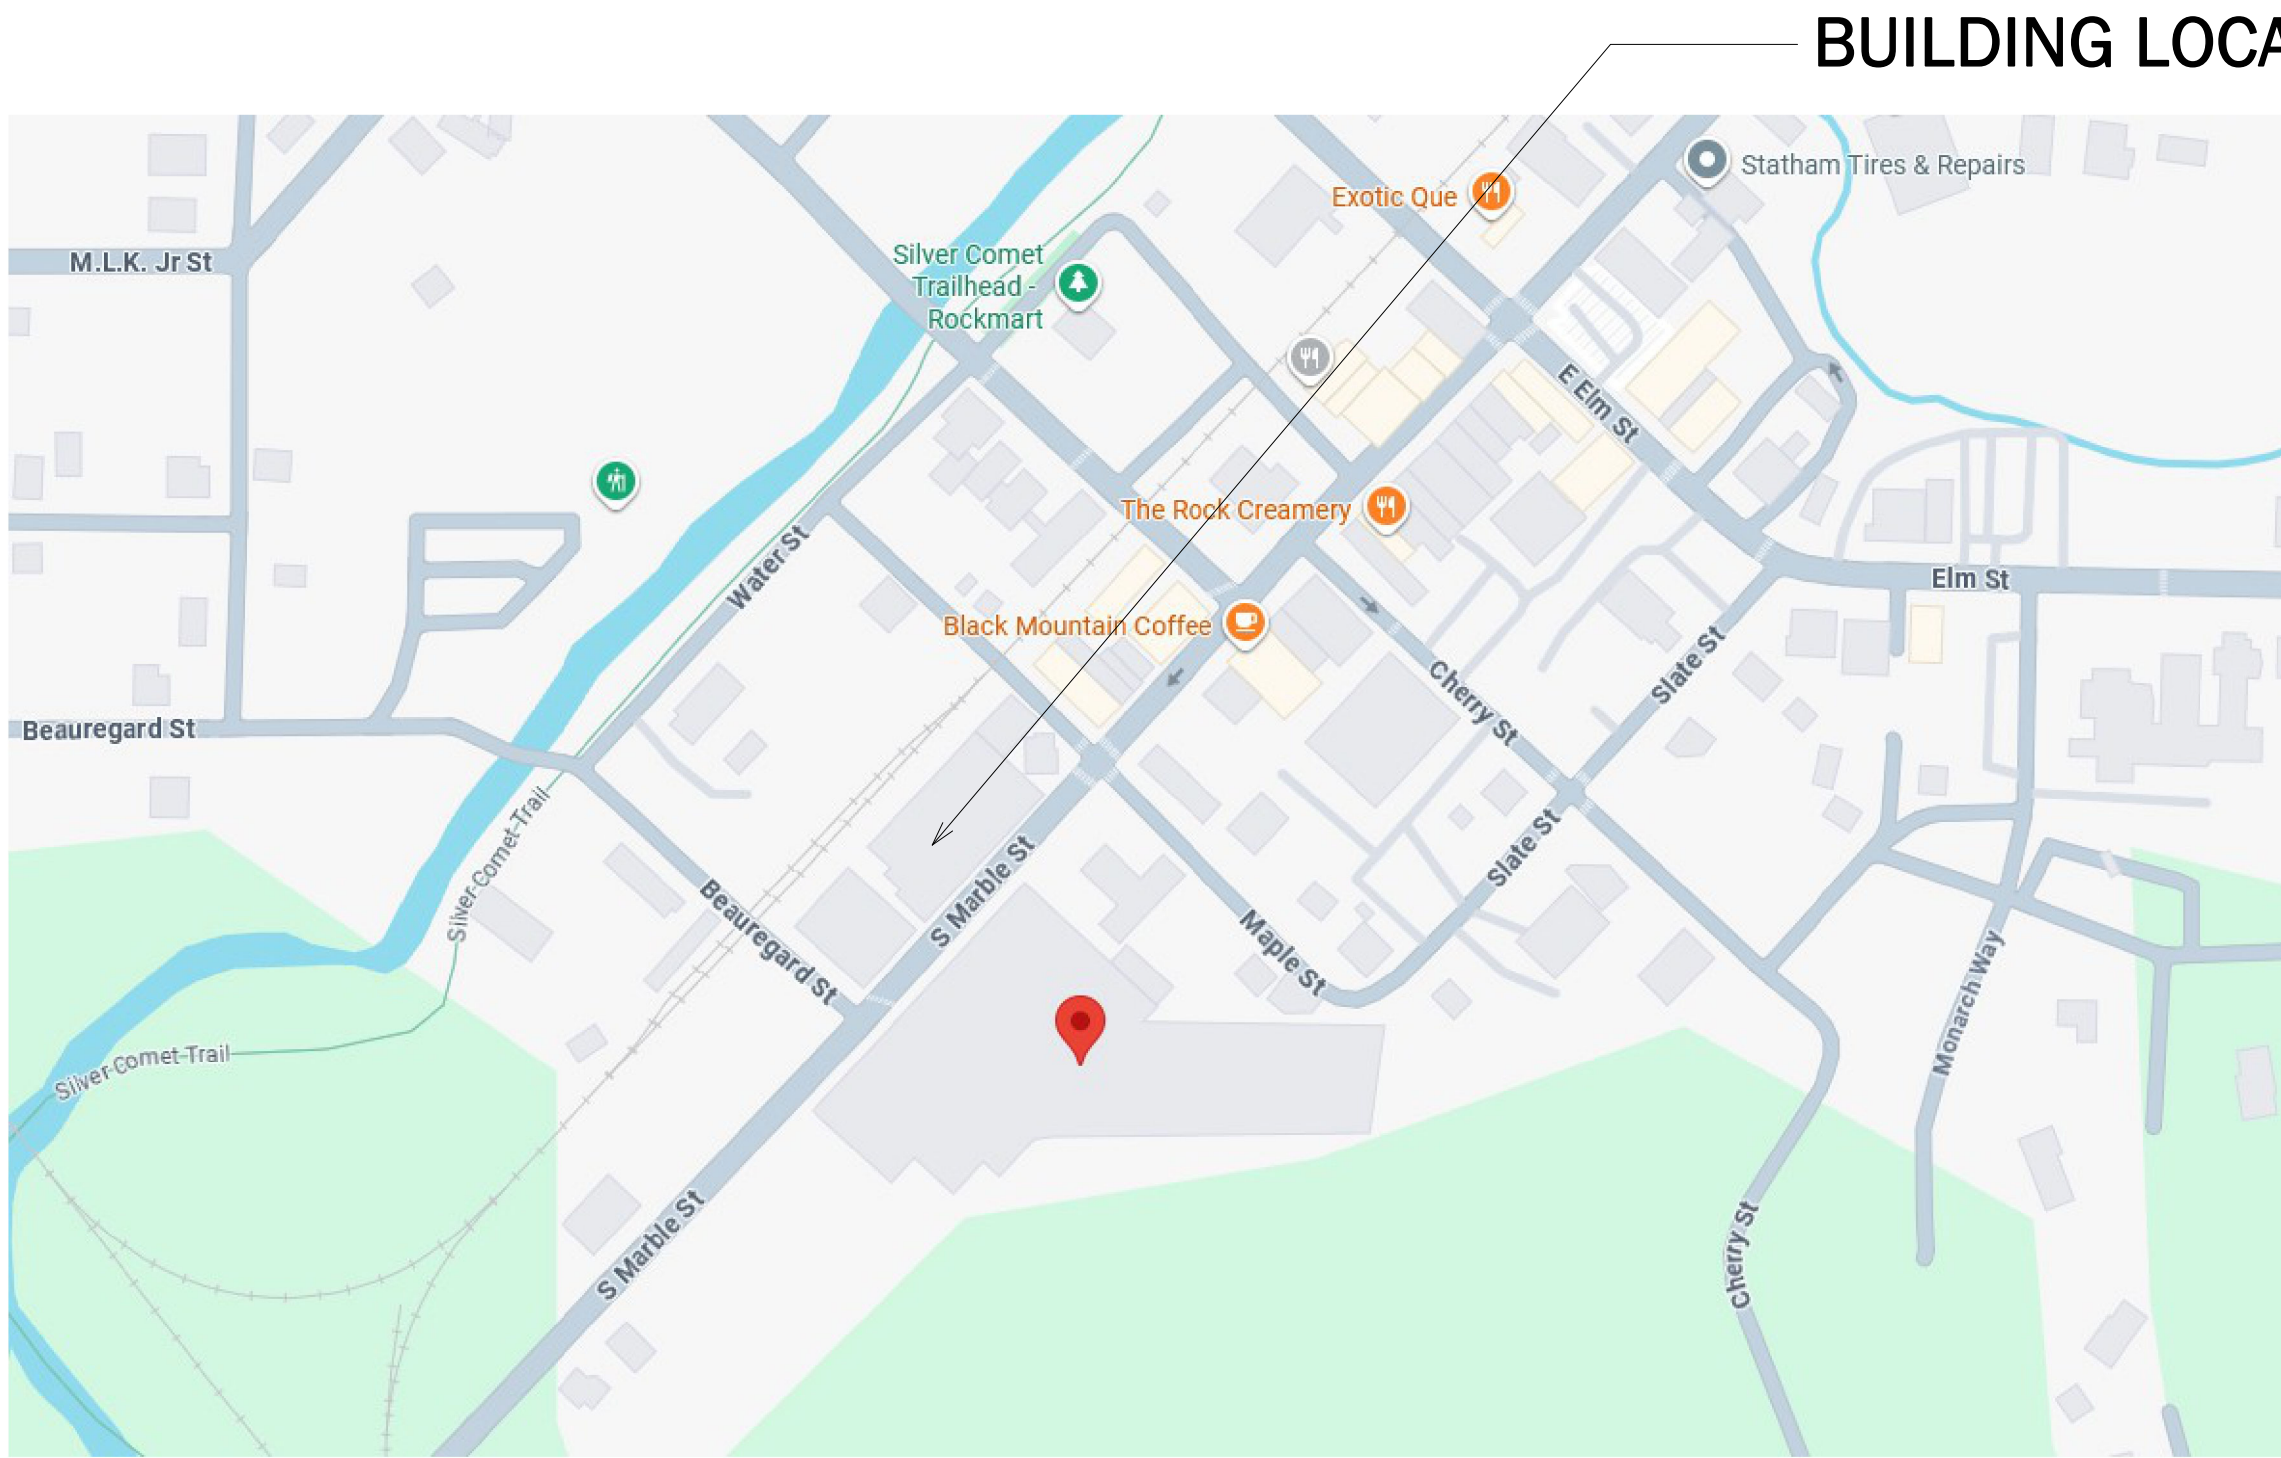

BIM DUDE
AREYNOLDS@BIMDUDE.DESIGN

PROJECT:
S. MARBLE ST.
AS-BUILT

CONSULTANTS:

SEAL

EXISTING
CONDITIONS

SCALE:		DATE: 11/14/25	
DRAWN BY: AR		CHECKED BY: AR	
NO.	REVISION:		DATE:

SHEET TITLE:
COVER

PROJECT NO.
2541-2

SHEET NO.
A0-0



BIM DUDE
AREYNOLDS@BIMDUDE.DESIGN

PROJECT:
S. MARBLE ST.
AS-BUILT

CONSULTANTS:

SEAL:


EXISTING
CONDITIONS

SCALE: As indicated		DATE: 11/14/25	
DRAWN BY: AR		CHECKED BY:	
NO.	REVISION:	DATE:	

SHEET TITLE:
AREA PLANS

PROJECT NO. 2541-2	SHEET NO. A0-01
-----------------------	--------------------

326 S. MARBLE ST.		
	ROOM	SQ/FT
	WAREHOUSE	34,084
	TOTAL	34,084

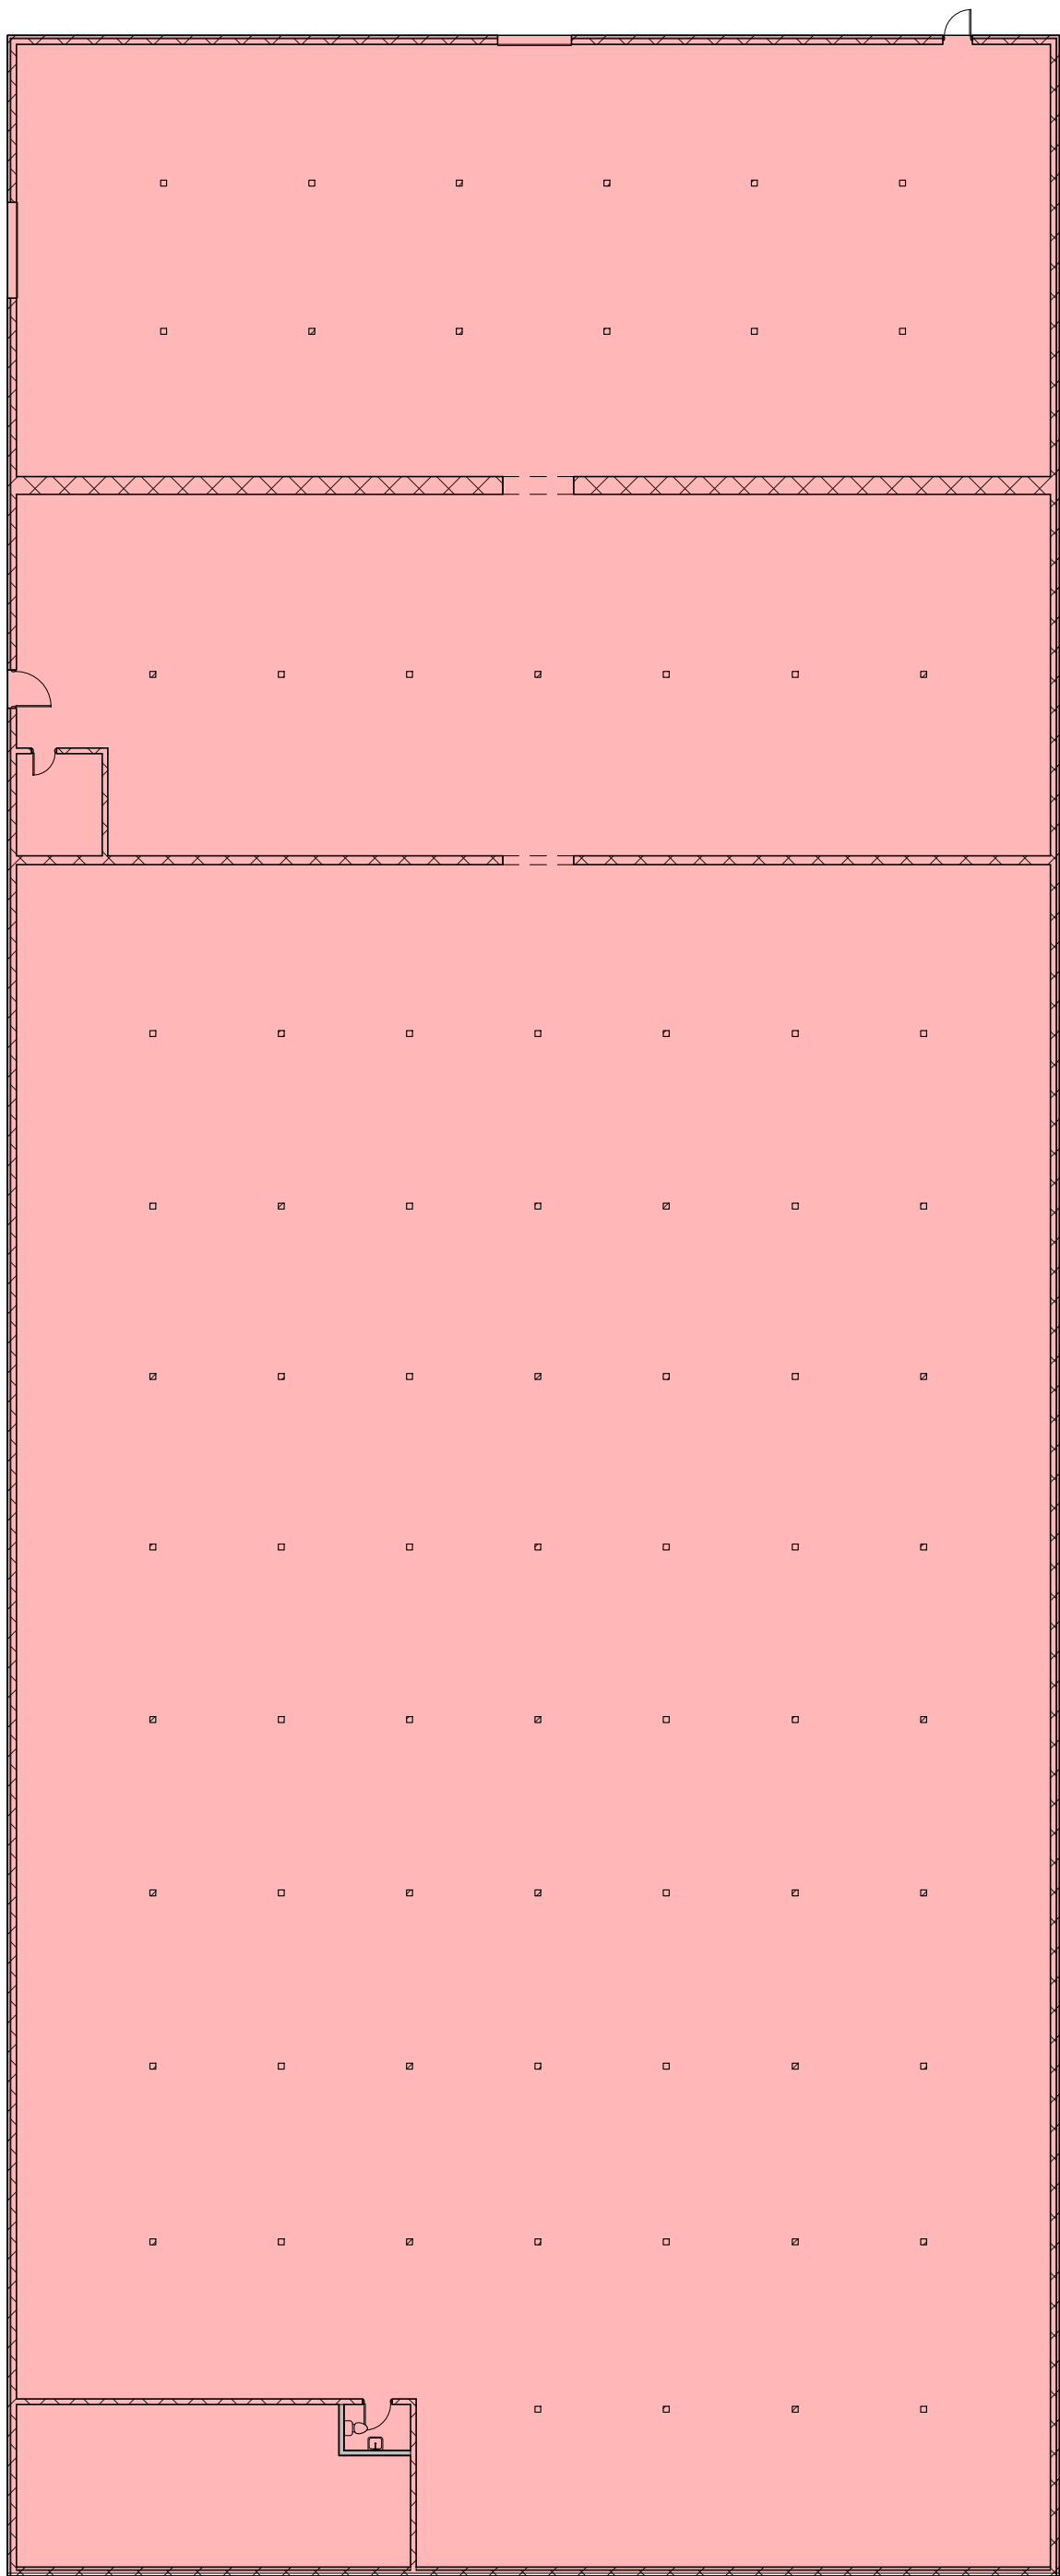

1 AREA PLAN
1" = 20'-0"



BIM DUDE
AREYNOLDS@BIMDUDE.DESIGN

PROJECT:
S. MARBLE ST.
AS-BUILT

CONSULTANTS:


SEAL

EXISTING
CONDITIONS

SCALE: 1/16" = 1'-0"		DATE: 11/14/25	
DRAWN BY: AR		CHECKED BY: AR	
NO.	REVISION:	DATE:	

SHEET TITLE:
OVERALL FLOOR
PLAN

PROJECT NO. 2541-2	SHEET NO. A1-01
-----------------------	--------------------

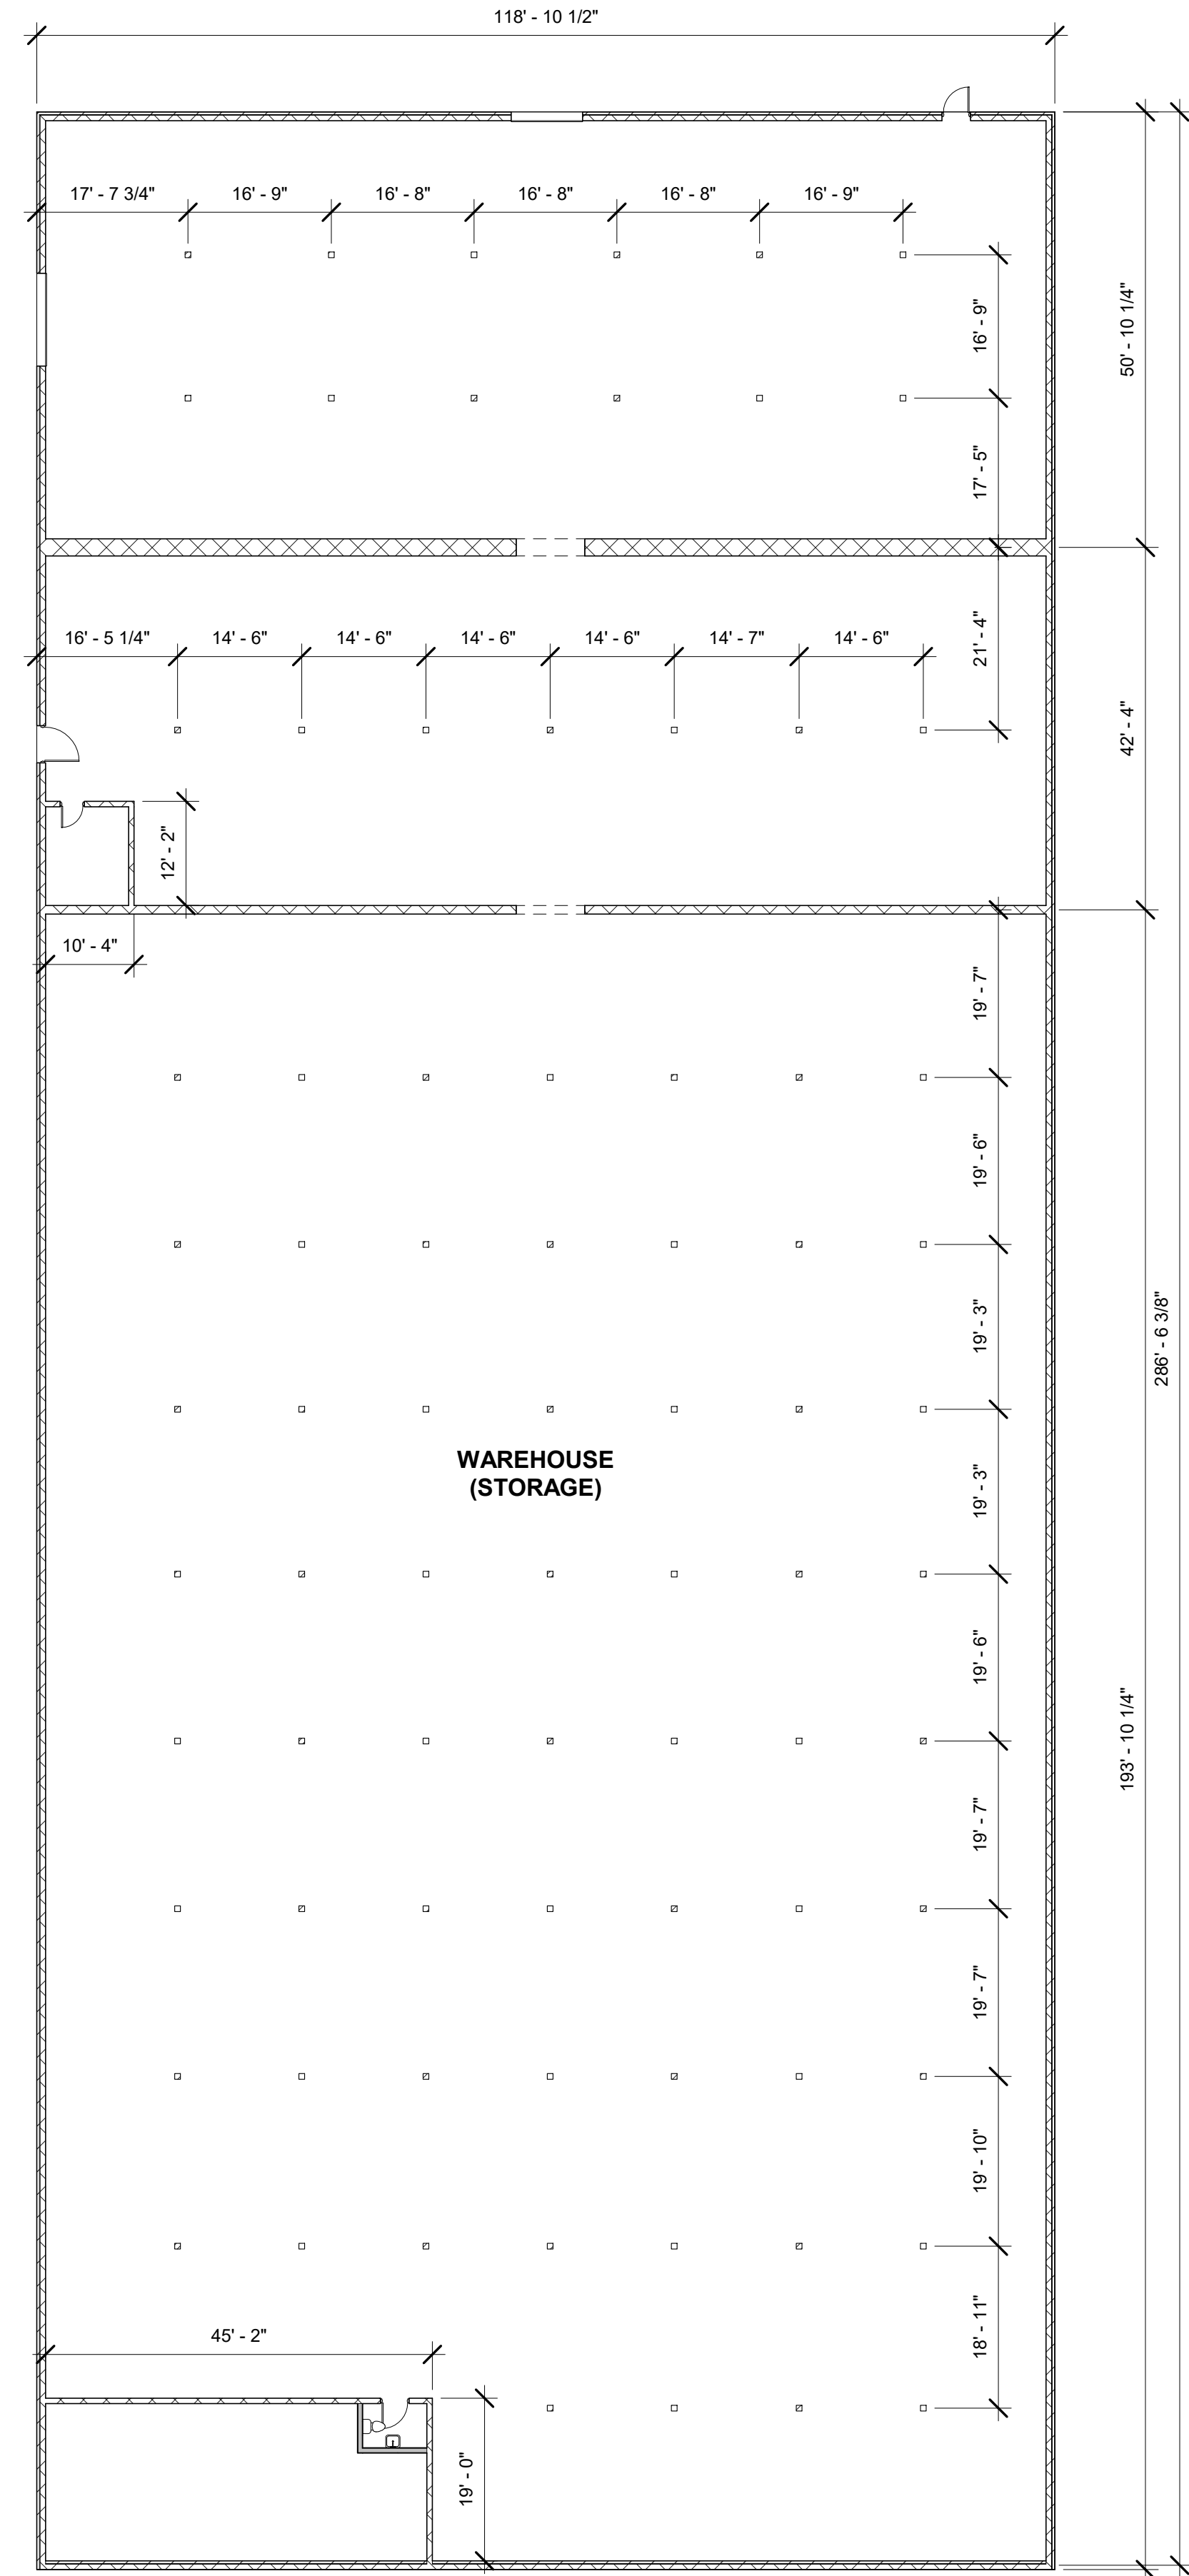

1 OVERALL FLOOR PLAN
1/16" = 1'-0"



BIM DUDE
AREYNOLDS@BIMDUDE.DESIGN

PROJECT:
S. MARBLE ST.
AS-BUILT

CONSULTANTS:

SEAL:


EXISTING
CONDITIONS

SCALE: 1/16" = 1'-0"		DATE: 11/14/25	
DRAWN BY: AR		CHECKED BY: AR	
NO.	REVISION:	DATE:	


SHEET TITLE:
ELEVATIONS

PROJECT NO.
2541-2

SHEET NO.
A3-01

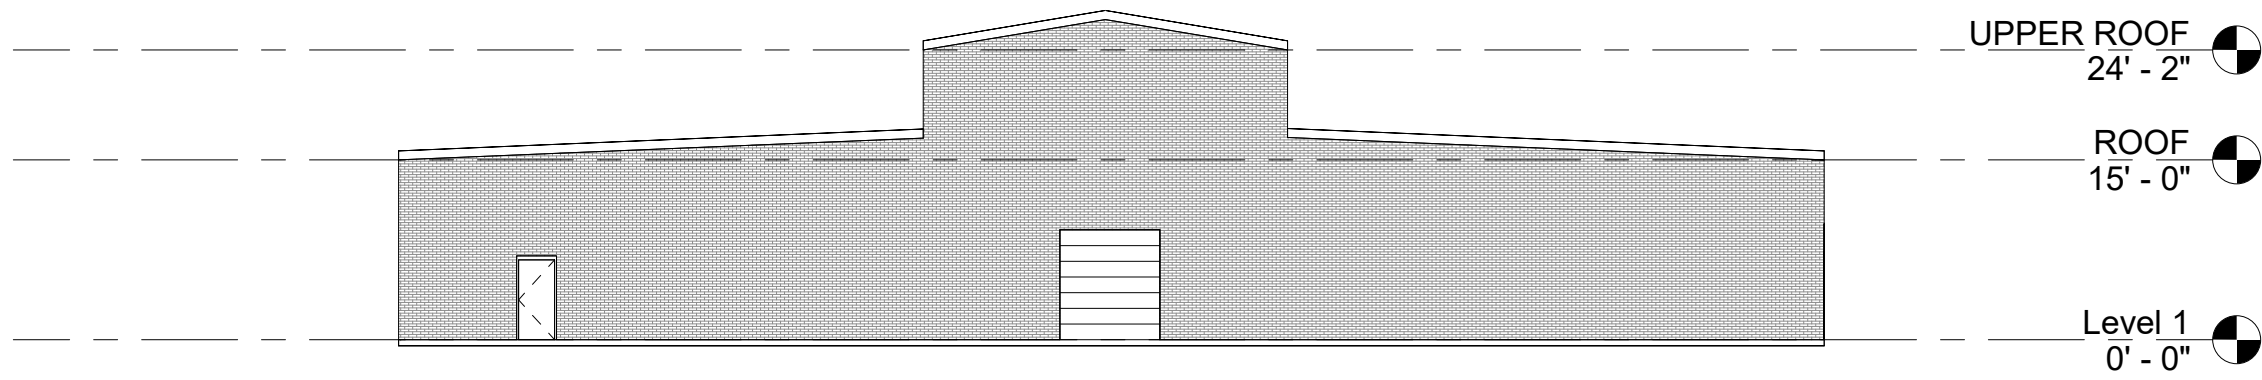

① FRONT ELEVATION
1/16" = 1'-0"

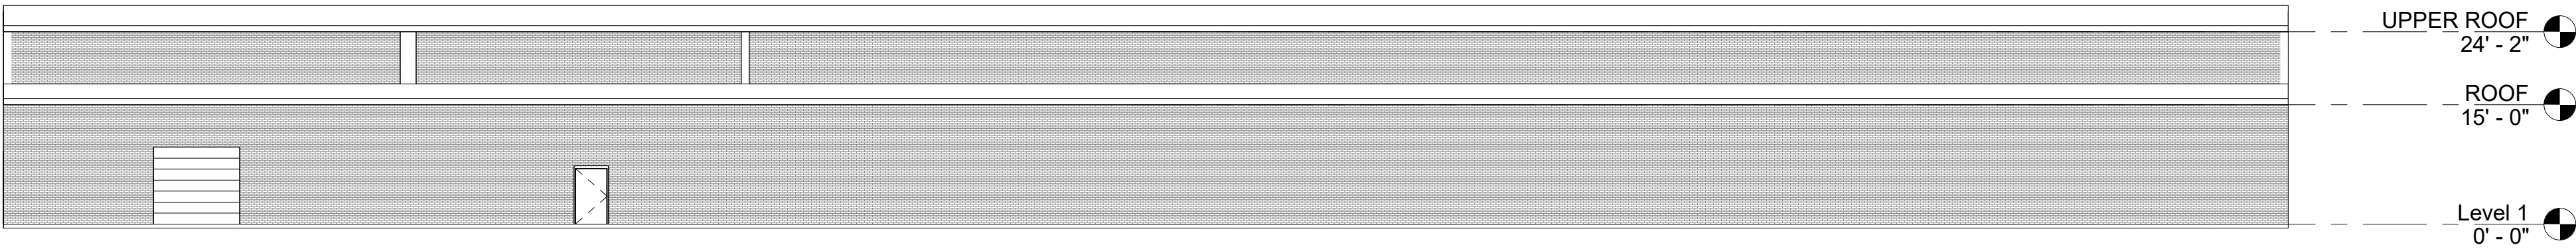

② STREET ELEVATION
1/16" = 1'-0"