


Thacher (Public 40ft. wide) St

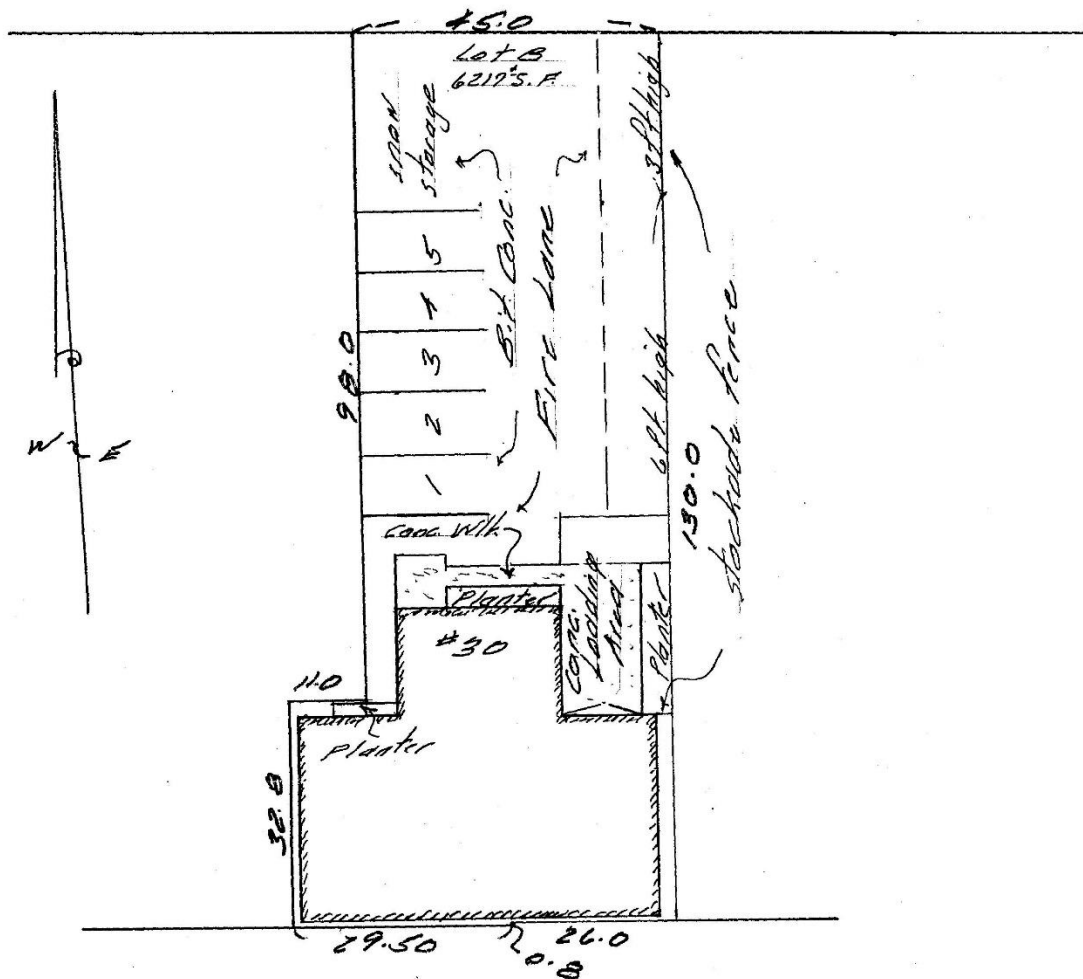

"AS-BUILT"
 PLAN OF LAND
 IN
 MALDEN
 PREPARED BY JEB SURVEY
 OCT 22, 2005 SCALE 1"=20'

