


**As-Built**

**LEGEND**

- ↑ SIDEWALL ADJUSTABLE REGISTER
- ⊗ CEILING 2'x2' LAY IN DIFFUSER
- ▭ CEILING EGGRATE RETURN
- UNIT HEATER
- ▭ FIRE DAMPER (FD)
- INSULATED DUCT
- ⊥ TRANSFER GRILLE
- ⊙ THERMOSTAT
- OPENING ABOVE CEILING

**NOTES:**

- ALL DUCTWORK TO HAVE MAXIMUM 6" OF FLEX TO DIFFUSERS
- LINE RETURN DROP FIRST 6"

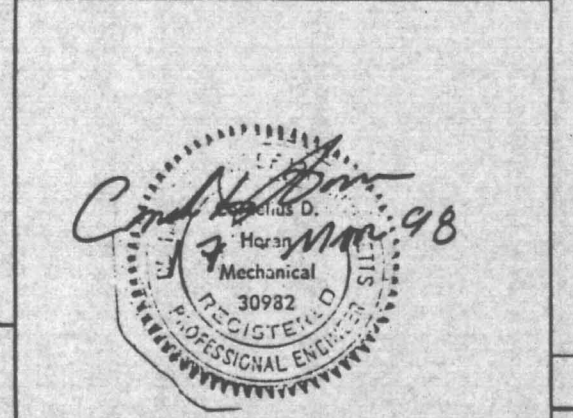

**J.F. PLUMBING CO.**  
 2 CAUSEWAY STREET  
 MEDFIELD, MA. 02052

**HARRIS ENVIRONMENTAL SYSTEMS**  
 11 CONNECTOR ROAD  
 ANDOVER, MASSACHUSETTS 01810  
 TEL. (603) 478-0104

DATE	BY	REVISION	DATE
1/5/98	SB	AS BUILT	1/5/98
04/07/97	CJ	RESUBMIT	04/07/97
01/28/97	SN	CH	01/28/97

**TITLE/SYSTEM**  
 MECHANICAL DUCT LAYOUT  
 (FIRST FLOOR)

**PROJECT**  
 BUILDING 1

**CUSTOMER**  
 NEW BOSTON SEAFOOD

**DATE**  
 01/28/97

**SCALE**  
 1/8" = 1'-0"