



**Dean Associates**  
Architects Incorporated  
Architecture & Interior Design

7 Kimball Lane Suite E6 Lynnfield, MA 01940  
p. 781.397.8092 f. 781.397.8094  
www.deanassoc.com

1	As-Built Survey	10/22/19
	Description	Date

DWG ISSUE & REVISION HISTORY

Stamp


Key Plan

Project Title:
40 NAGOG PARK ACTON MA


Drawing Title:
EXISTING CONDITIONS - 1ST FLOOR

Project Number	2019.53
Scale	AS NOTED
Drawn By	PDG
Checked By	JWD
Date	10/22/19

Drawing Number	A-1.0
----------------	-------

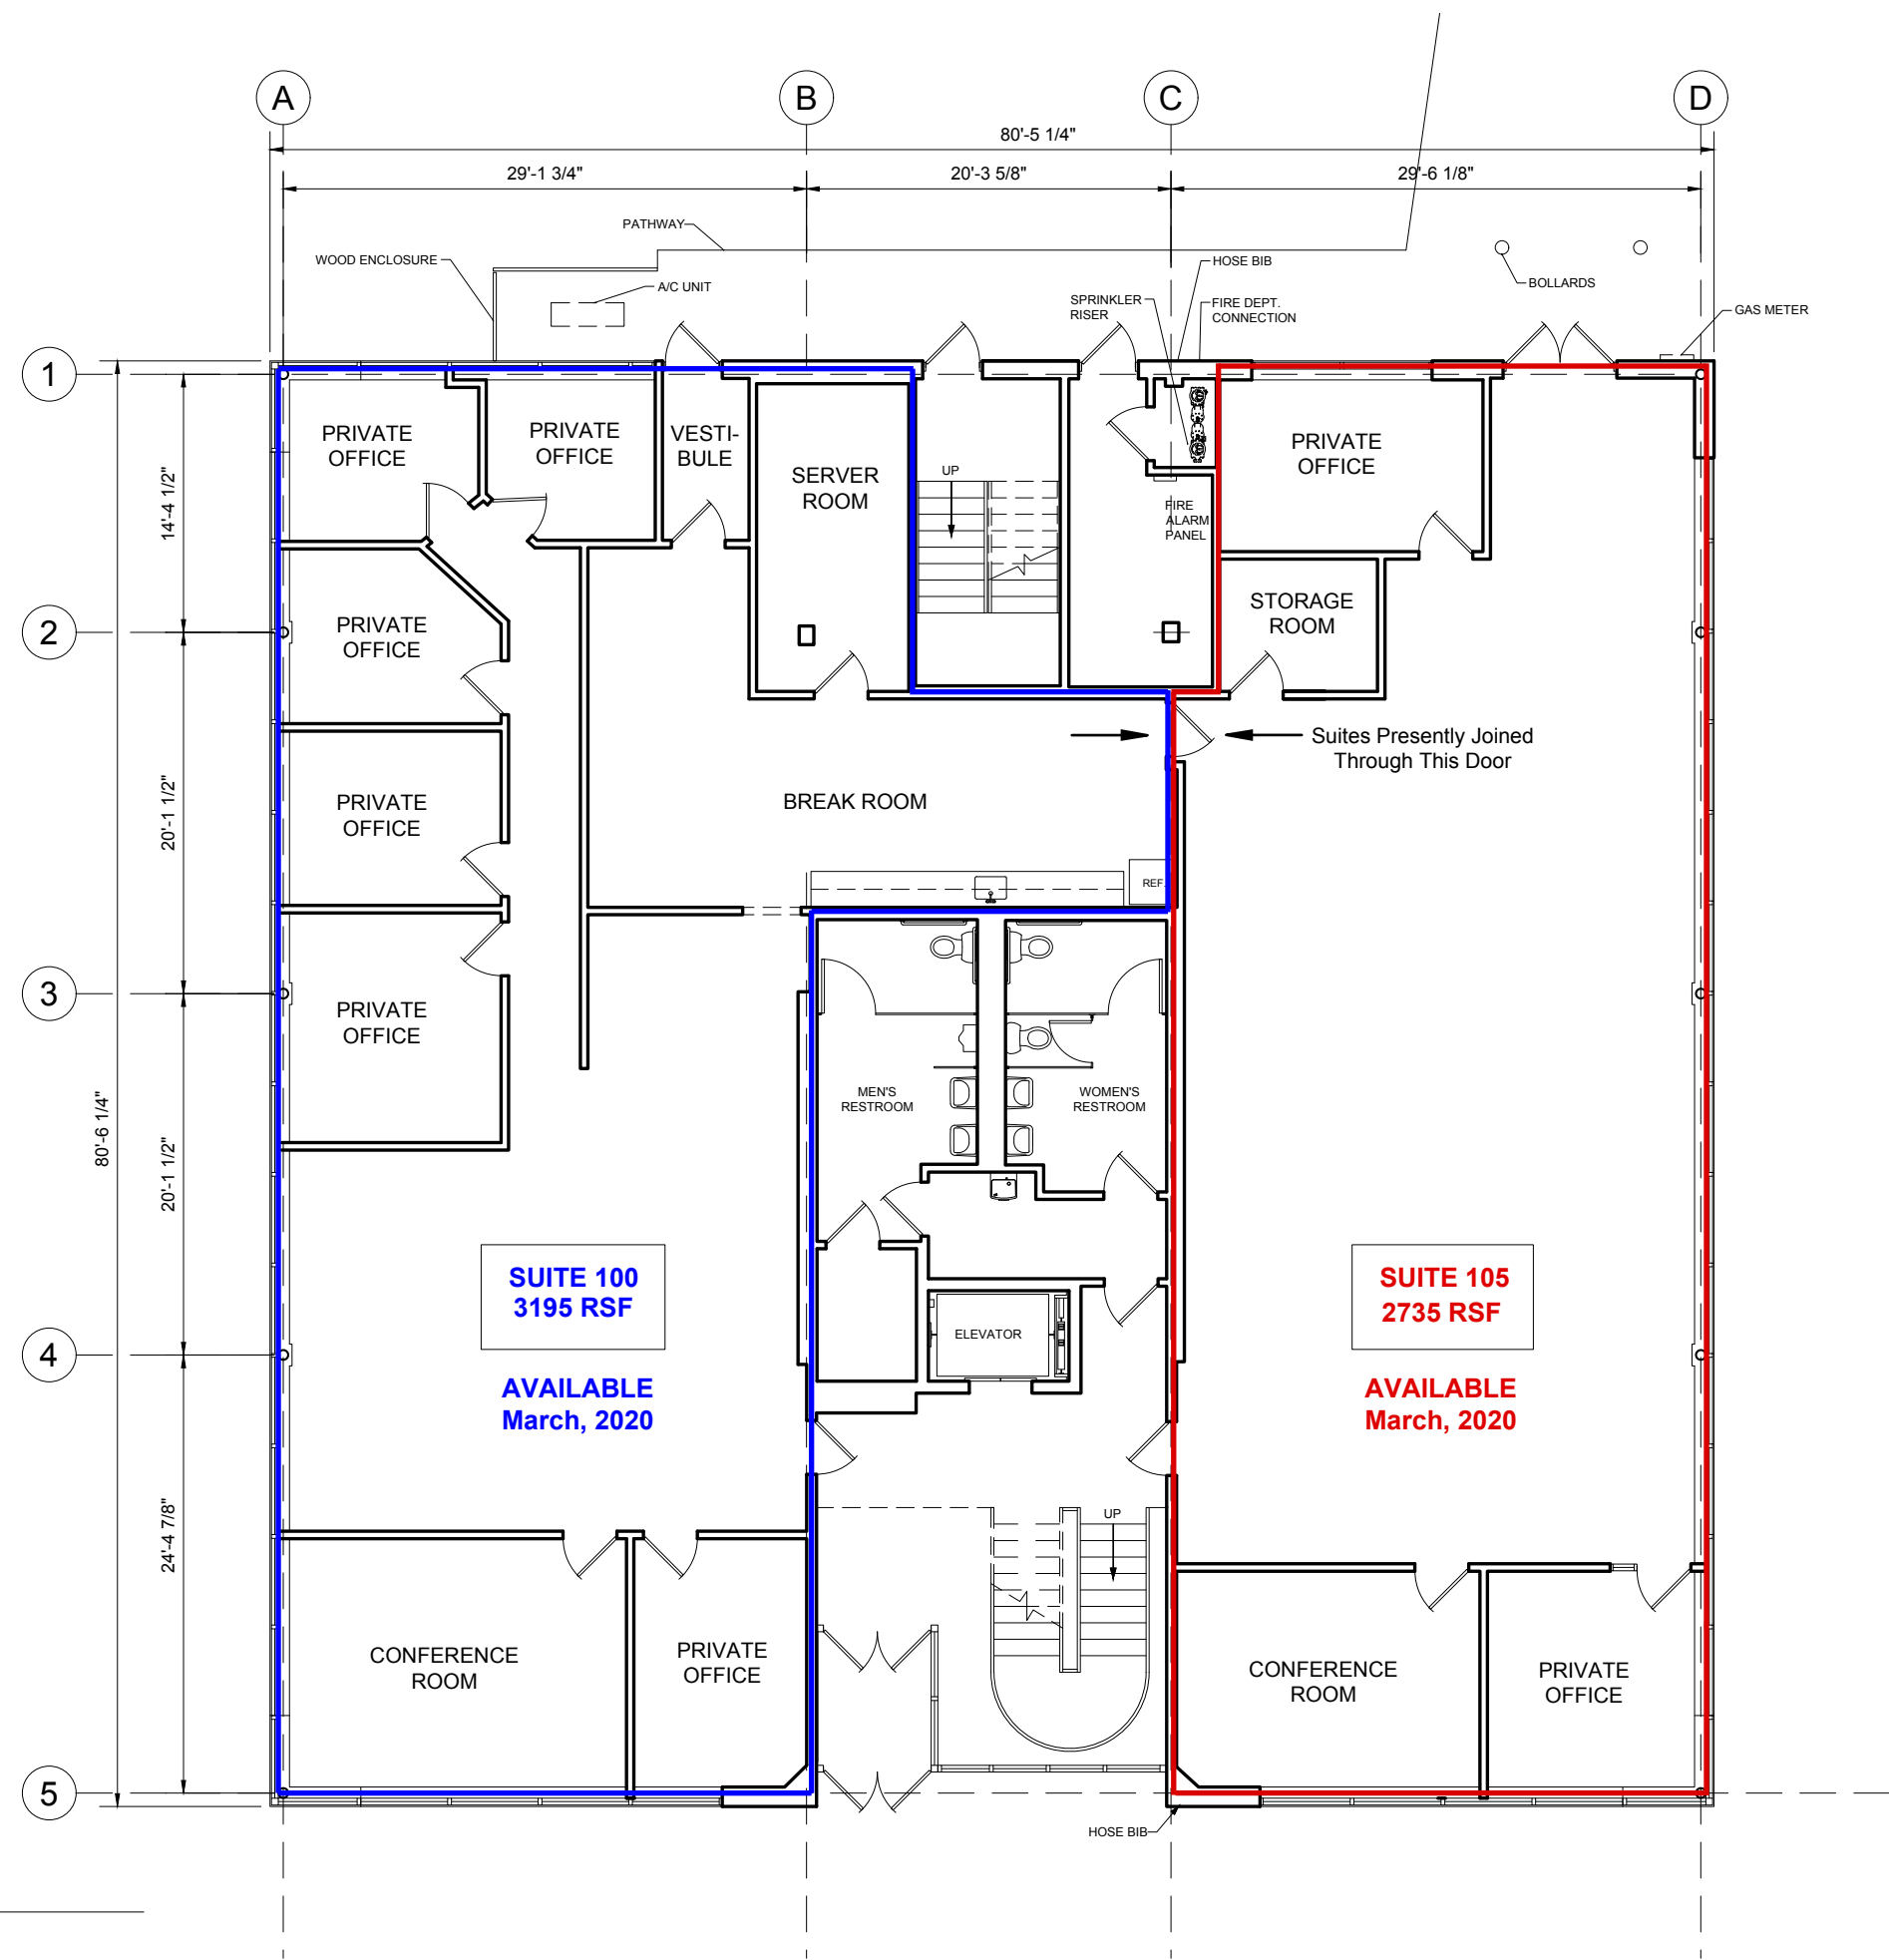

1 FIRST FLOOR PLAN  
A-1.0 SCALE: 3/32" = 1'-0"

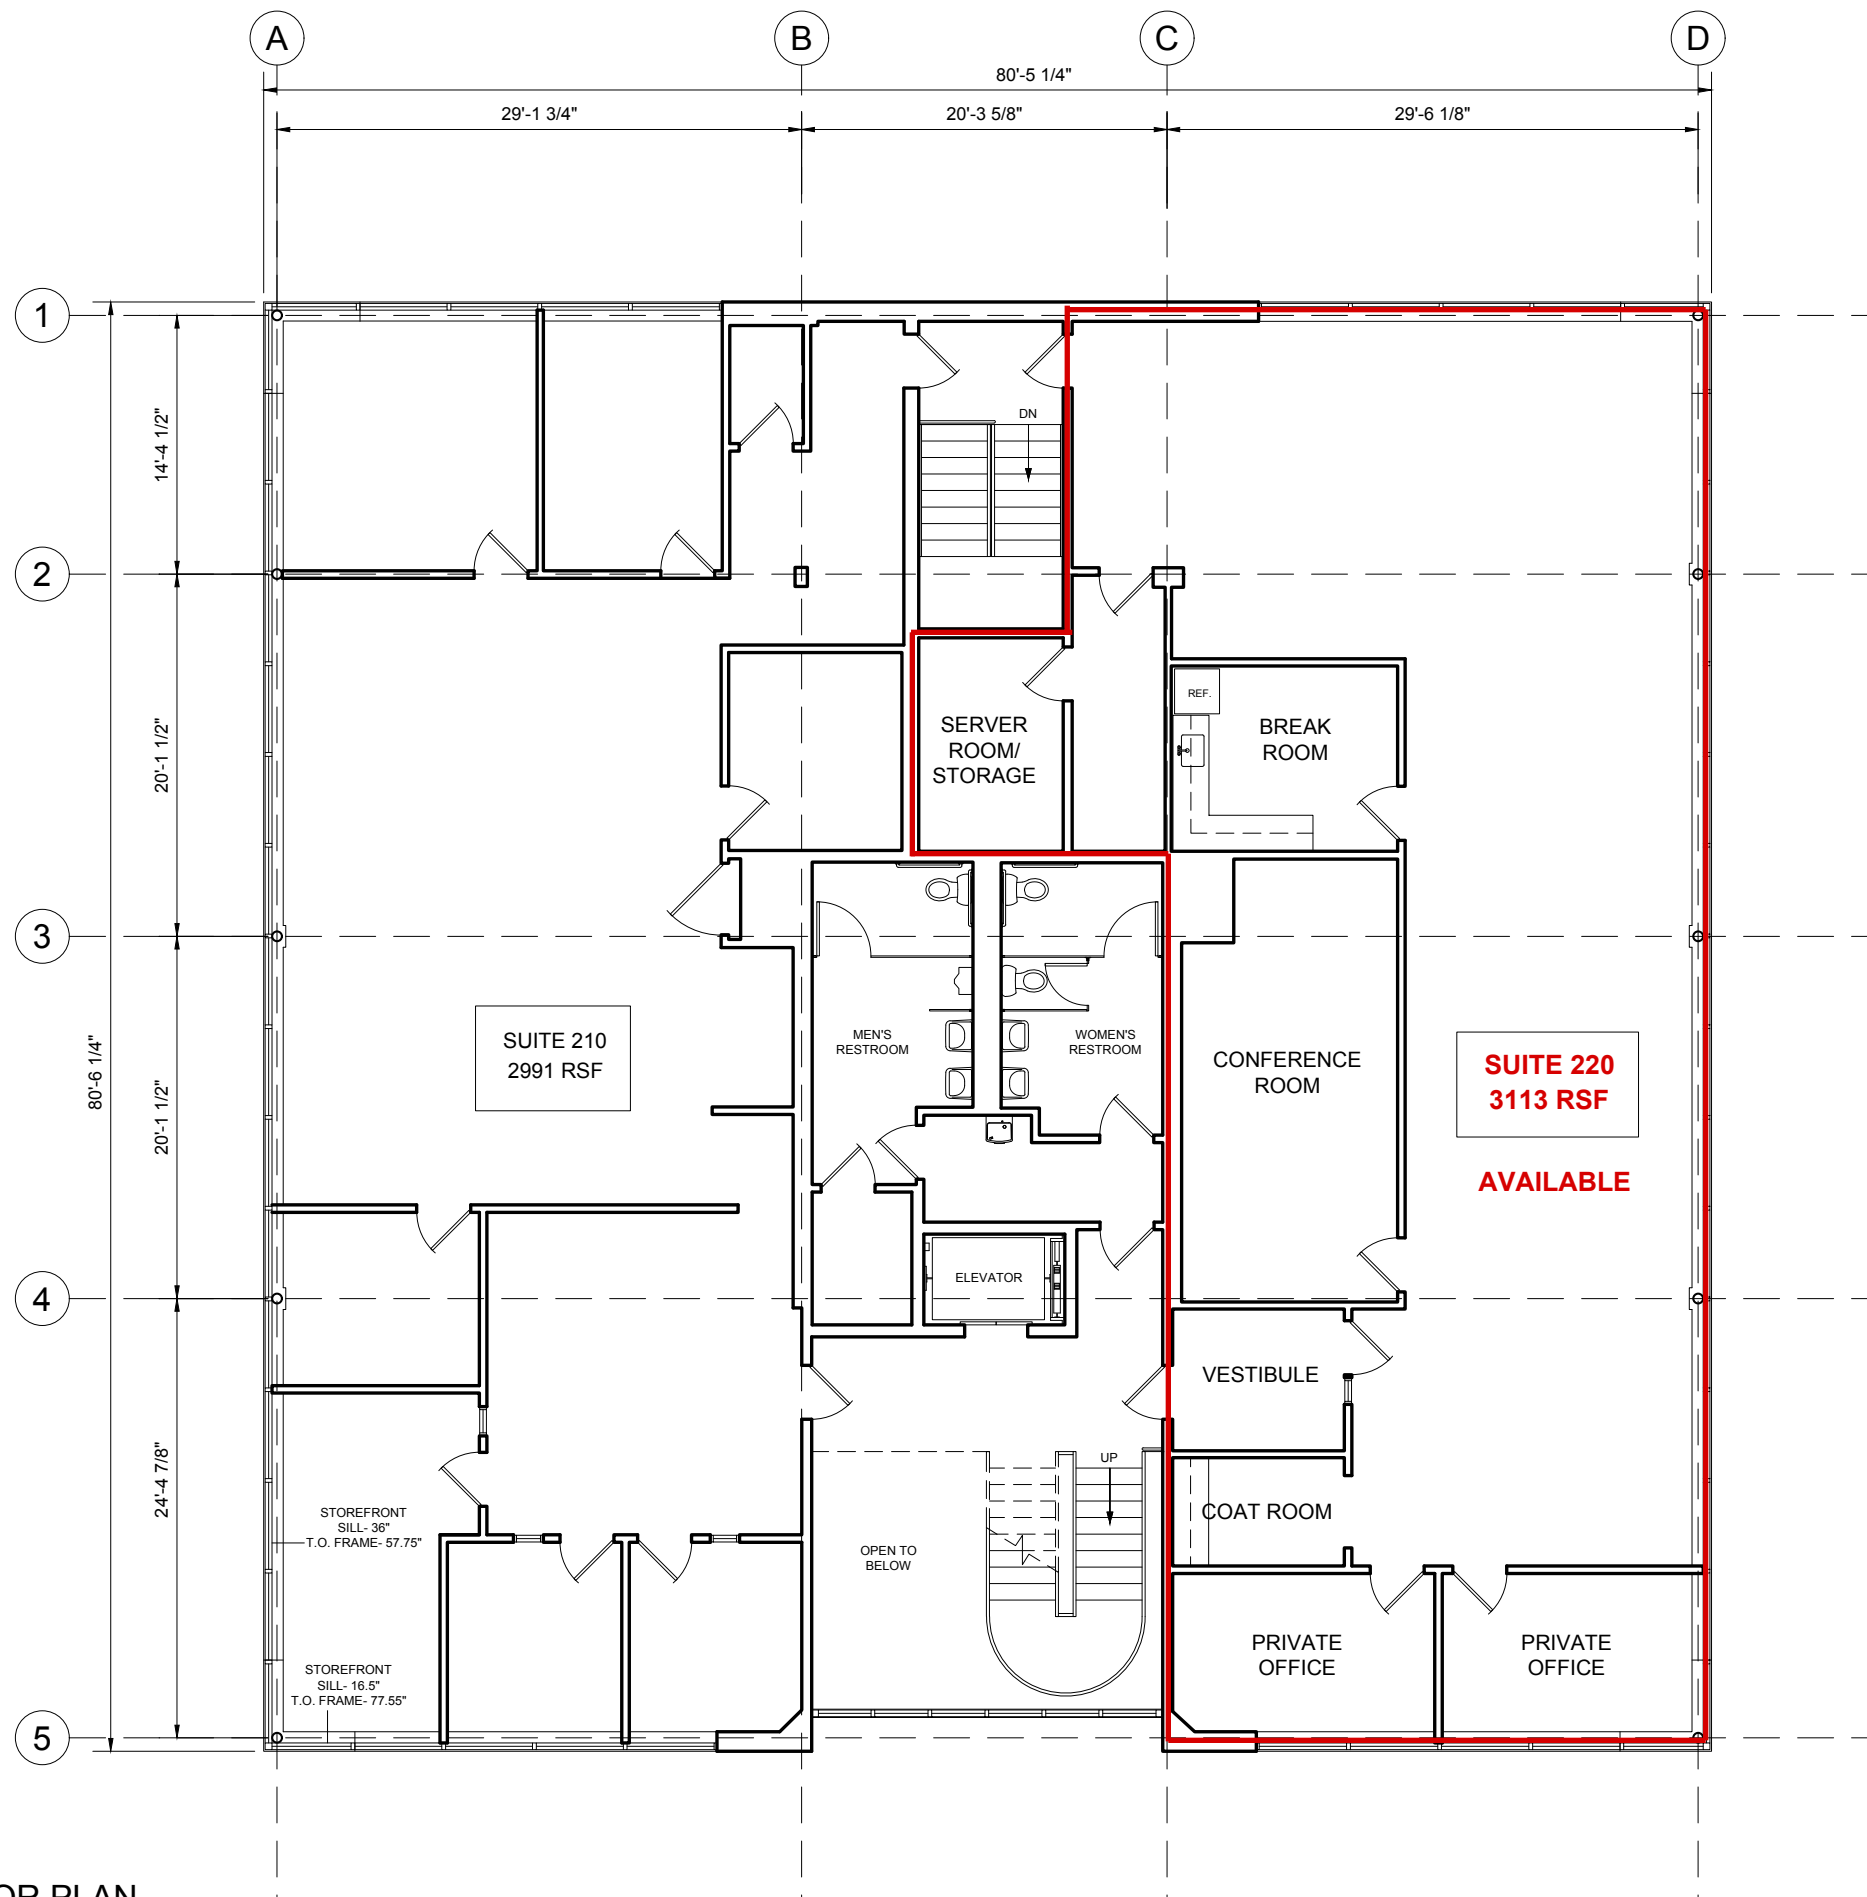

1 SECOND FLOOR PLAN  
A-1.1 SCALE: 3/32" = 1'-0"



**Dean Associates**  
Architects Incorporated  
Architecture & Interior Design

7 Kimball Lane Suite E6 Lynnfield, MA 01940  
p. 781.397.8092 f. 781.397.8094  
www.deanassoc.com

1	As-Built Survey	10/22/19
	Description	Date

DWG ISSUE & REVISION HISTORY

Stamp

Key Plan

Project Title:

40 NAGOG PARK  
ACTON MA

Drawing Title:

EXISTING CONDITIONS -  
2ND FLOOR

Project Number  
2019.53

Scale  
AS NOTED


Drawn By  
PDG

Checked By  
JWD

Date  
10/22/19

Drawing Number

A-1.1

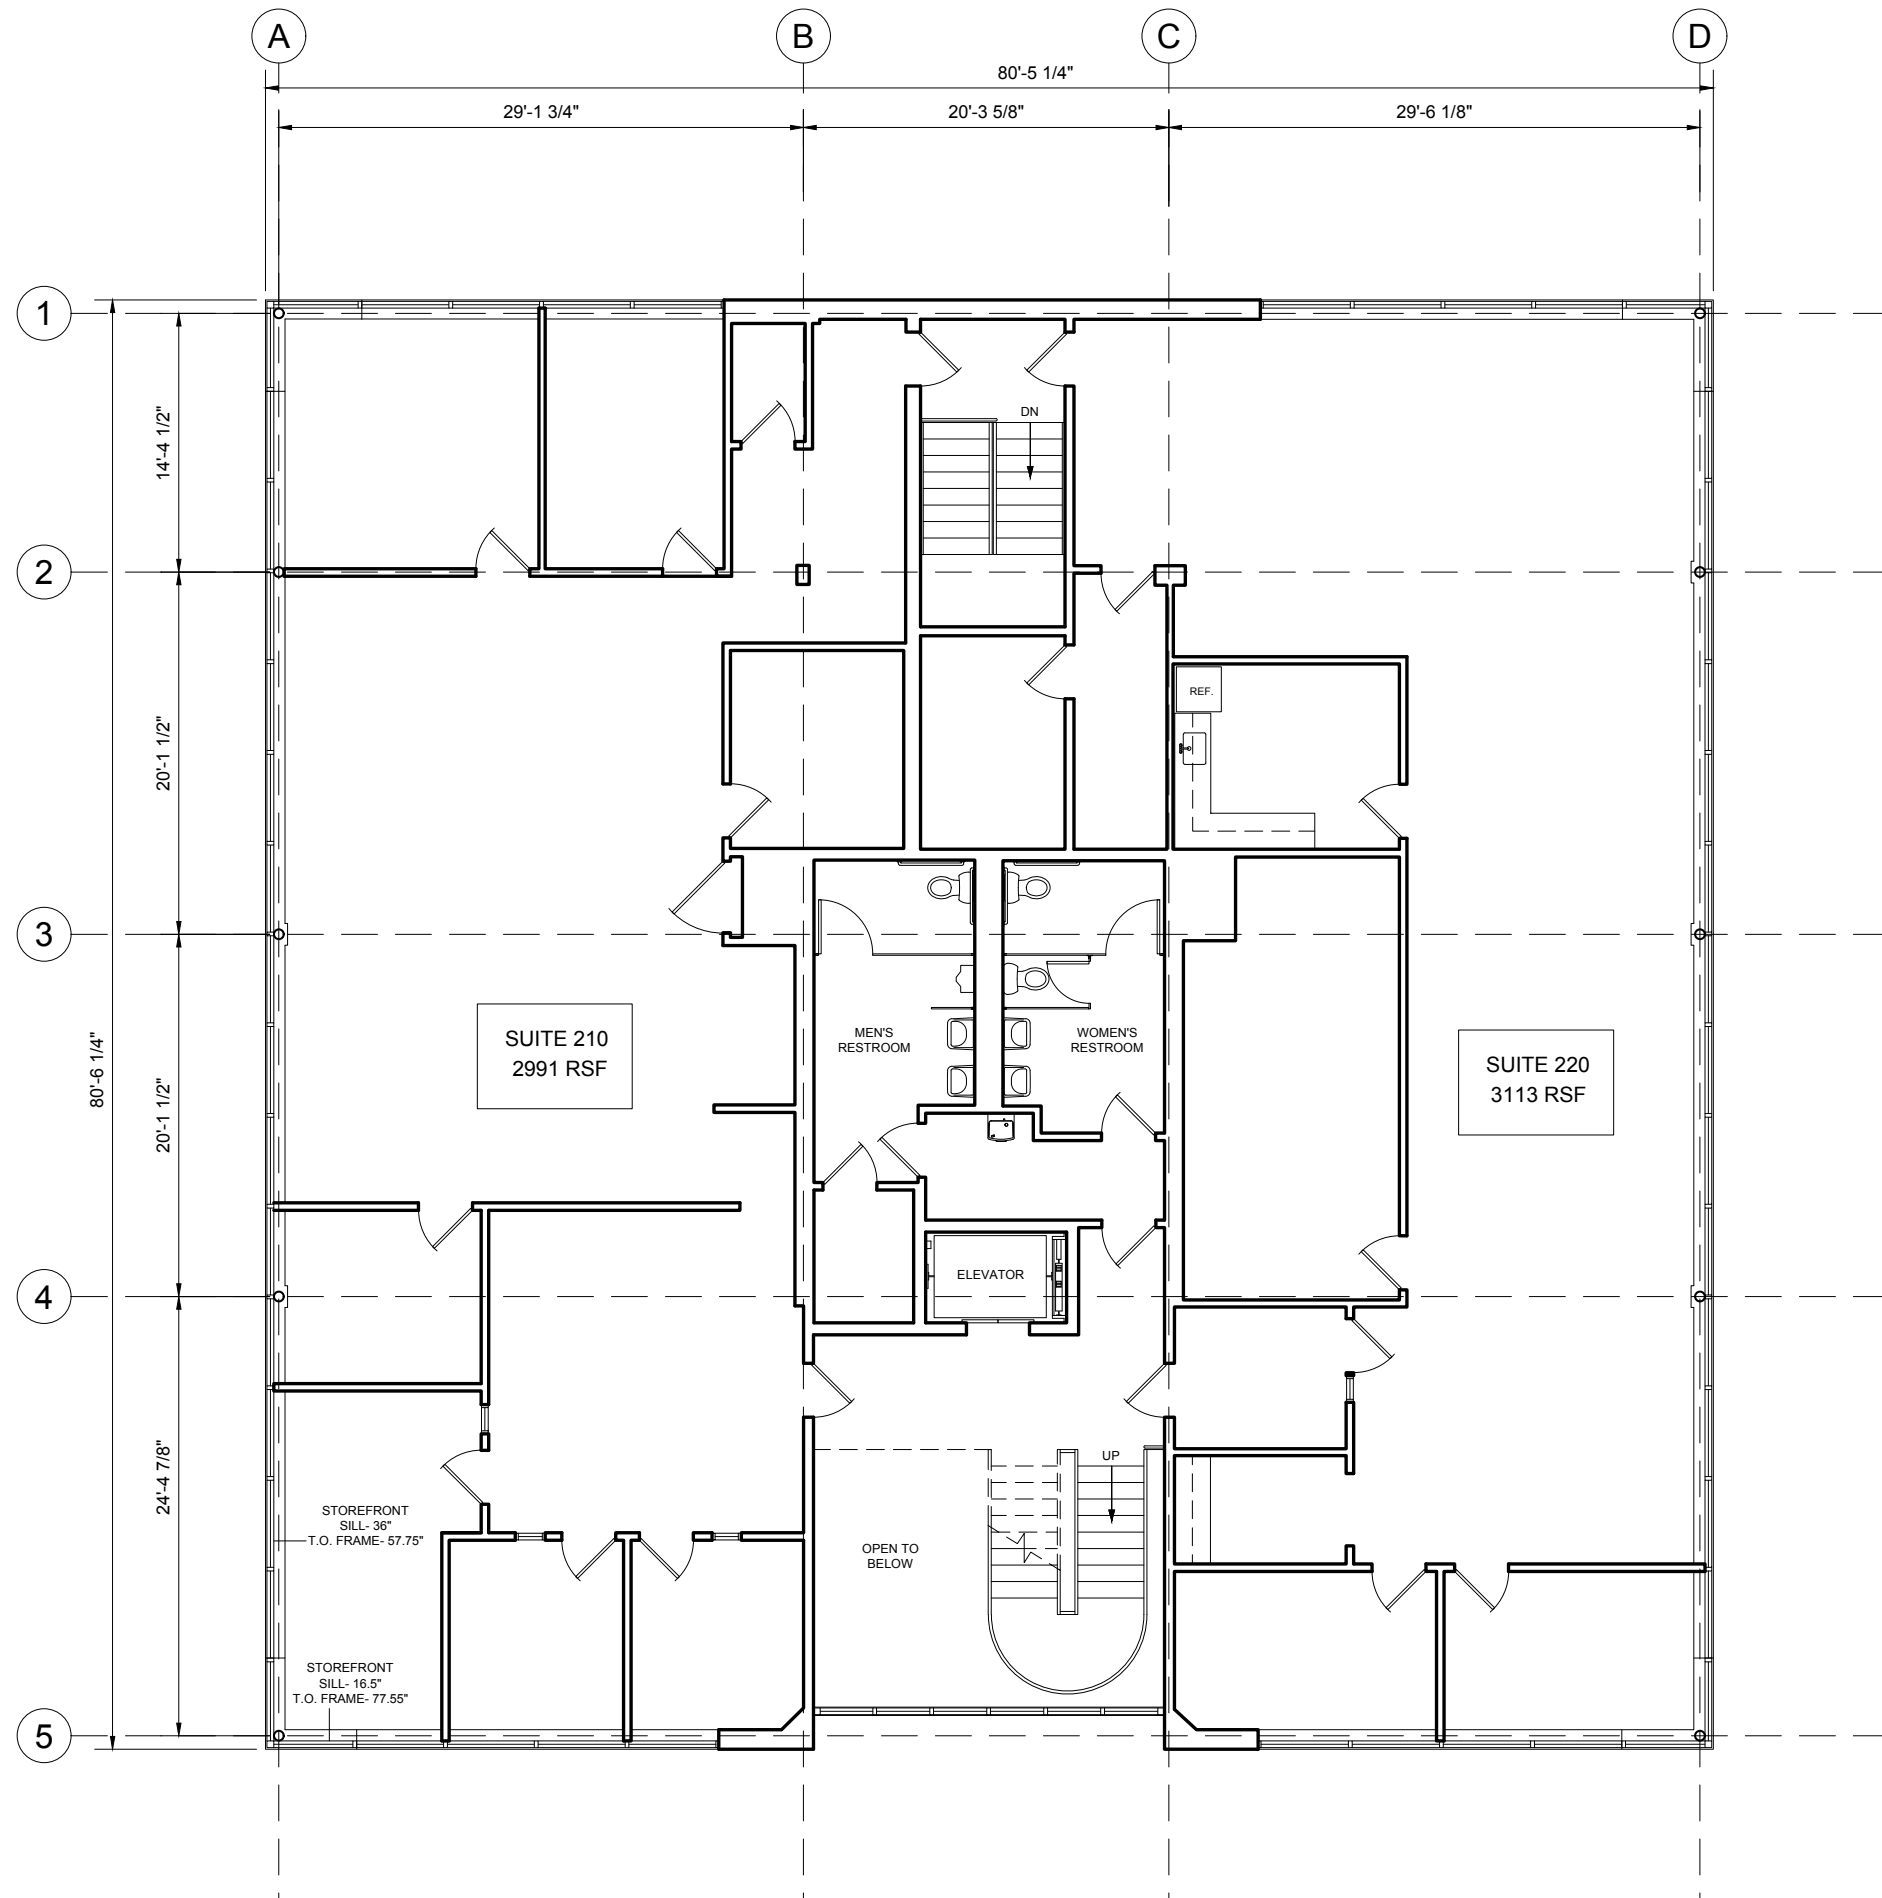

1 THIRD FLOOR PLAN  
A-1.2 SCALE: 3/32" = 1'-0"



**Dean Associates**  
Architects Incorporated  
Architecture & Interior Design

7 Kimball Lane Suite E6 Lynnfield, MA 01940  
p. 781.397.8092 f. 781.397.8094  
www.deanassoc.com

1	As-Built Survey	10/22/19
	Description	Date

DWG ISSUE & REVISION HISTORY

Stamp

Key Plan

Project Title:  
**40 NAGOG PARK  
ACTON MA**

Drawing Title:  
**EXISTING CONDITIONS -  
3RD FLOOR**

Project Number	2019.53
Scale	AS NOTED
Drawn By	PDG
Checked By	JWD
Date	10/22/19

Drawing Number  
**A-1.2**