


TOTAL AREA = 1,060 SF

2 ATTIC FLOOR PLAN

1 FIRST FLOOR PLAN

TOTAL AREA = 25,335 SF

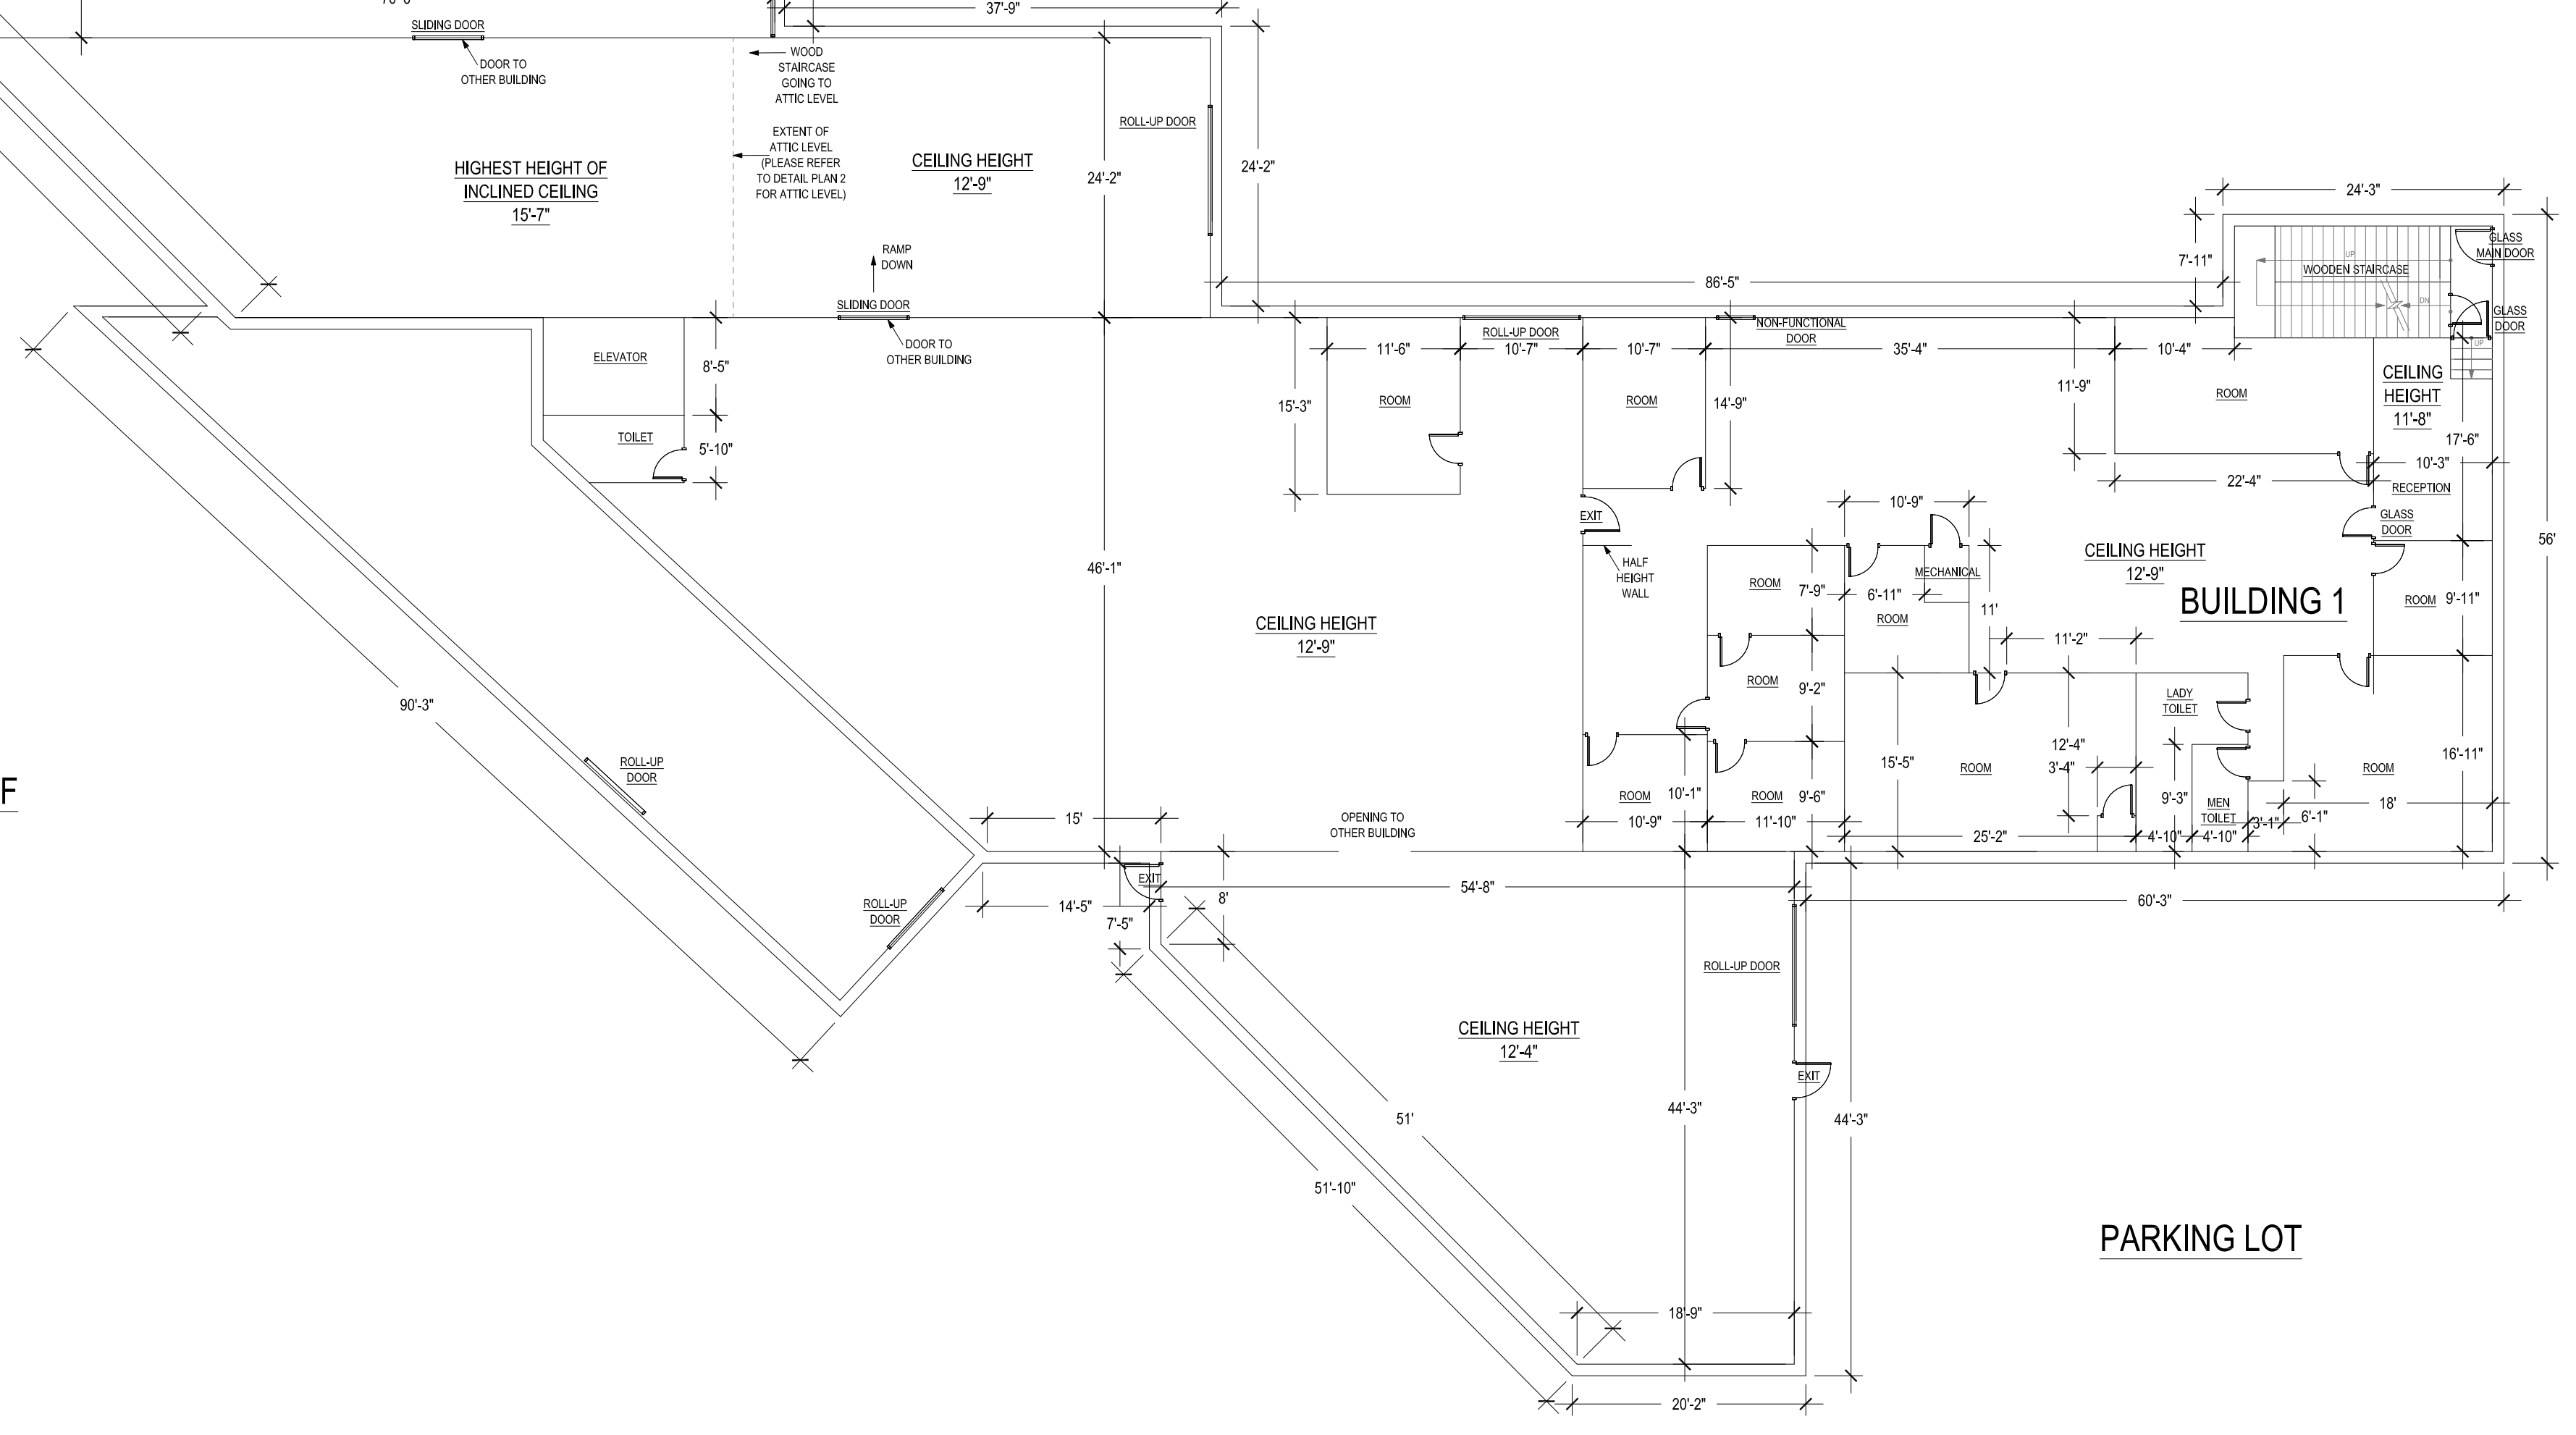

No.	Date	Description

PROJECT  
 224 Washington Street,  
 Perth Amboy, NJ 08861

DRAWING TITLE  
**FIRST AND  
 ATTIC FLOOR PLANS**

Drawn By MM	Drawing No.
Checked By YL	<b>C-101.00</b>
Date	
Scale	Sheet in As-Built Set: of

