

Disclaimer:
As-Built Drawn by BuildingPoint SouthEast
These drawings are not intended to represent in detail
the exact location, type or component nor manner of
construction. BuildingPoint SouthEast will not be
responsible for any errors or omissions which have
been incorporated into the record drawings.

LINDEN COTTON MILL

217 DEPOT ST.
DAVIDSON, NC 28036

REVISIONS

No.	Date	Description




COPYRIGHT:
BUILDINGPOINT SOUTHEAST
PRINTING DATE: 5/10/2019
SCALE: 3/32" = 1'-0"

DRAWING NAME

MAIN LEVEL FLOOR PLAN


DRAWING NUMBER

A100

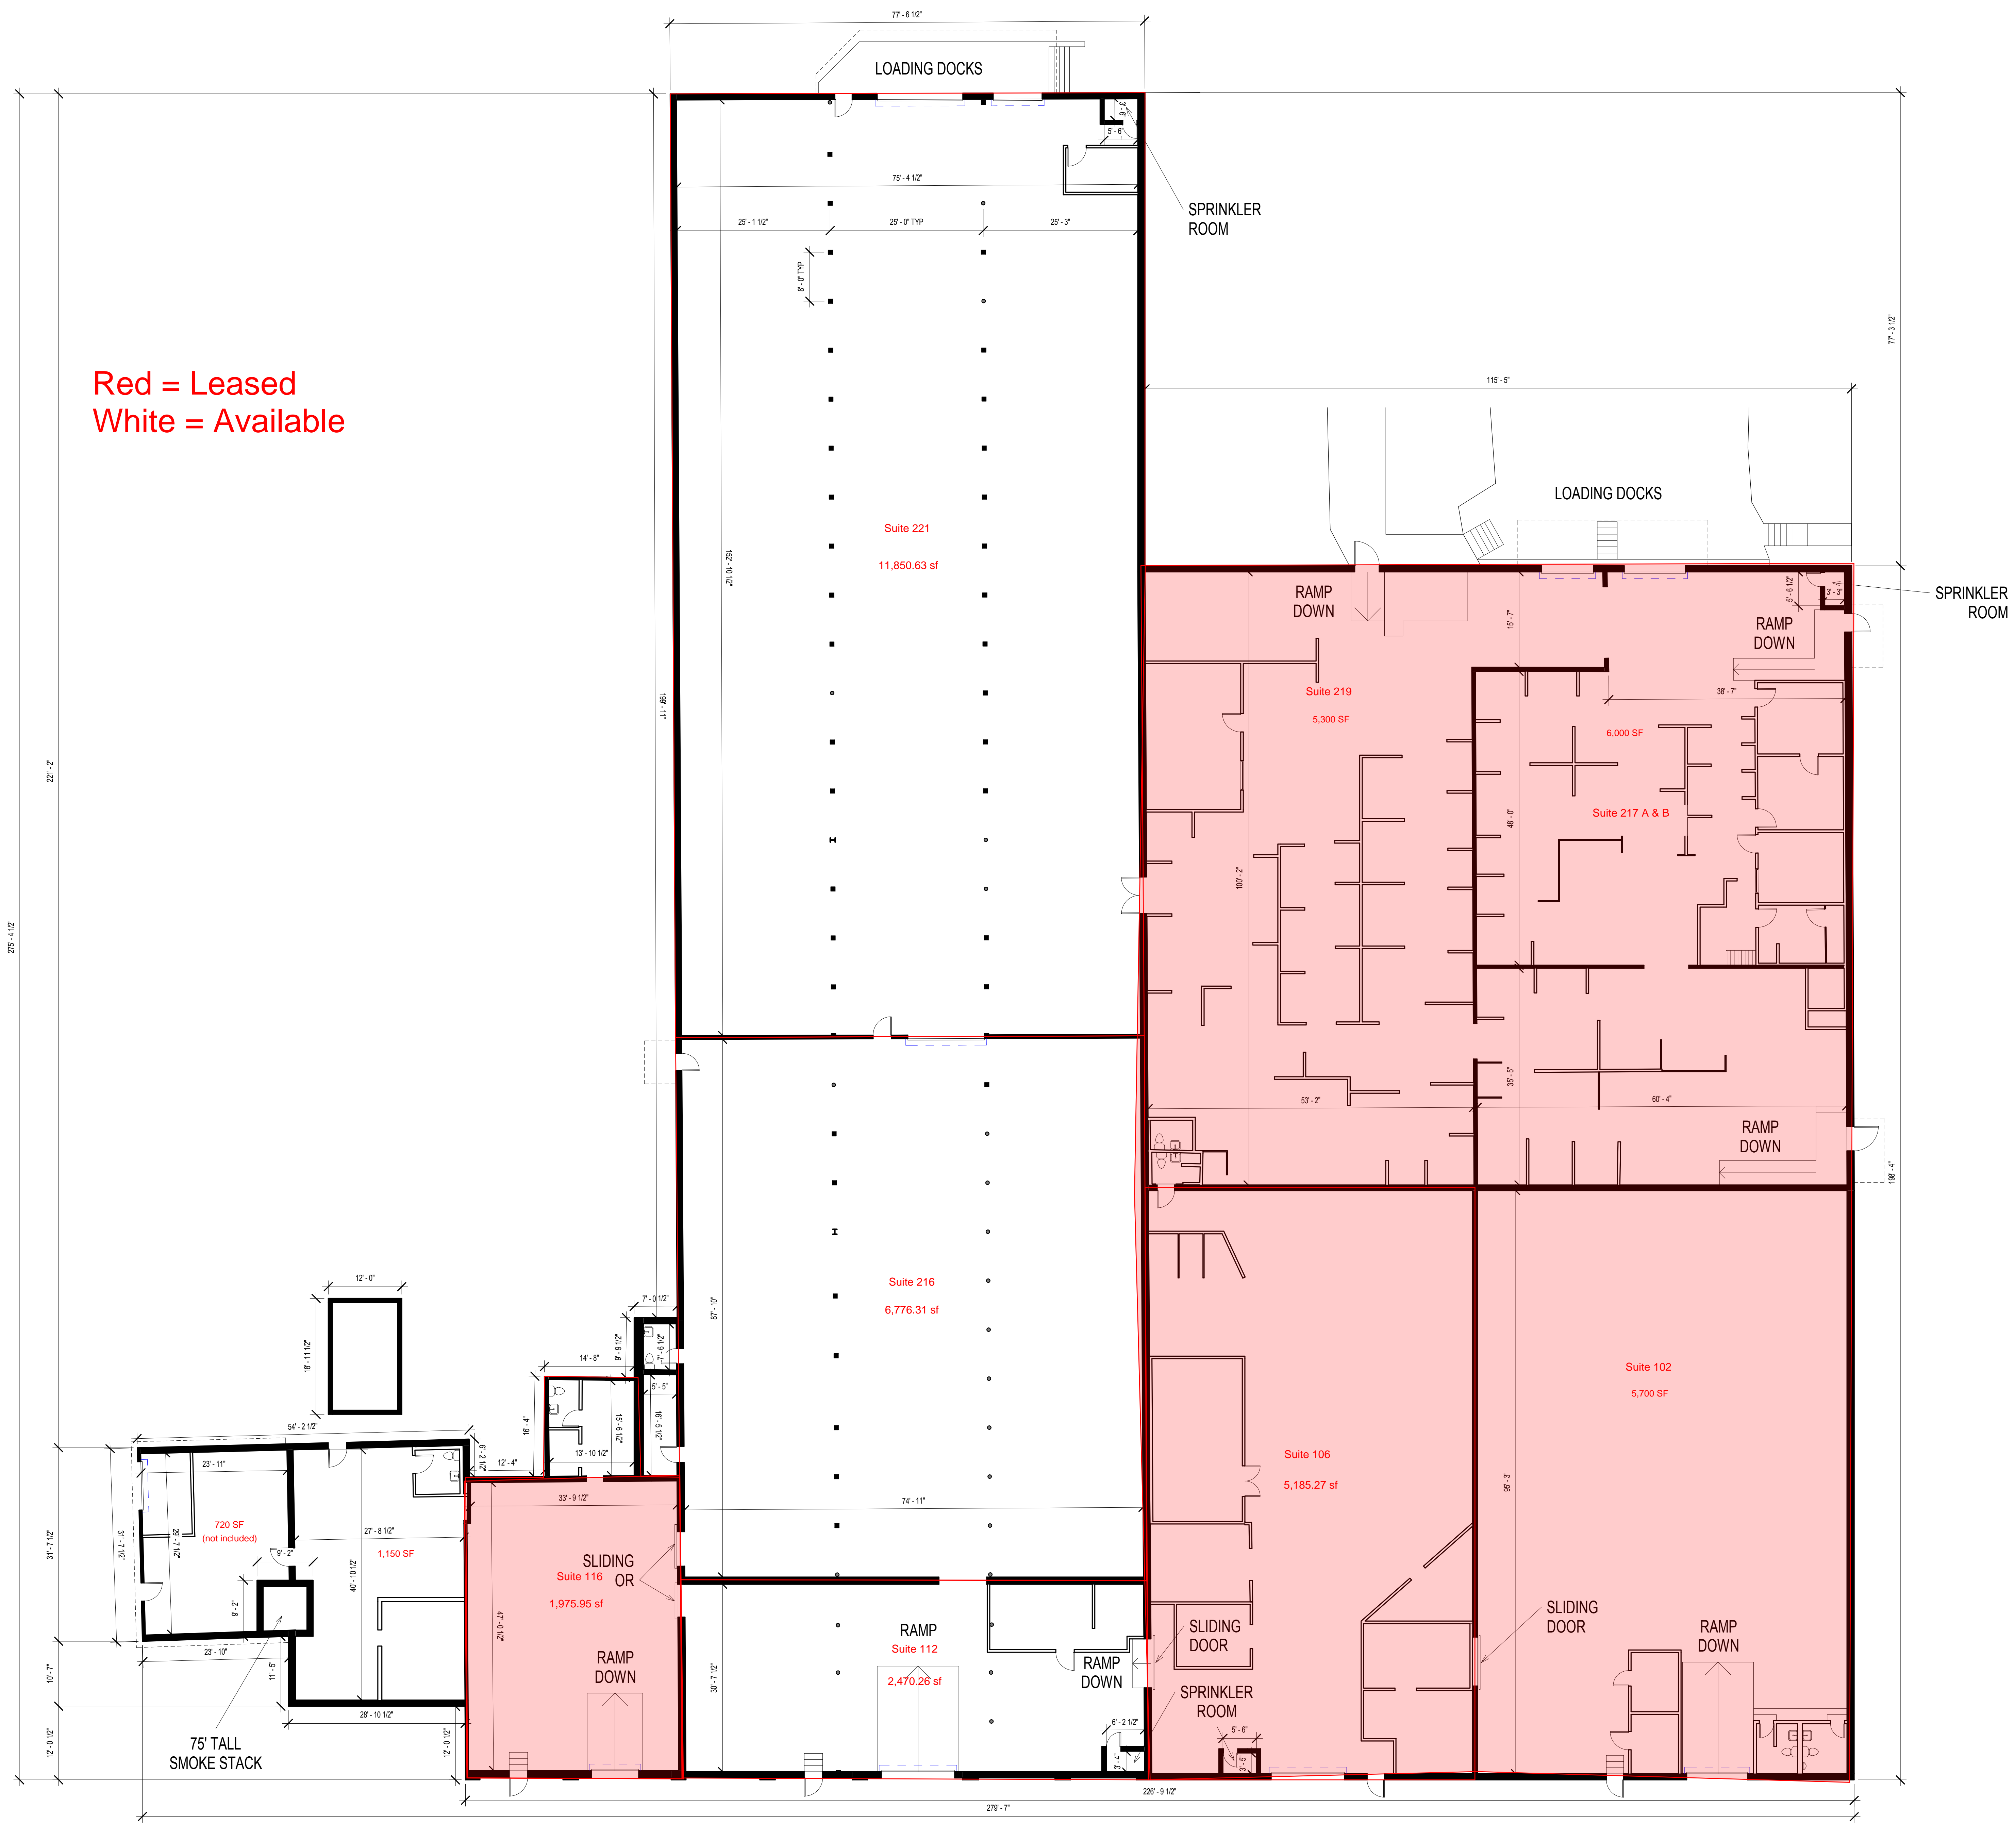

Red = Leased
White = Available

Red = Leased
White = Available

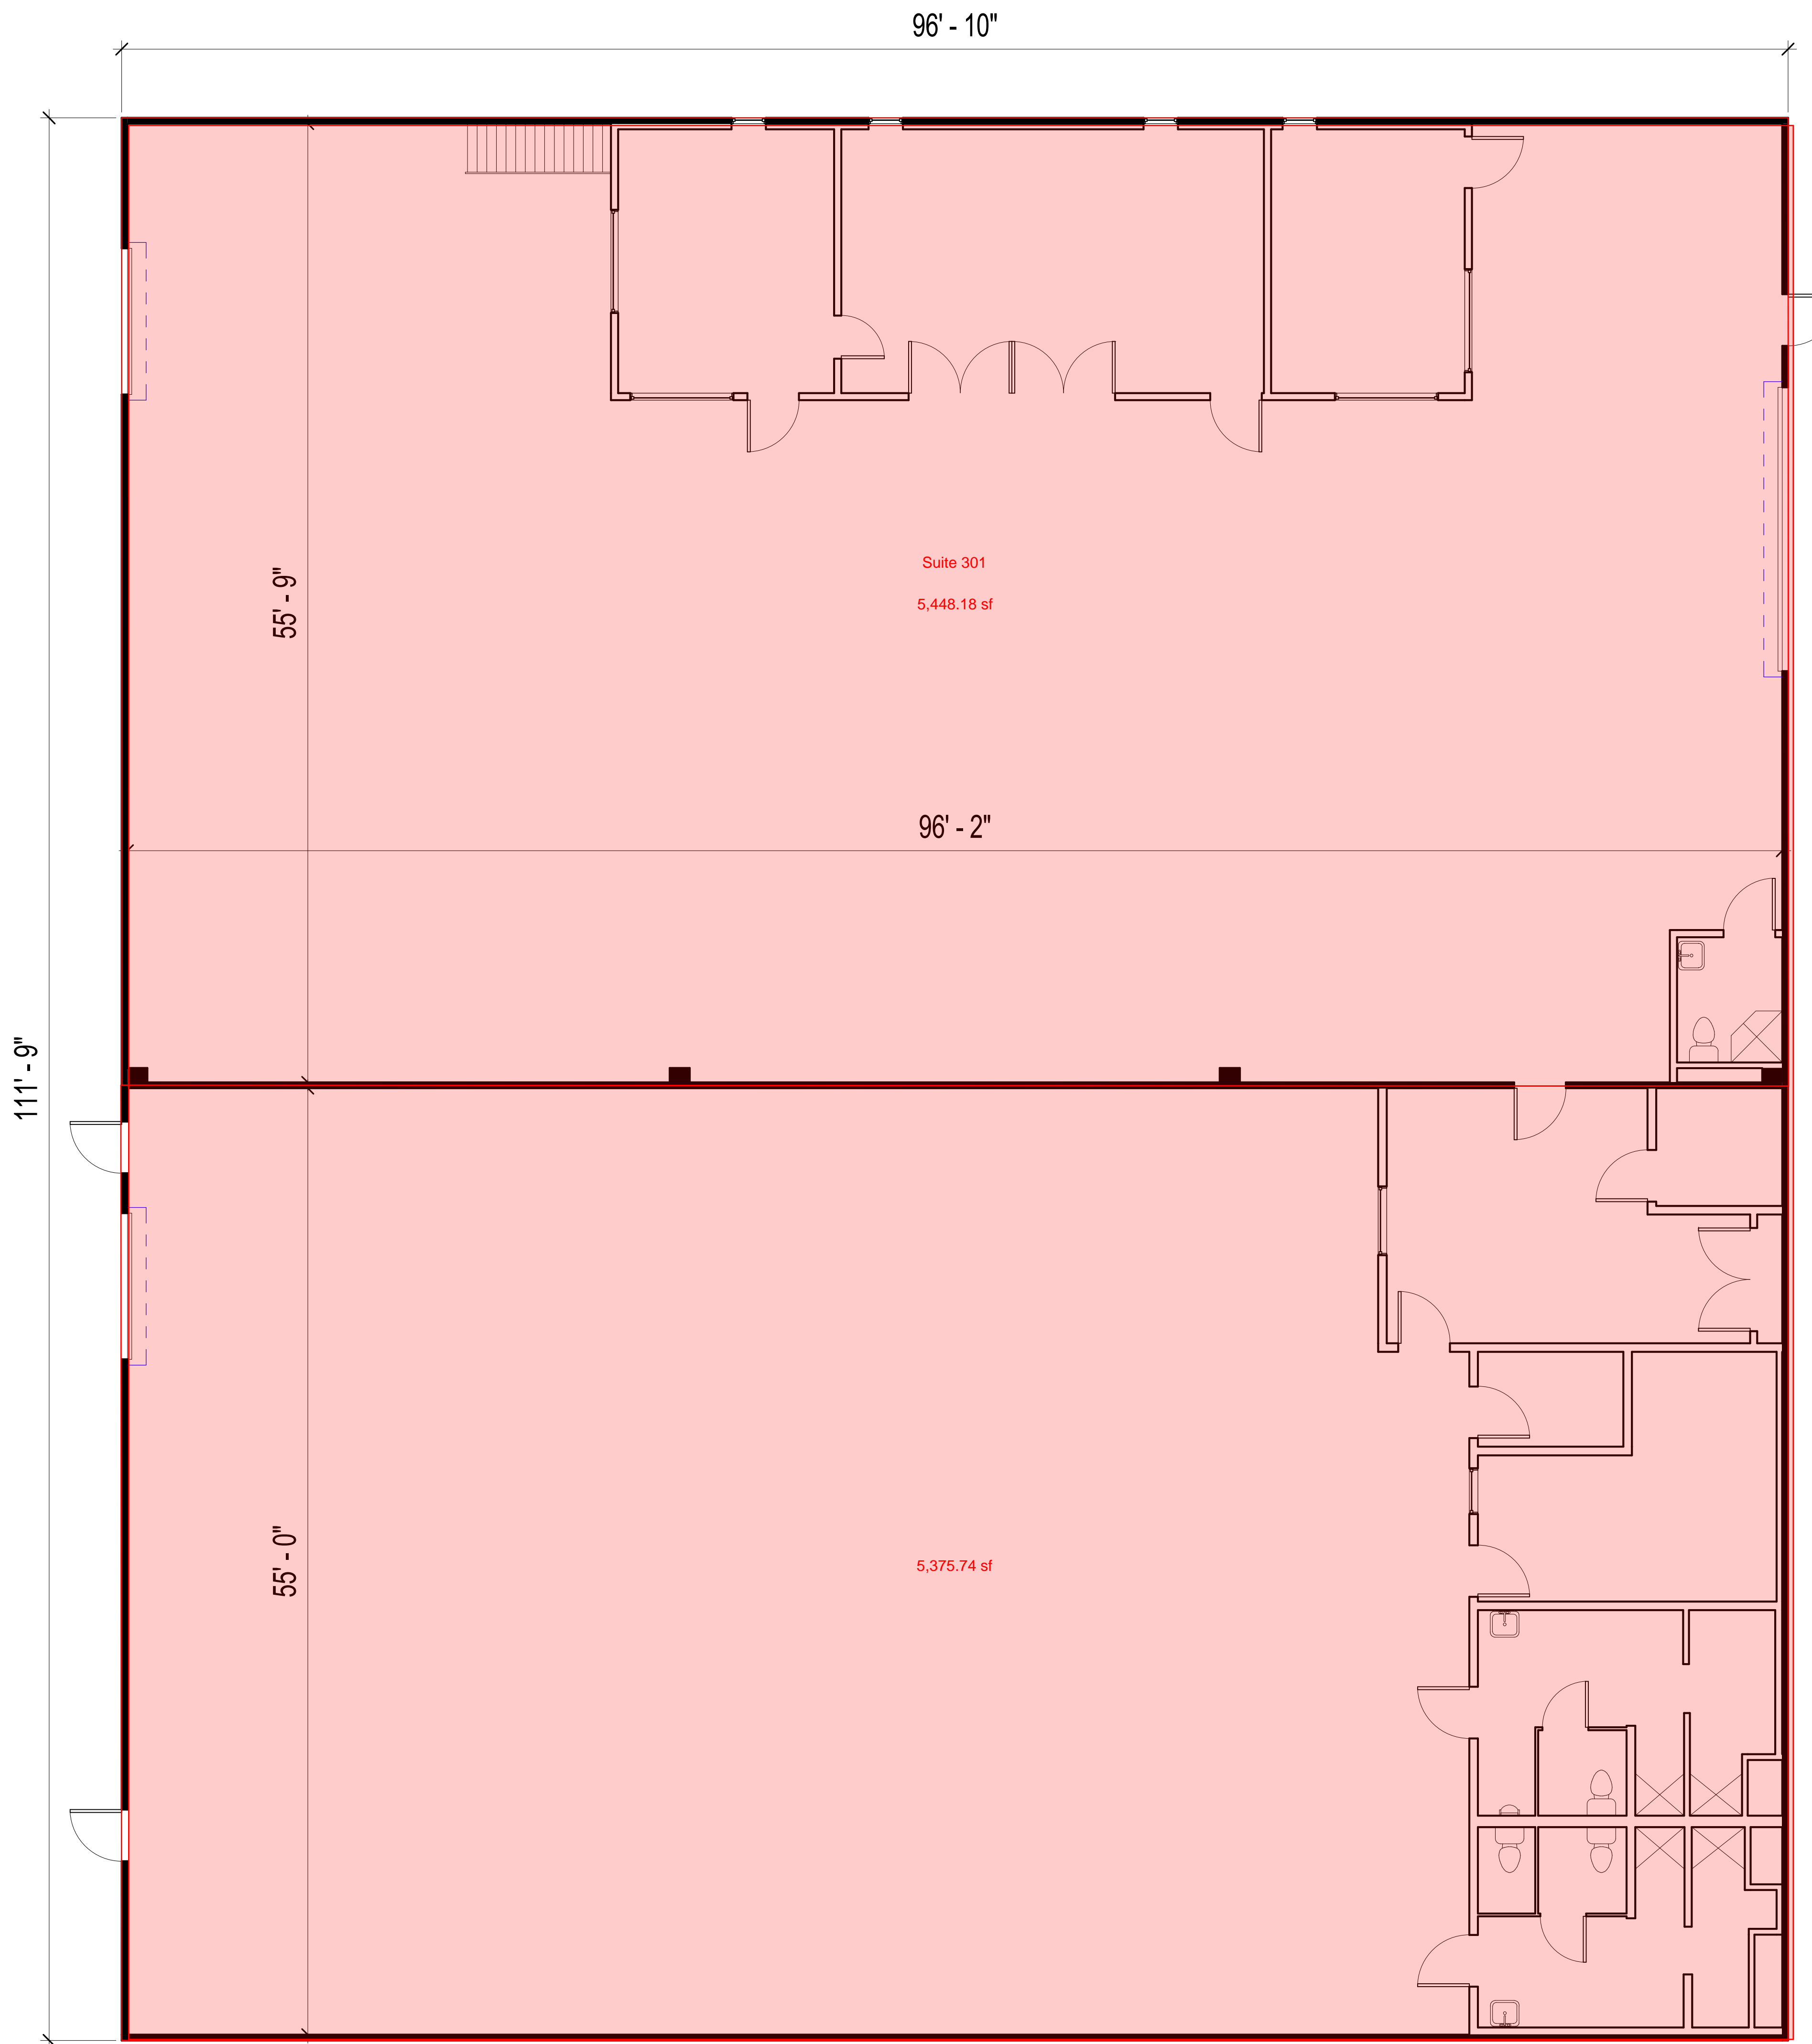

Disclaimer:
As-Built Drawn by BuildingPoint SouthEast
These drawings are not intended to represent in detail
the exact location, type of component nor manner of
construction. BuildingPoint SouthEast will not be
responsible for any errors or omissions which have
been incorporated into the record drawings.

DEPOT STREET TILT UP
BUILDING

301 & 305 DEPOT ST.
DAVIDSON, NC 28036

REVISIONS

No.	Date	Description



COPYRIGHT:
BUILDINGPOINT SOUTHEAST
PRINTING DATE: 5/13/2019
SCALE: 3/16" = 1'-0"

DRAWING NAME

MAIN LEVEL
FLOOR PLAN

DRAWING NUMBER

A100