



**PERIMETER**  
COMMERCIAL REAL ESTATE



**1668 MULKEY RD  
AUSTELL, GA, 30106**

*NORTHSIDE/ AUSTELL MOB*

*MEDICAL OFFICE SUITE*

*DENTAL OFFICE SUITE*

**OFFICE SUITES**

**100 - 3,184 SF**

**AVAILABLE**

**\$17 - \$36/SF**



**More Information: Leo Griffin**  
**(404)-793-1617 | [lgriffin@perimetercre.com](mailto:lgriffin@perimetercre.com)**






**PERIMETER**  
COMMERCIAL REAL ESTATE

1668 MULKEY RD



**More Information: Leo Griffin**  
(404)-793-1617 | [lgriffin@perimetercre.com](mailto:lgriffin@perimetercre.com)

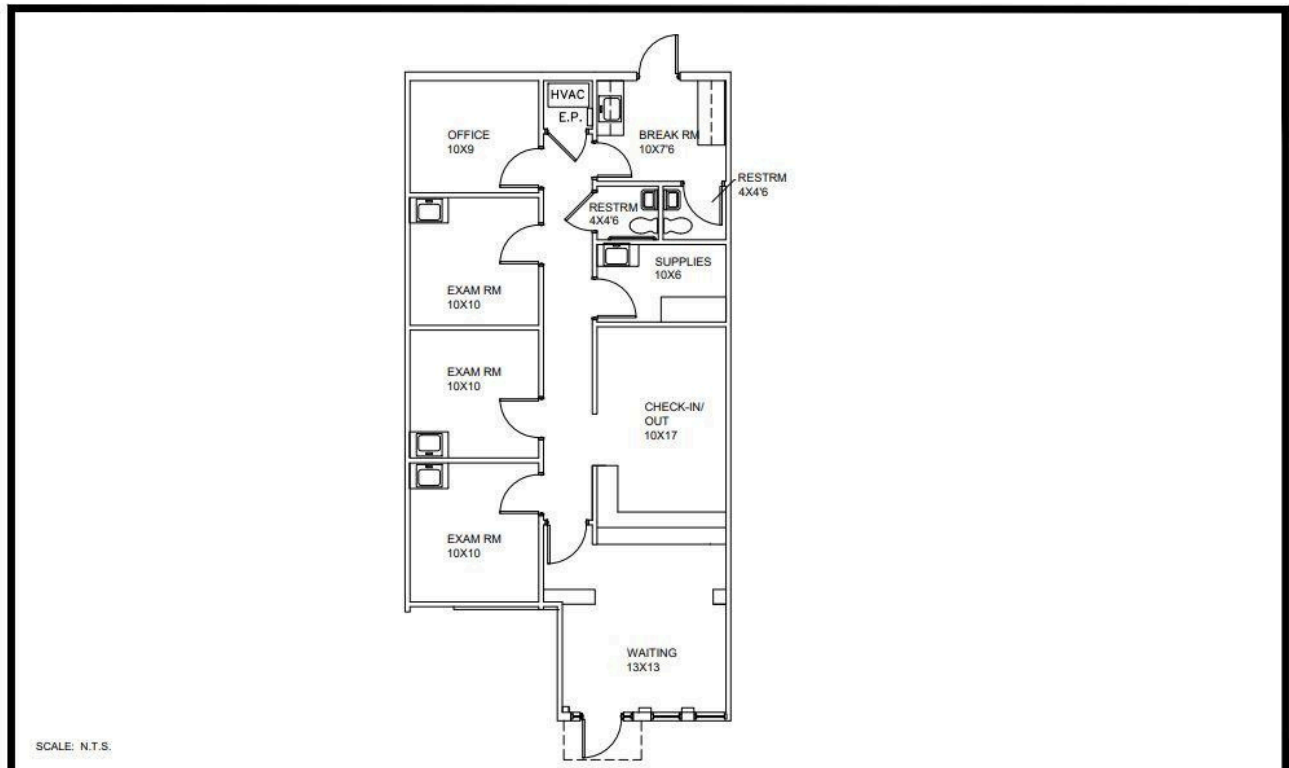


SCALE: N.T.S.

**AS-BUILT PLAN--SUITE G**  
**1,237 RSF**

**1668 MULKEY ROAD**  
**AUSTELL, GA 30106**

PLANS BY ADI, INC.

13 NOVEMBER 2023

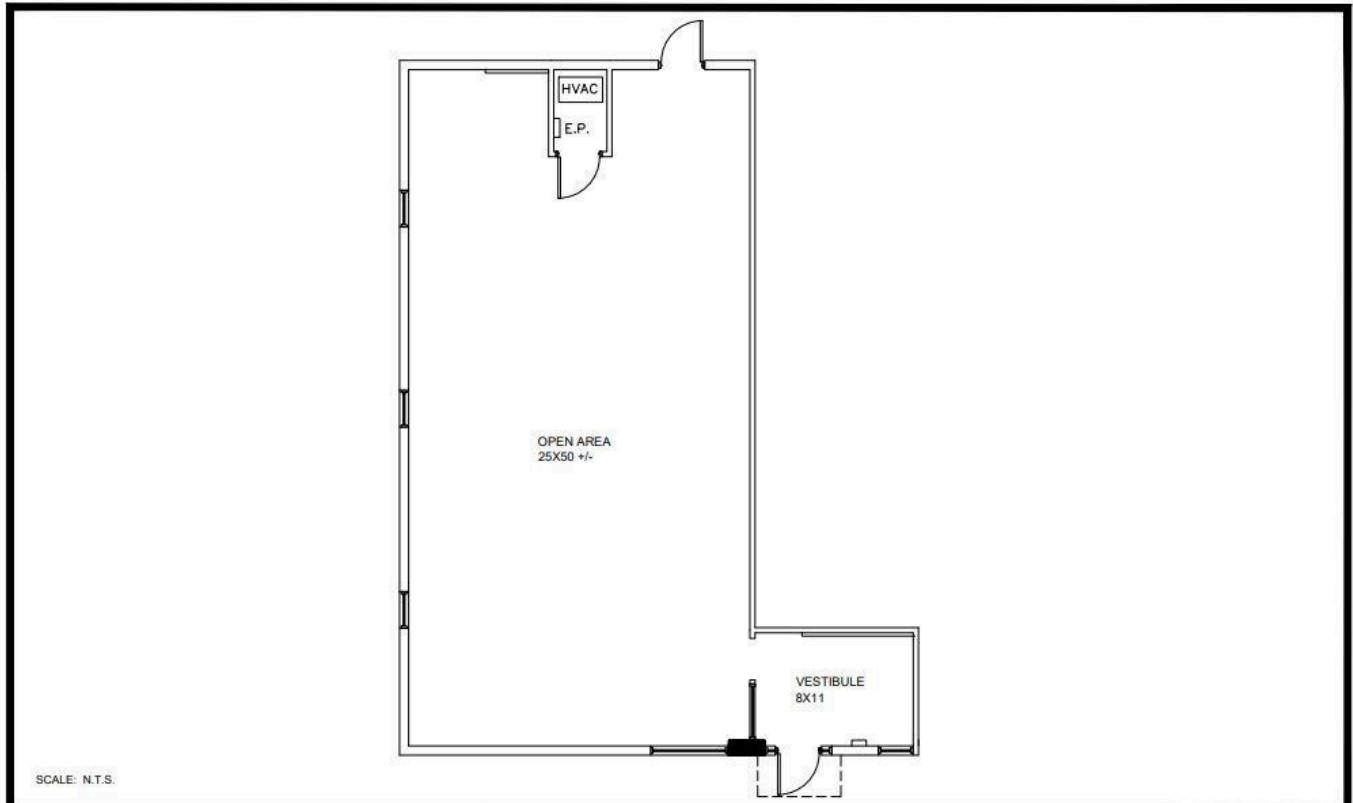

SCALE: N.T.S.

**AS-BUILT PLAN--SUITE H**  
**1,428 RSF**

**1668 MULKEY ROAD**  
**AUSTELL, GA 30106**

PLANS BY ADI, INC.

13 NOVEMBER 2023