


# 10043 Lincoln Highway

Frankfort, Illinois 60423

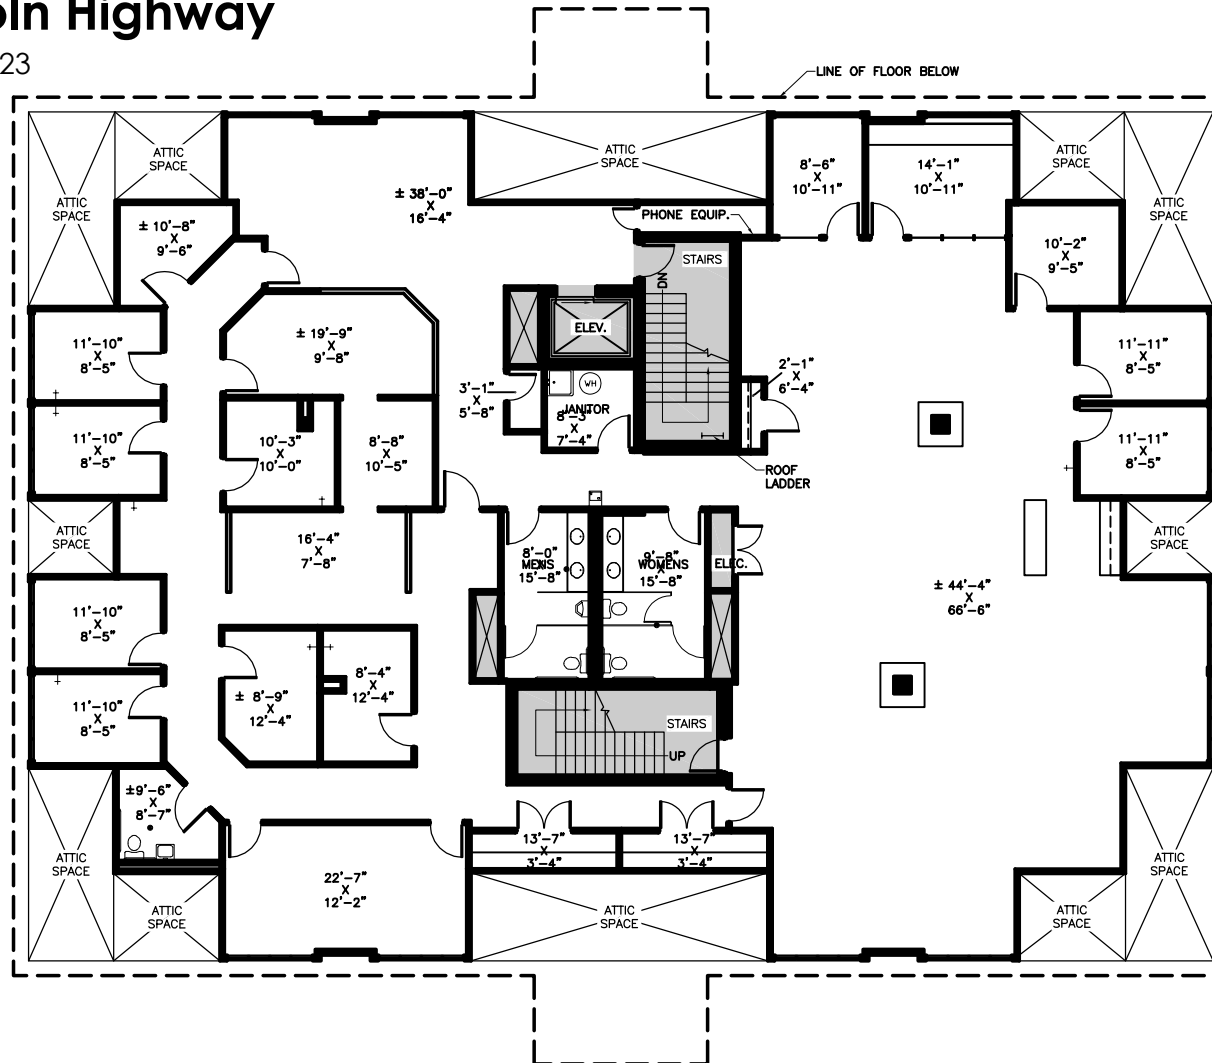

## Second Floor - As-Built Conditions

Second Floor: 6,790 Rentable Square Feet  
Total Building: 24,125 Rentable Square Feet

Scale:

N.T.S.

