


NOT FOR REGULATORY APPROVAL, PERMITTING, OR CONSTRUCTION

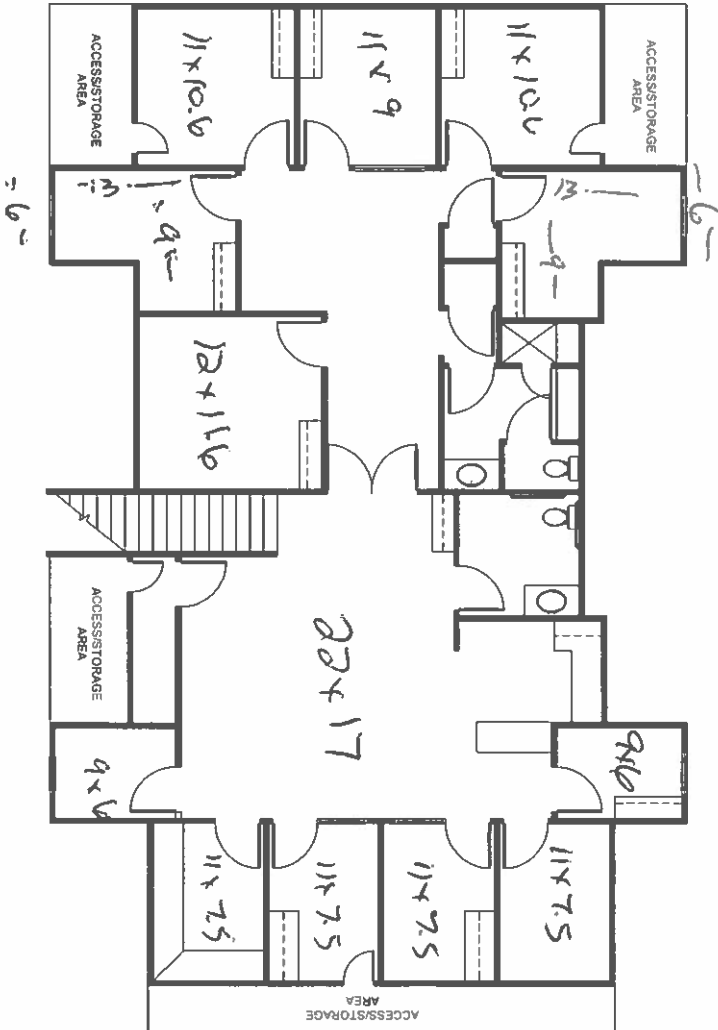

607 PARK GROVE 607 PARK GROVE KATY, TEXAS

Douglas • Pye 5120 WOODWAY DRIVE SUITE 4700 HOUSTON, TEXAS 77056 TEL: (713) 763.5000 FAX: (713) 763.8000 www.douglas-pye.com			
ISSUE	DATE	NO.	
AS-BUILT	09.03.15	1	

Legend New Existing Demolish Partitions Electrical Telephone Notes: This plan is for informational purposes only. It is not to be used for construction. All dimensions are in feet and inches. All areas are to be finished to match existing conditions. All areas are to be finished to match existing conditions. All areas are to be finished to match existing conditions.	
PROJECT LOCATION	607 PARK GROVE
PROJECT OWNER	KATY, TEXAS
DESIGNER	SCHEMATIC DESIGN
DATE	09.03.15
PROJECT NO.	1501.56